60-60

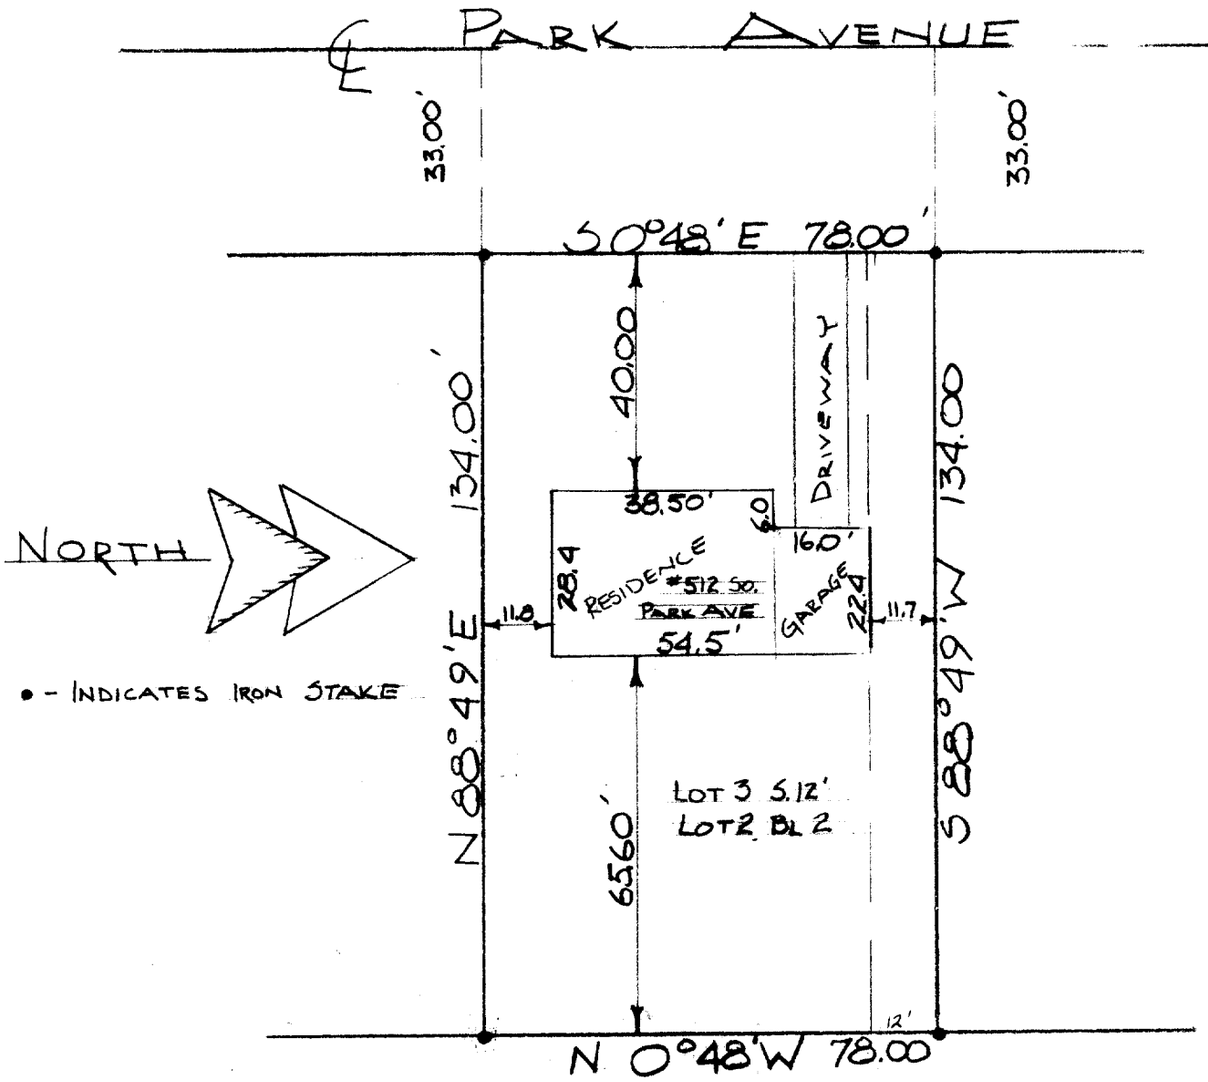

DESCRIPTION: The South 12.00 feet of Lot 2, and all of Lot 3, in Block 2 of the South Park Subdivision, located in the SW ¼ of the SW ¼ of Section 17 and in the NE ¼ of the NW ¼ of Section 20, Town 2 North, Range 16 East, Walworth County, Wisconsin.

CERTIFICATE: I, James F. Biagi, surveyor, do hereby certify that I have surveyed the property hereon described, and that the location of all the improvements are as shown on the above drawing.

August 20, 1960

James F. Biagi

James F. Biagi RLS 272

λ SOP-11

2-46 B