RECEIVED
AUG 1986

DUNHAM SURVEYING, S.C.

SURVEYING & SUBDIVIDING
DELAVAN, WISCONSIN 53115

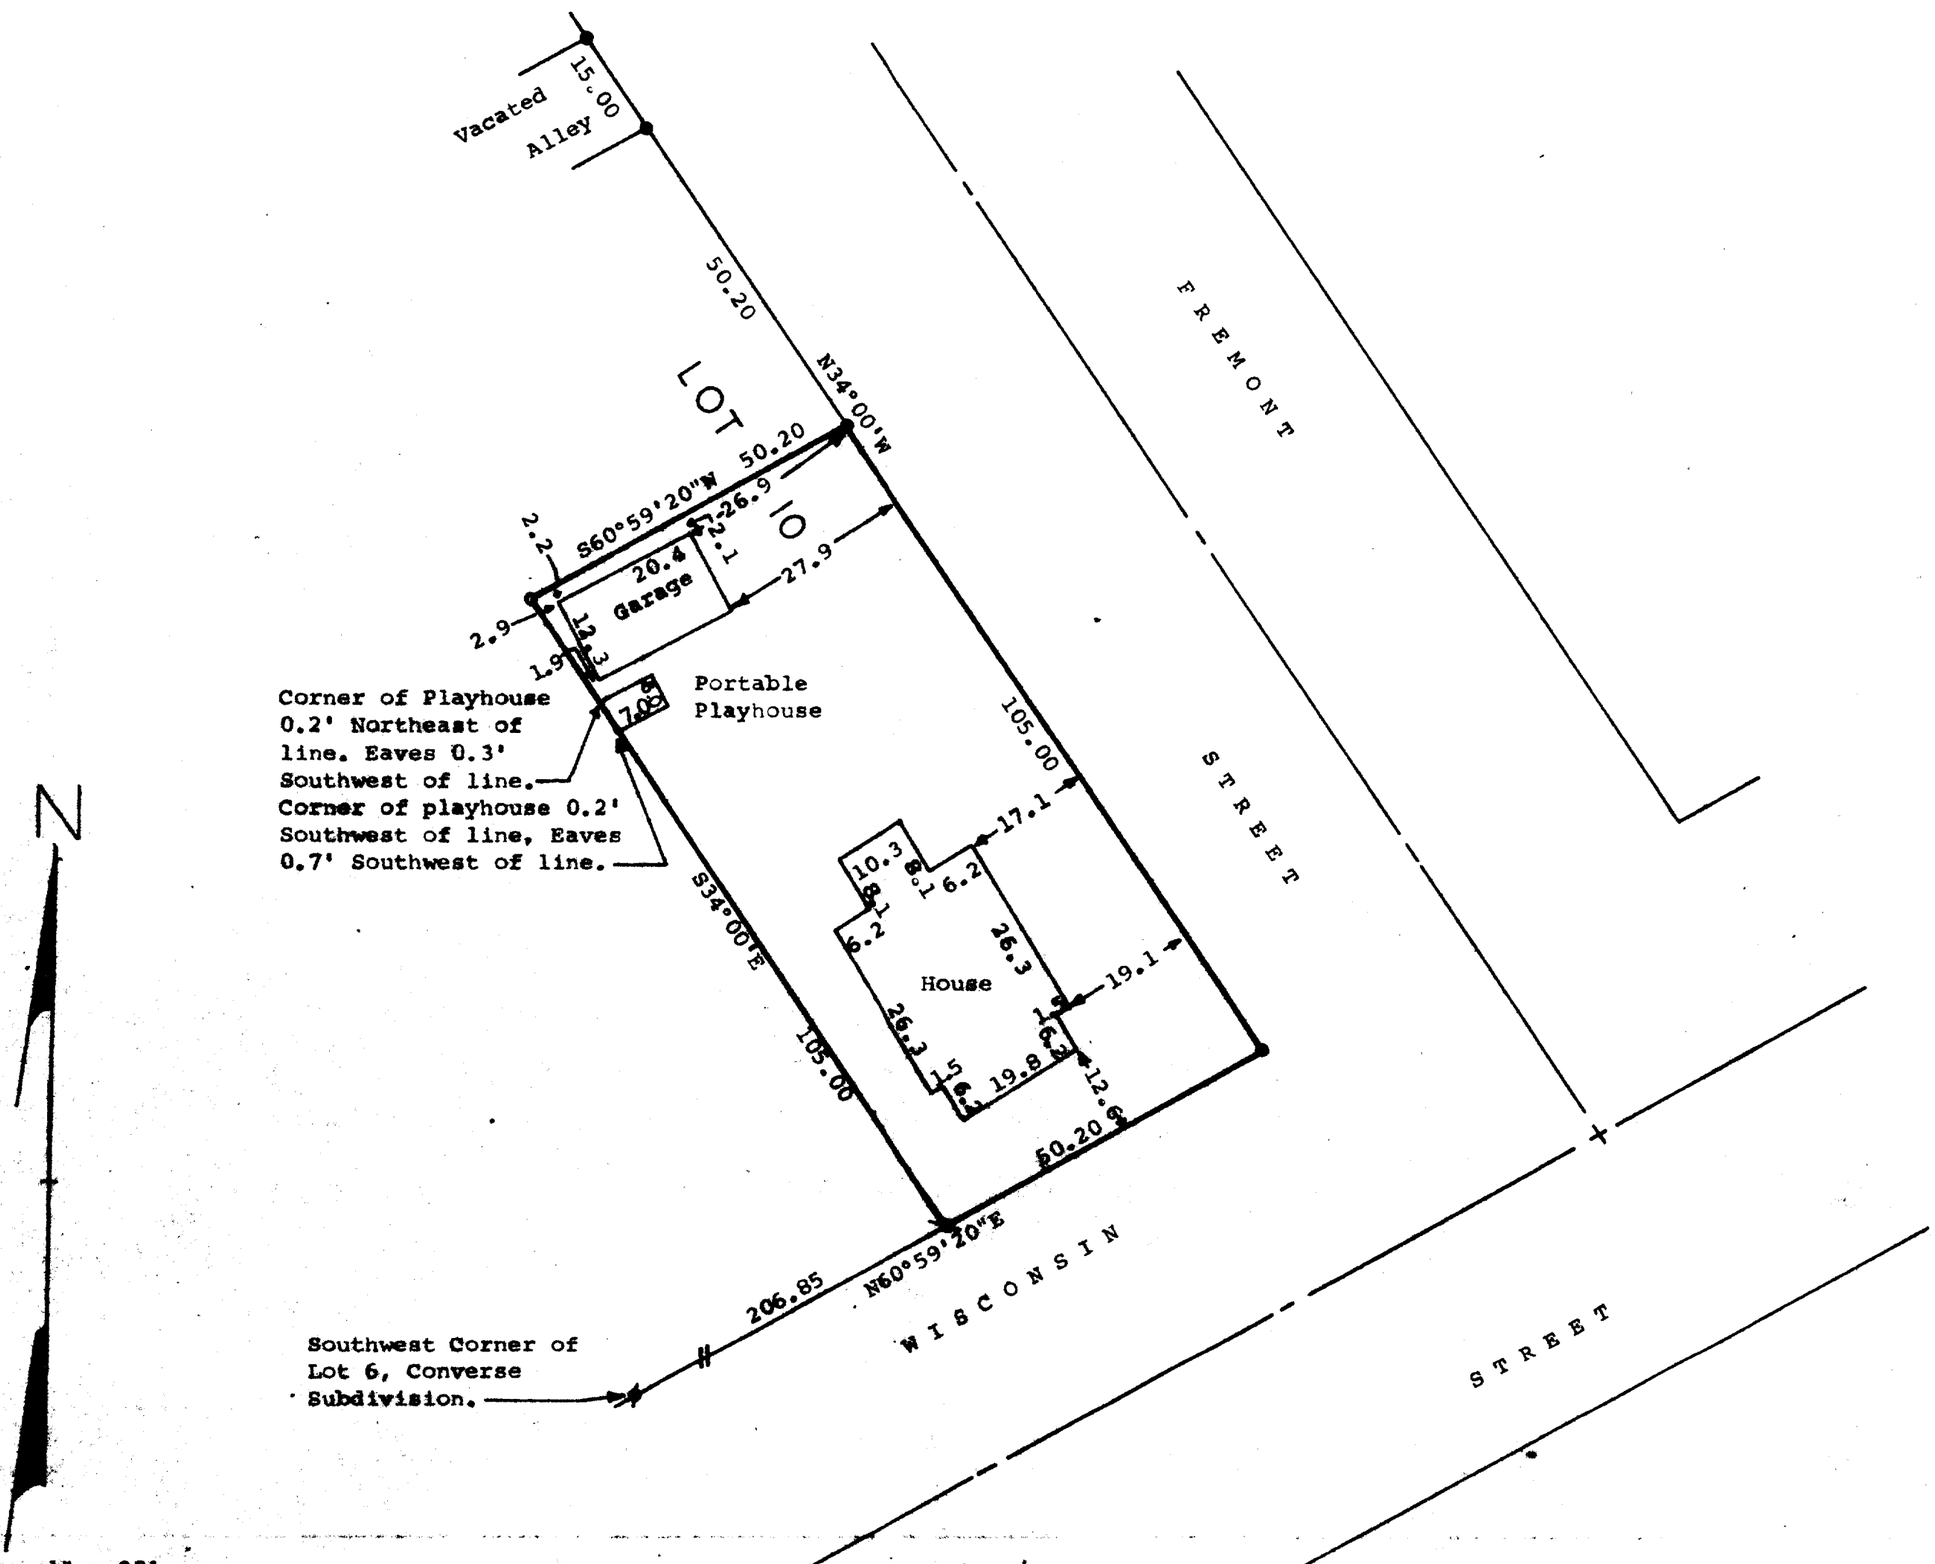

Scale - 1" = 20'
o = 3/4"x24" Iron Pipe Set
● = Concrete Monument Found
⊙ = 1" Dia. Iron Pipe found down 1' and reset to ground surface.
ϕ = 1¼" Dia. Sash Weight

Bearings are referenced to the Southwesterly line of Fremont Street with an assumed bearing of N34°00'W.

Survey Ordered By:
Keefe Real Estate, Inc.
Better Homes and Gardens
302 East Walworth Avenue
Delavan, Wisconsin 53115

STATE OF WISCONSIN)
COUNTY OF WALWORTH) SS

I, Richard C. Schulz, Surveyor, certify that I have surveyed the property described as follows,

The Southeasterly 105 feet of Lot 10, Block 5 of Converse Subdivision, an addition to the City of Delavan, Walworth County, Wisconsin,

and that the plat shown above is a true representation thereof and shows the size and location of the property, its exterior boundaries, the location of boundary fences, apparent easements, roadways and visible encroachments, if any, and that I have surveyed the property hereon described according to the official records to the best of my knowledge and belief.

June 24, 1986.

Richard C. Schulz

Richard C. Schulz, Surveyor

WISCONSIN
RICHARD C. SCHULZ
S-1671
DELAVAN
WI
LAND SURVEYOR

FS-46

2-712-D