PLAT OF SURVEY
of
Lot 3 of South Park Subdivision, located in the Southwest $\frac{1}{4}$ of Section 17, T2N, R16E, Walworth County, Wisconsin,

Surveyed for: David Hart
504 Park Ave.
Delavan, WI. 53115

RECEIVED
OCT 4 1986

Jensen Surveying & Mapping S.C.
45 S. Wisconsin St. P.O. Box 322
Elkhorn, Wisconsin. 53121
(414) 723-3434

Note: This survey plat is not certified unless signed and sealed in red ink.

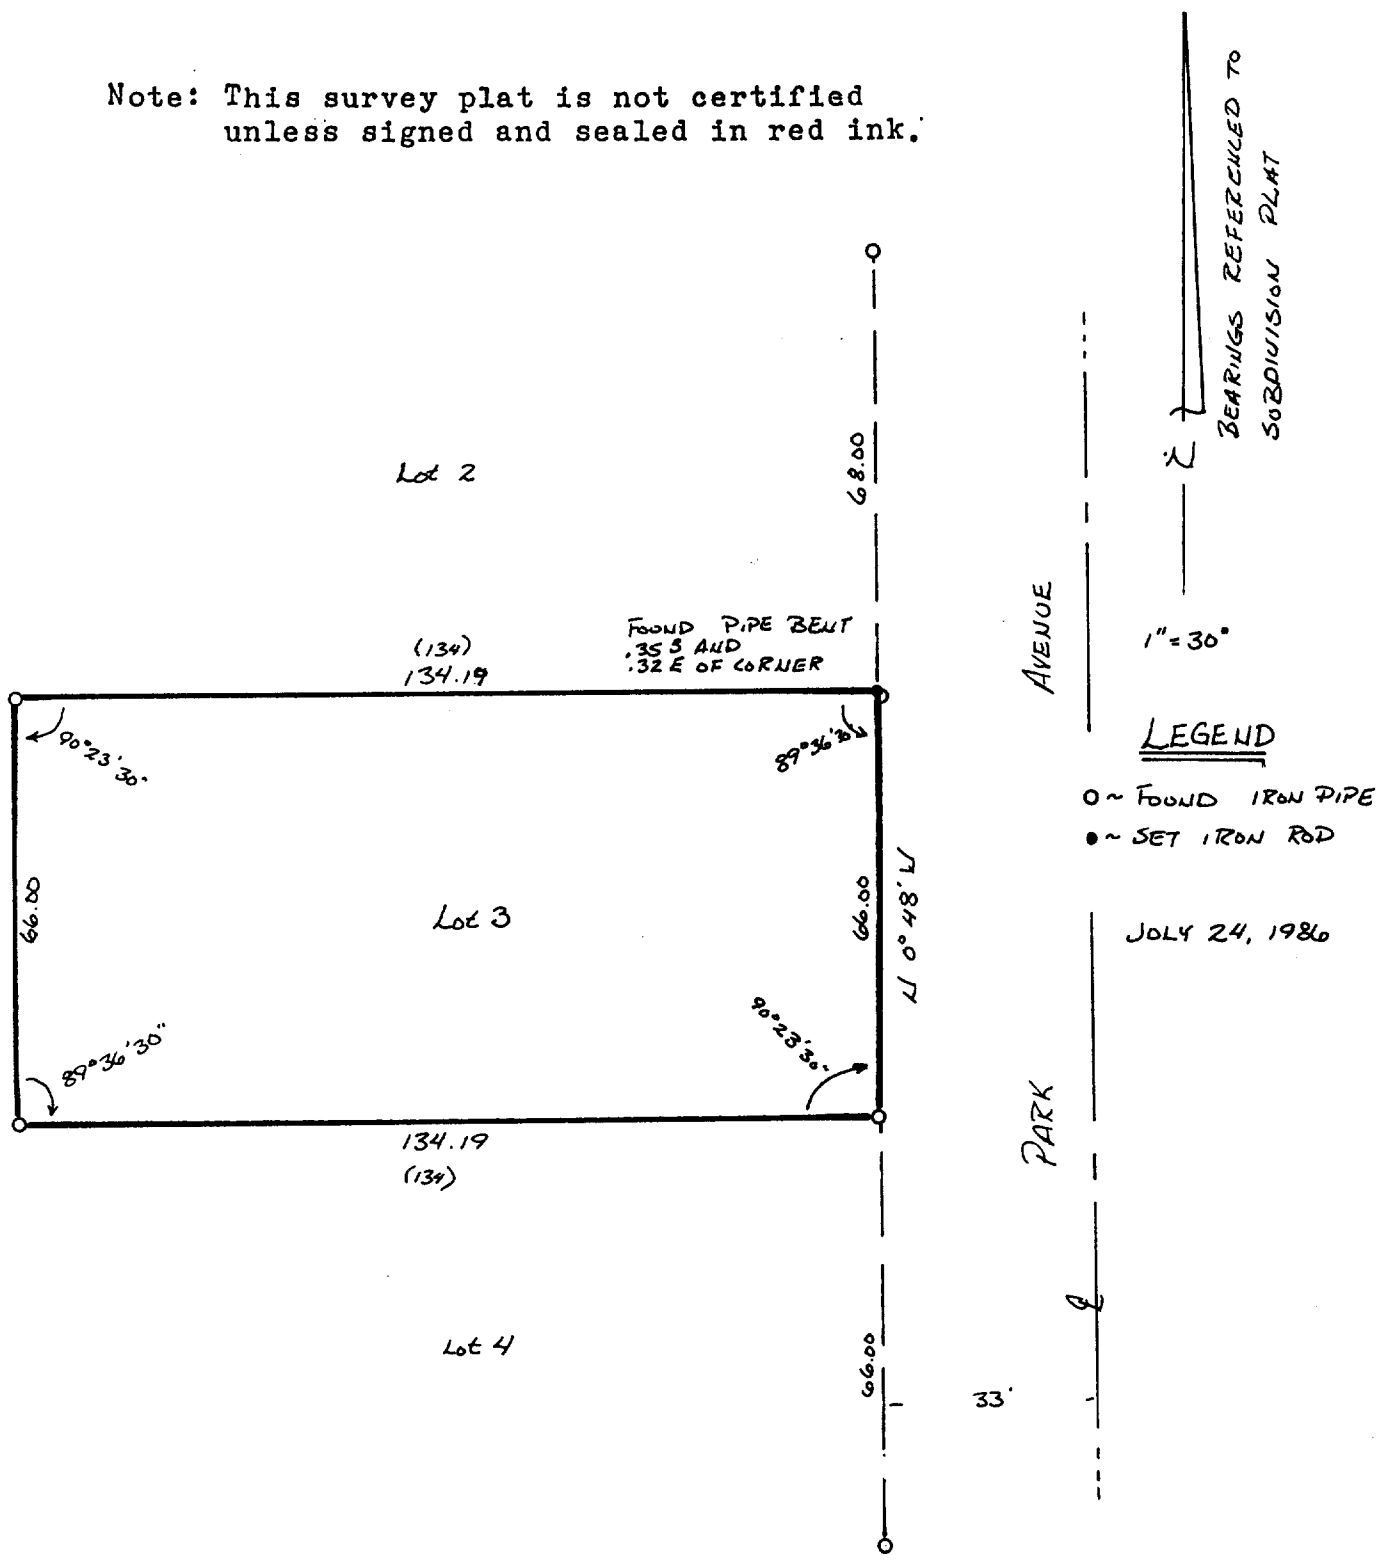

I, Thomas P.A. Jensen, Wisconsin Registered Land Surveyor, do hereby certify that this survey was performed by me, or under my direction, in full compliance with the owner's/agent's instructions and chapter A-E 5 of the Wisconsin Administrative Code "Minimum Standards For Property Surveys"; and that this map is an accurate representation thereof to the best of my knowledge and belief.

Thomas P.A. Jensen S-1084
Jensen Surveying & Mapping S.C.

1986.077 X

2-730