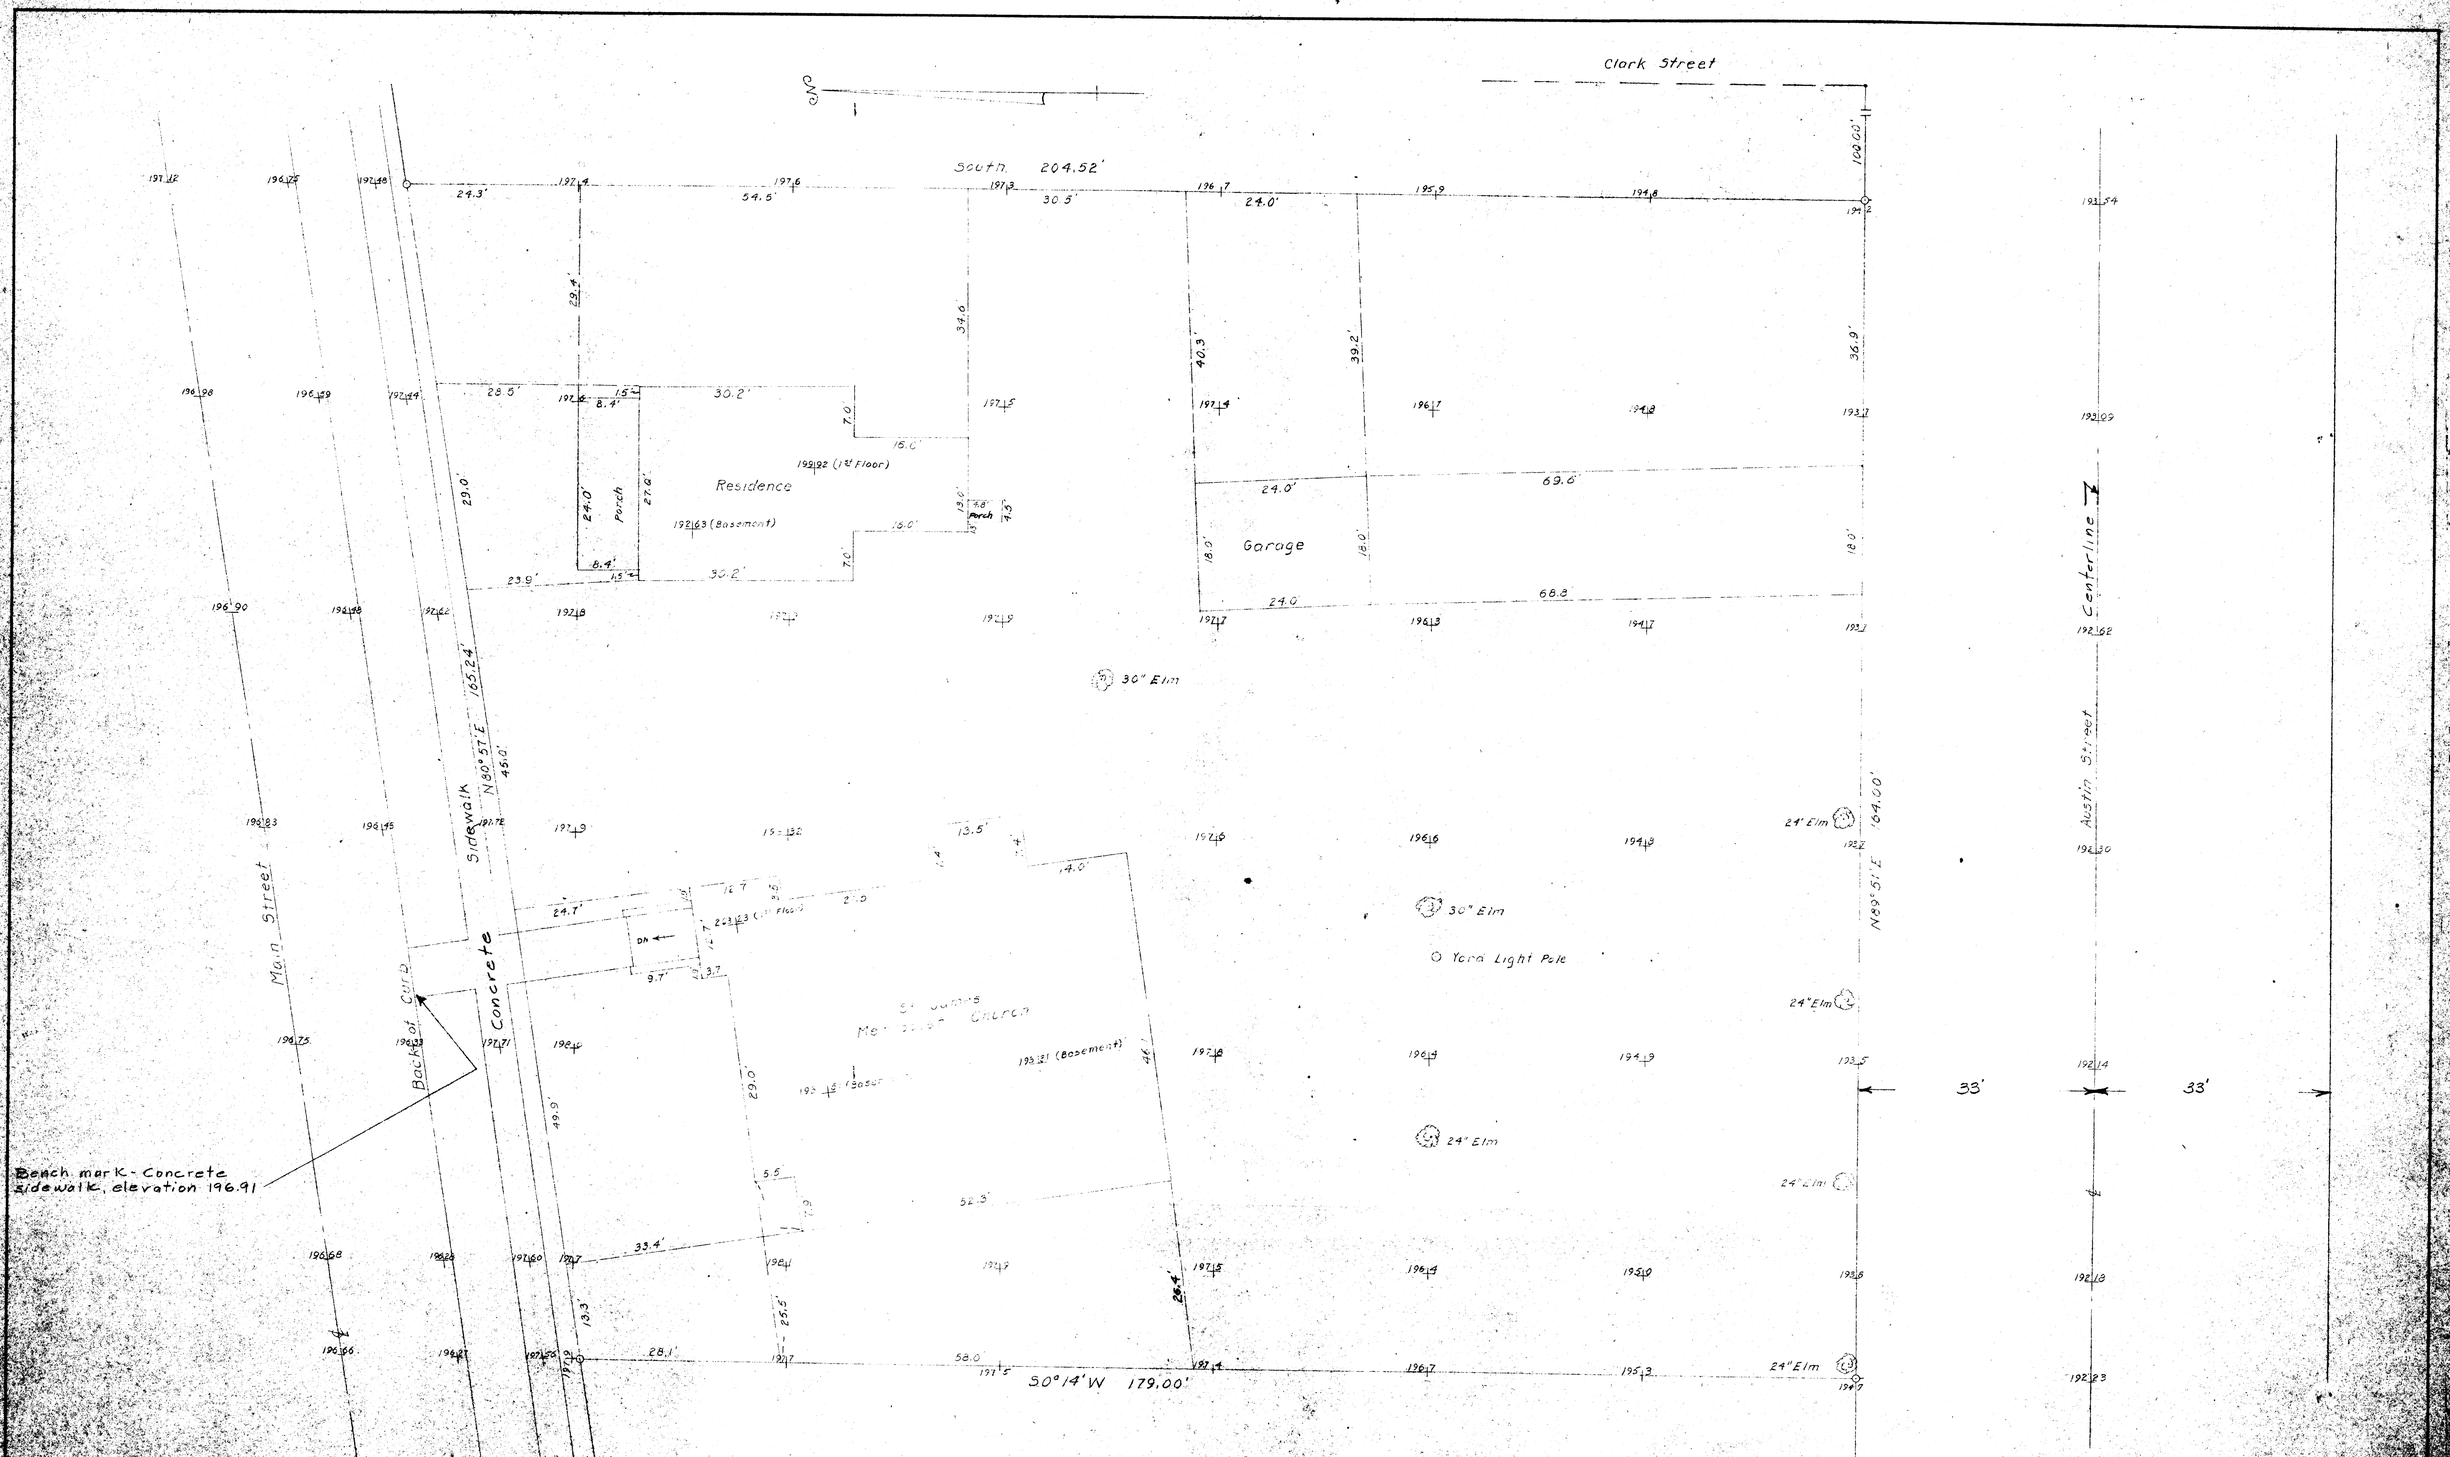

Plat of Survey of Part of Lot 1, Block 4 located in the NE¼ of Section 30, T4N, R18E, Village of East Troy, Walworth County, Wisconsin

DRAWN BY: HHolb	JENSEN & JOHNSON	
CHECKED BY:	CIVIL ENGINEERS	
APPROVED BY:	ELKHORN, WIS.	
	DATE: March, 1964	