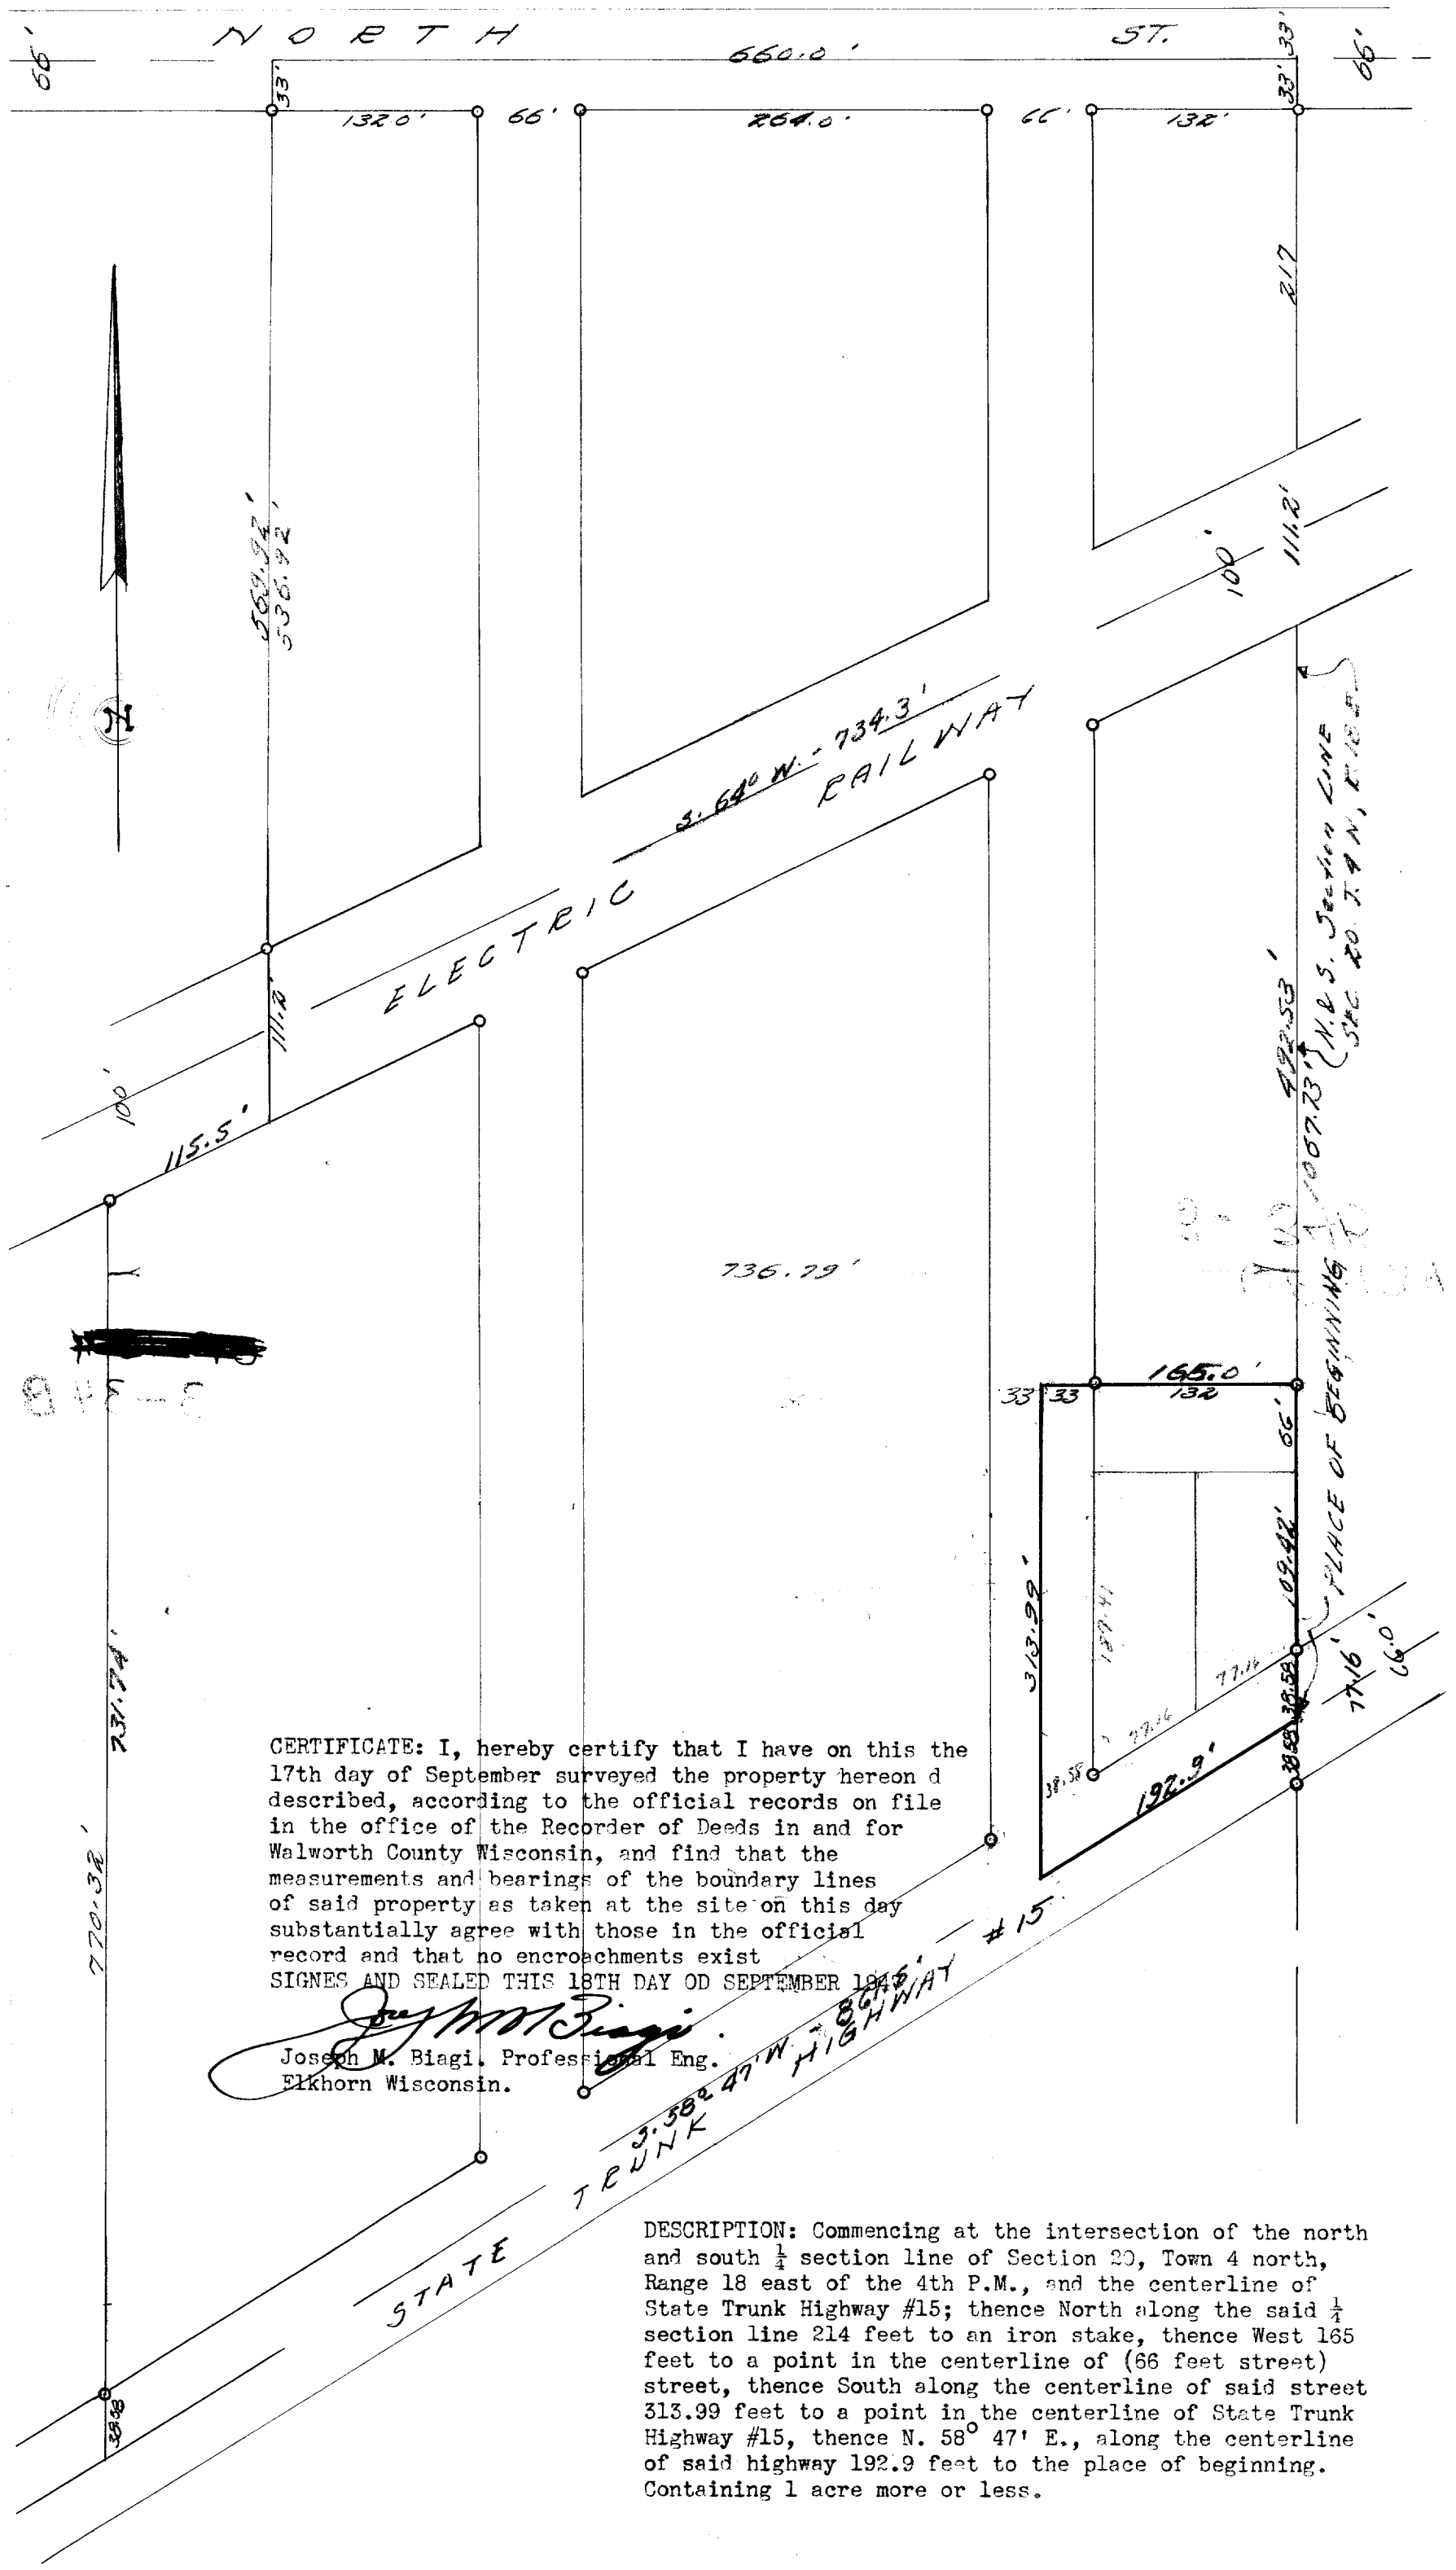

CERTIFICATE: I, hereby certify that I have on this the 17th day of September surveyed the property hereon d described, according to the official records on file in the office of the Recorder of Deeds in and for Walworth County Wisconsin, and find that the measurements and bearings of the boundary lines of said property as taken at the site on this day substantially agree with those in the official record and that no encroachments exist
SIGNES AND SEALED THIS 18TH DAY OD SEPTEMBER 1945

Joseph M. Biagi. Professional Eng.
Elkhorn Wisconsin.

DESCRIPTION: Commencing at the intersection of the north and south ¼ section line of Section 20, Town 4 north, Range 18 east of the 4th P.M., and the centerline of State Trunk Highway #15; thence North along the said ¼ section line 214 feet to an iron stake, thence West 165 feet to a point in the centerline of (66 feet street) street, thence South along the centerline of said street 313.99 feet to a point in the centerline of State Trunk Highway #15, thence N. 58° 47' E., along the centerline of said highway 192.9 feet to the place of beginning. Containing 1 acre more or less.

UP-134

3-34 B