


DETAILED TOPOGRAPHIC MAPPING

LOTS 1 THRU 4 + 19 THRU 22 OF
BLOCK A OF LENCKS PARK
ADDITION, LOCATED IN THE
VILLAGE OF EAST TROY
WALWORTH COUNTY, WISCONSIN

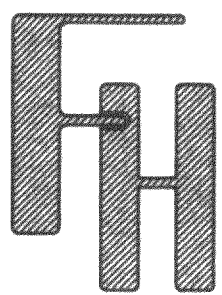


WORK ORDERED BY
THE VILLAGE OF EAST TROY
CONTACT: KEN WITT
VILLAGE OF EAST TROY
WISCONSIN

FARRIS, HANSEN & ASSOCIATES, INC.
Engineering, Architecture, Surveying
7 Ridgway Court P.O. Box 437
Elkhorn, Wisconsin 53121
Office: (414) 723-2098
Fax: (414) 723-5886

REVISIONS

PROJECT NO.
5011
DATE
06/09/98
SHEET NO.
1 OF 1

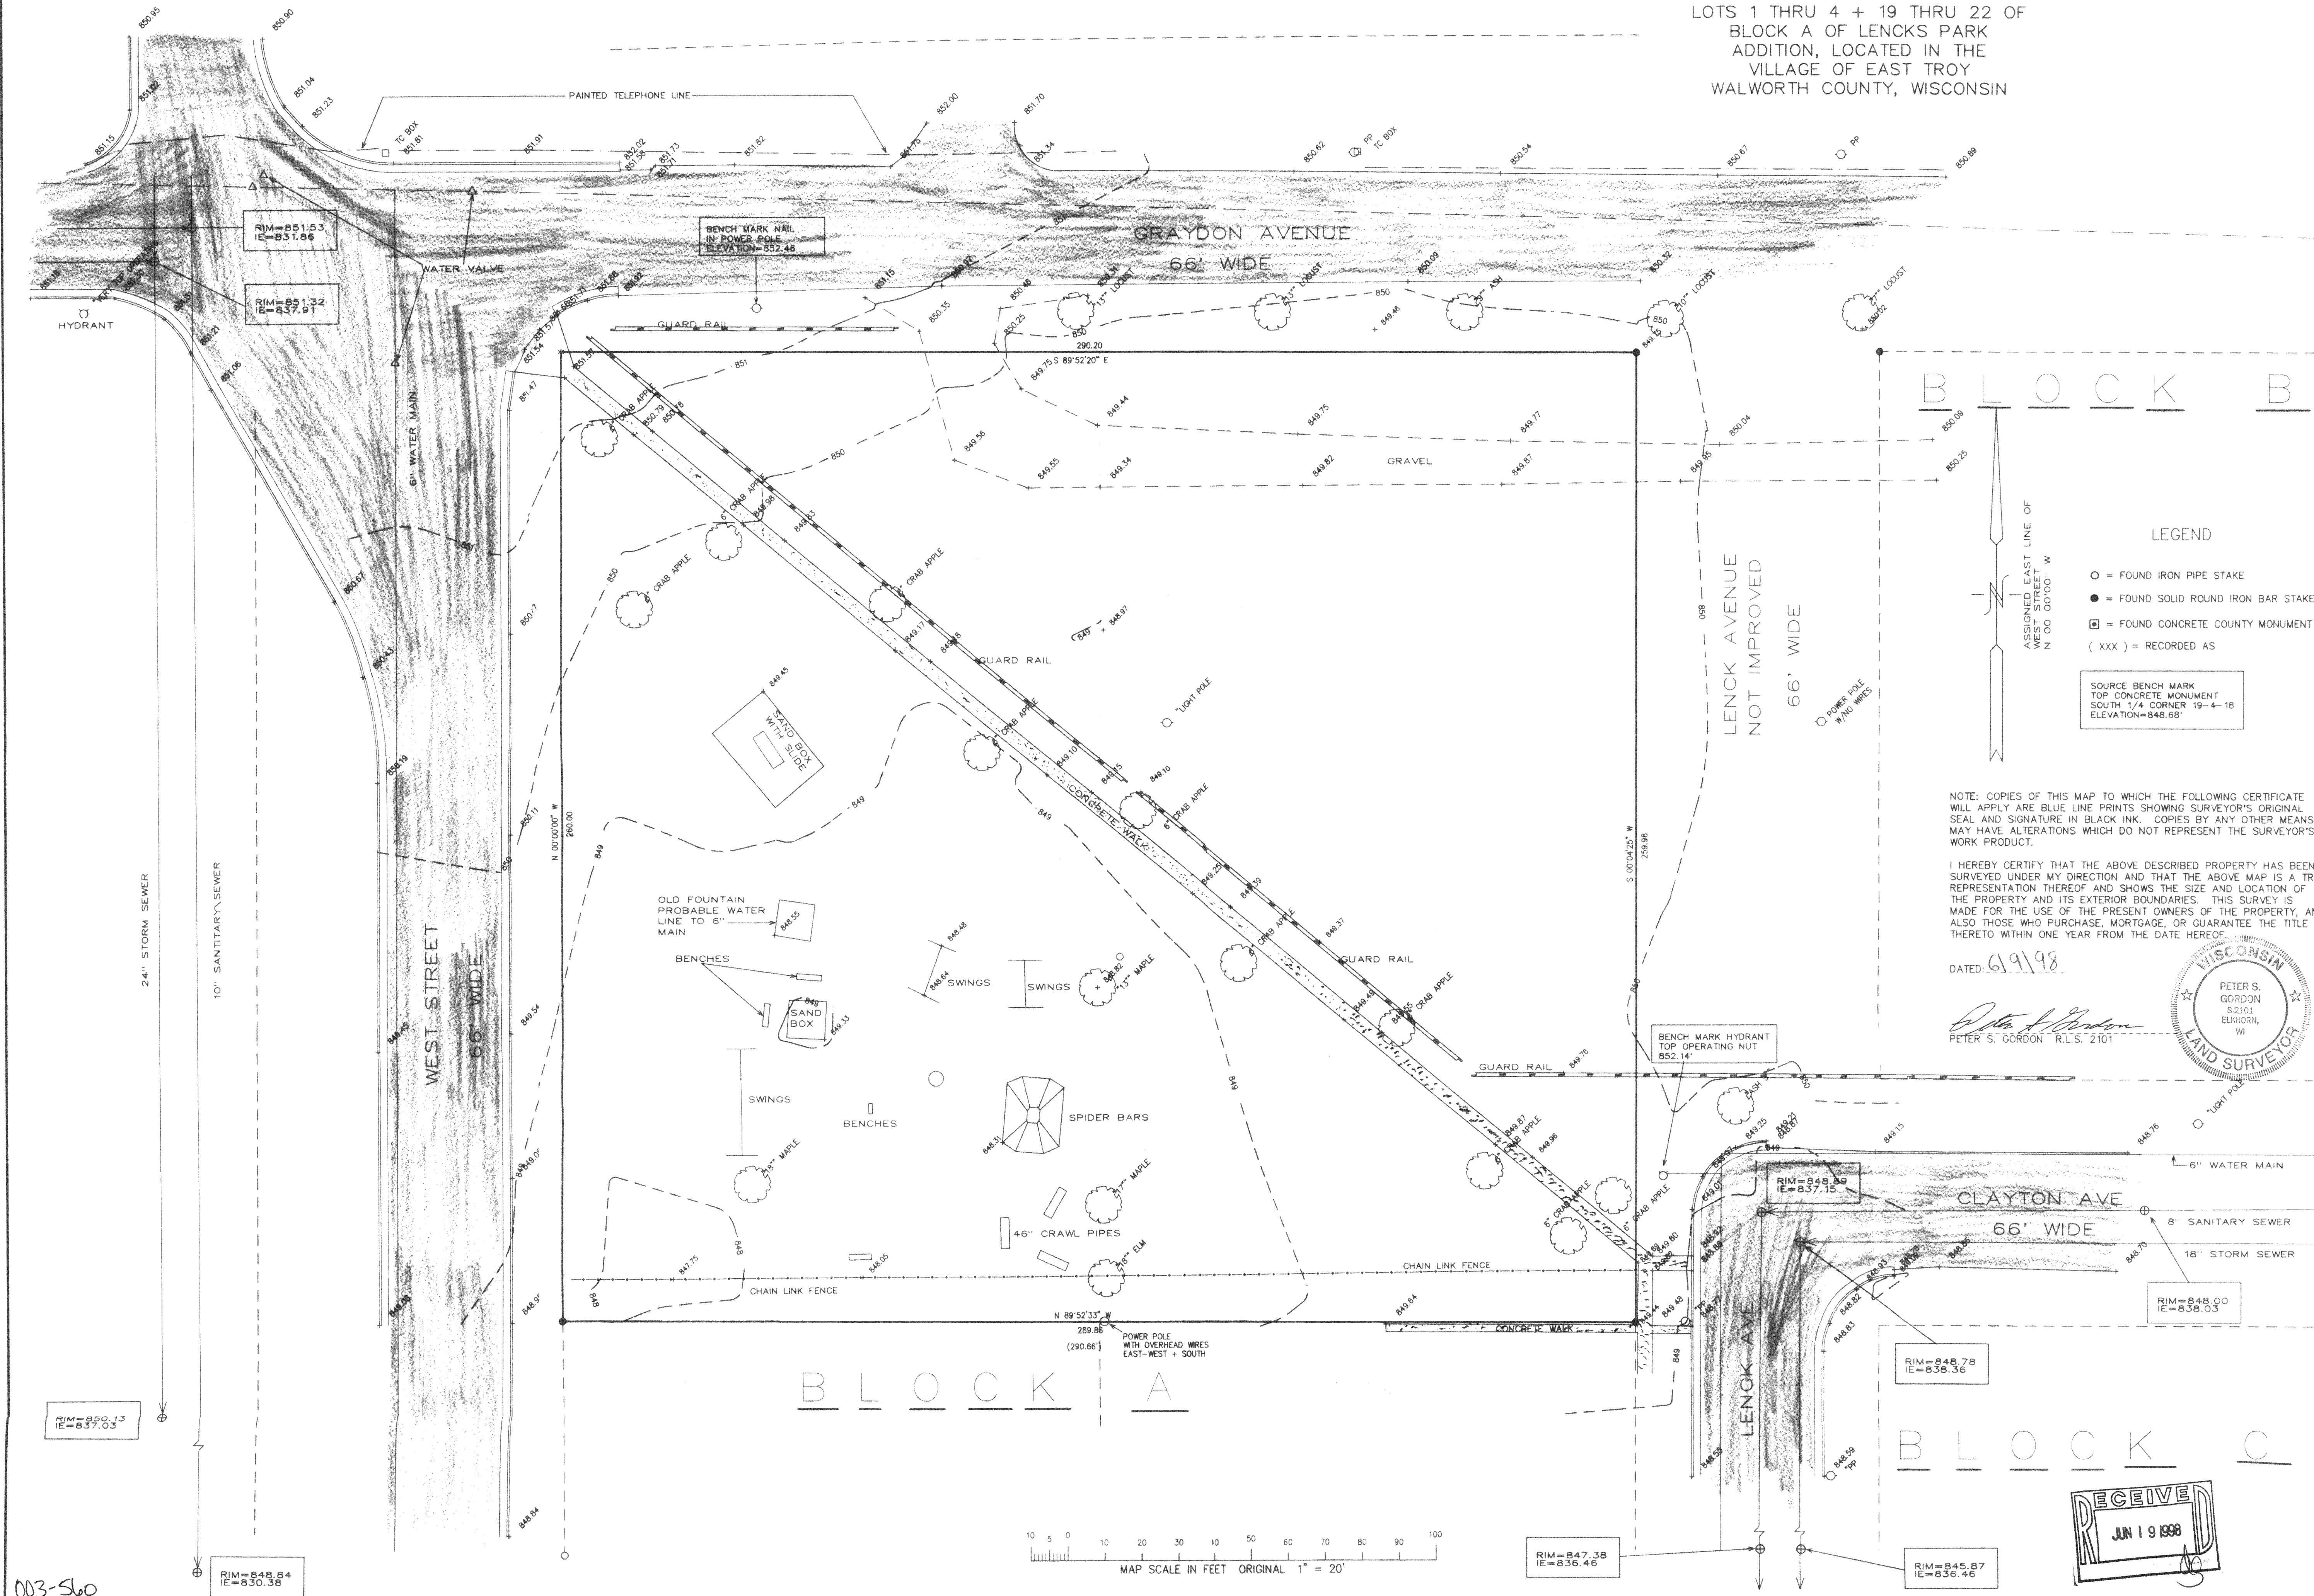

003-Slo

RLP-1,2,3,4,18,19,20,21