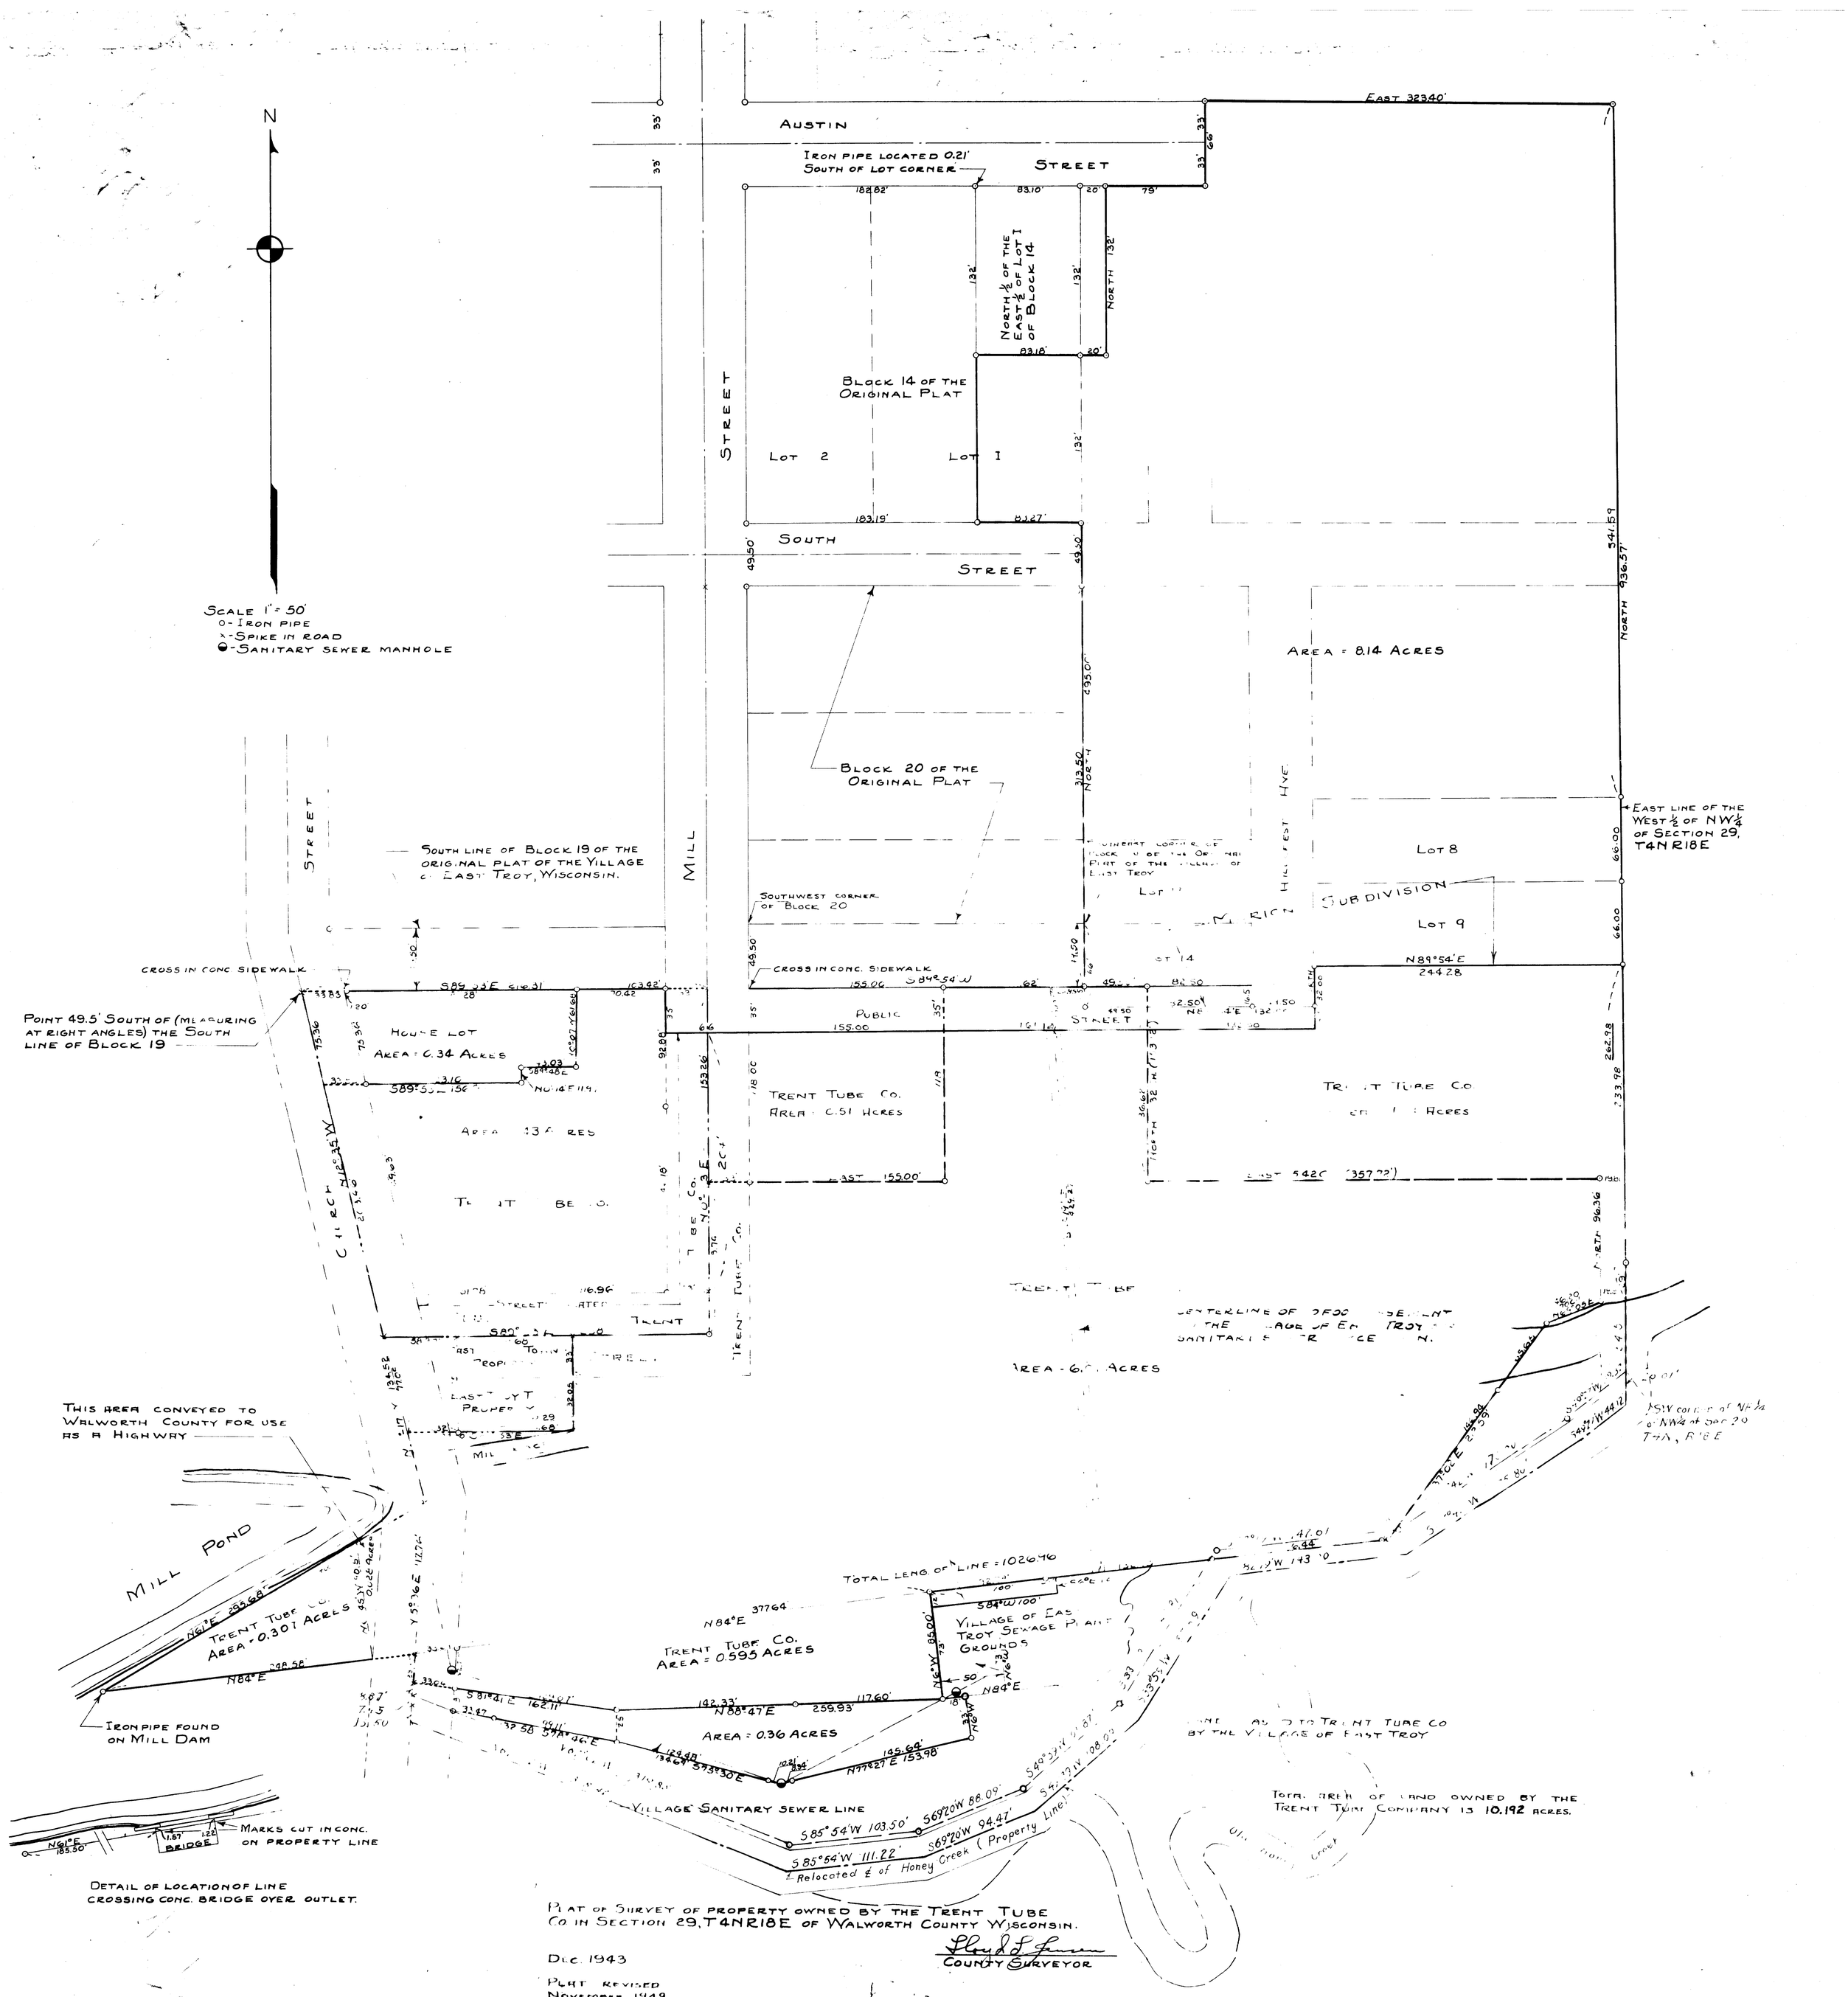

Plat of Survey of property owned by the Trent Tube Co in Section 29, T4N R18E of Walworth County Wisconsin.

Floyd L. Jensen
County Surveyor

Dec. 1943

Plat revised November, 1949
Plat revised July 1951
Plat revised Oct. 1956

UP-166

3-6