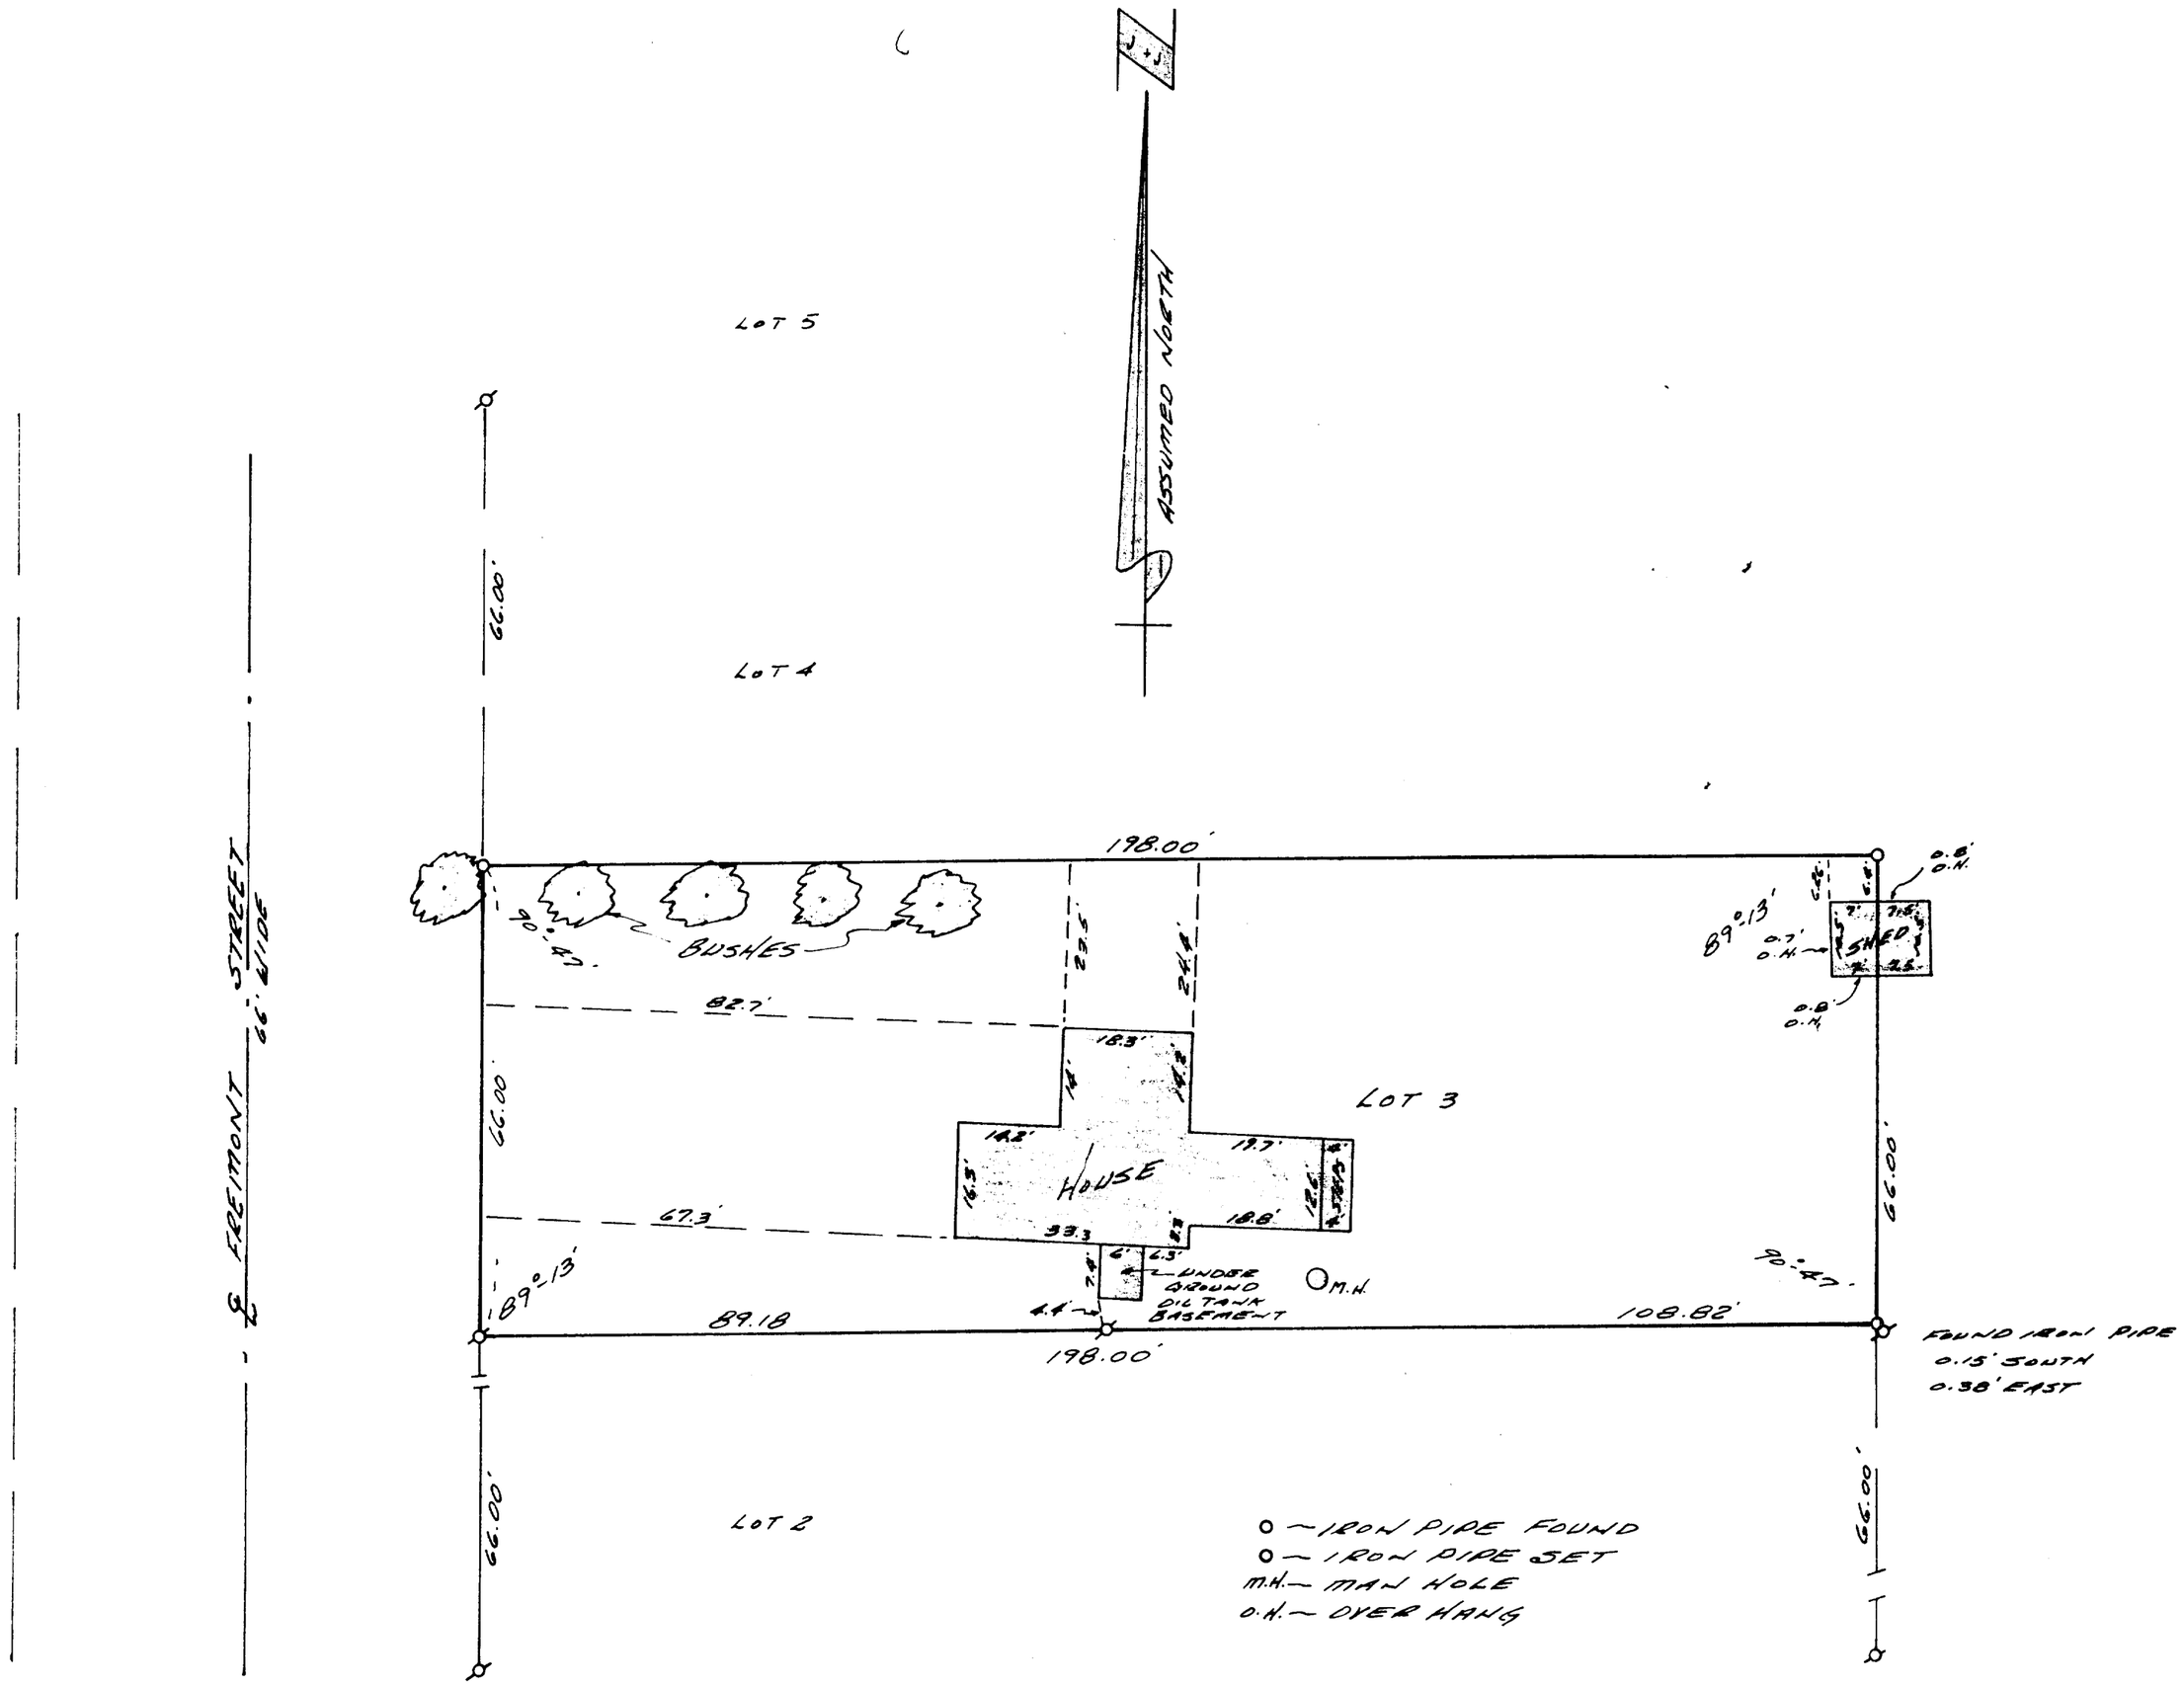

PLAT OF SURVEY
OF

LOT 3, BLOCK 1, J. B. EDWARDS ADDITION
VILLAGE OF EAST TROY, WALWORTH
COUNTY, WISCONSIN.

Thomas P. Jensen
SURVEYOR

SCALE 1" = 20'

DATE MAR. 15, 1974

NO. 175H 300 9-68

3-91 J