#133-72

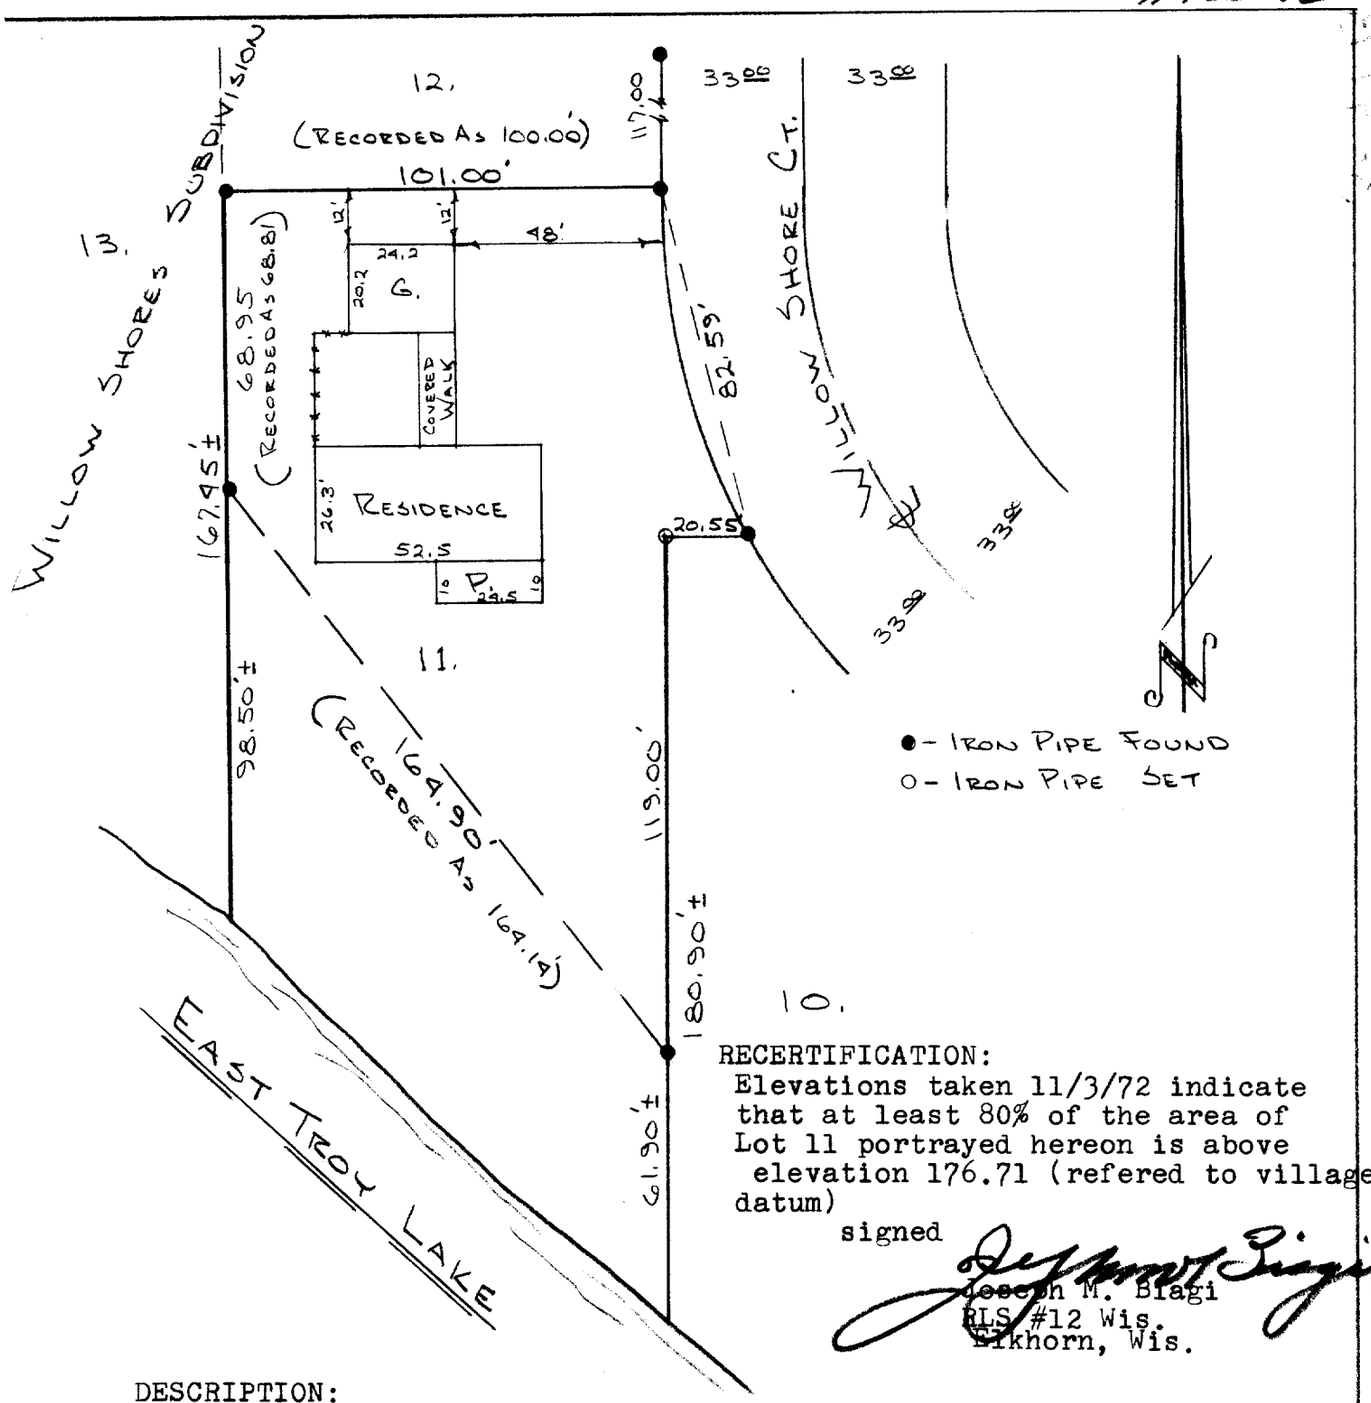

RECERTIFICATION:
Elevations taken 11/3/72 indicate that at least 80% of the area of Lot 11 portrayed hereon is above elevation 176.71 (refered to village datum)

signed
Joseph M. Biagi
RLS #12 Wis.
Elkhorn, Wis.

DESCRIPTION:
Lot number Eleven (11) of Willow Shores Subdivision, located in Section 30, T.4N., R.18E., Village of East Troy, Walworth County, Wisconsin.

CERTIFICATE:
I, Joseph M. Biagi, surveyor, do hereby certify that I have surveyed the lands hereon described.

October 31, 1972

Joseph M. Biagi RLS
Elkhorn, Wisconsin.

3-41B