Heritage Engineering and Surveying, Ltd.

Civil Engineers & Land Surveyors
3213 WASHINGTON AVE.
RACINE, WI 53405
Phone: (414)637-8808

RECEIVED
OCT 25 2005

Job No. 80149

PLAT OF SURVEY

OF PROPERTY OF PURCHESAR TO BE NAMED

described as follows: Lot 2, Willow Shores Subdivision. Village of East Troy, Walworth County, Wisconsin.

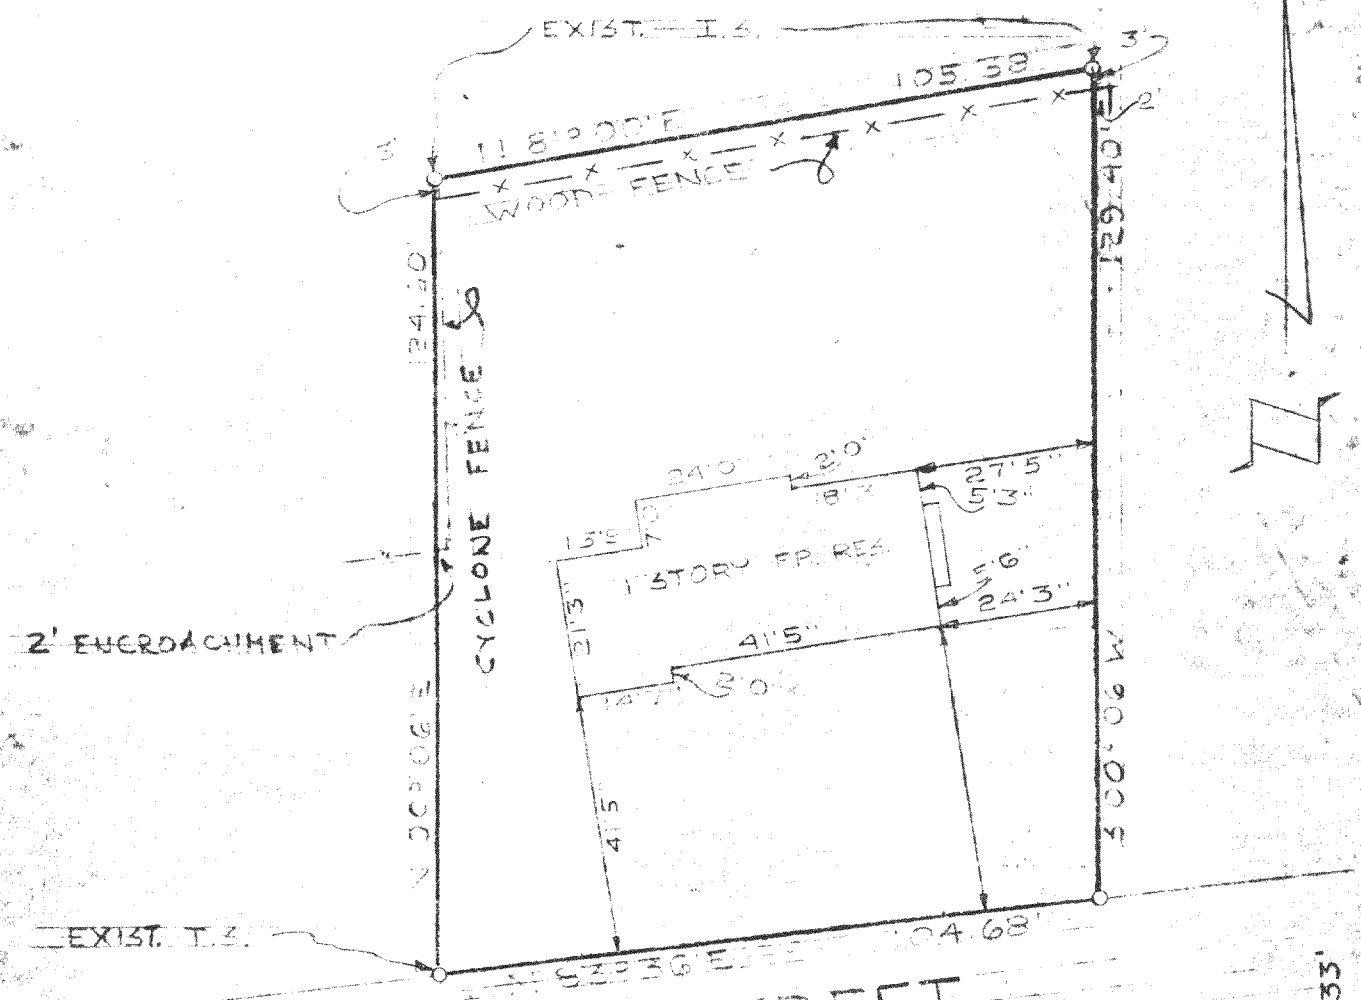

℄ RACINE COUNTY SURVEYOR

FILE NO 11513

RECEIVED DEC 02 1980

BY Veloris A Biron
DEPUTY FOR RECORDS

WISCONSIN
ROBERT J. KELLEY
S-824
RACINE, WIS.
LAND SURVEYOR

State of Wisconsin
County of Racine }

I hereby certify that I have surveyed the property described above according to official records and that the plat above drawn is a correct representation of said survey and shows the size and location of the property, it's exterior boundaries, the location and dimensions of all visible structures thereon, fences, apparent easements roadways and visible encroachments. This survey is made for the exclusive use of the present owners of the property; also those who purchase, mortgage or guarantee the title thereto, within one year of date hereof.

Scale 1"=30'

o Denotes Iron Stakes

RWS-2

Racine, Wis. 7-30, **19** 80

Robert J. Kelley

003-917