TELEPHONE 5018

LLOYD S. DANCEY
PROFESSIONAL ENGINEER E-338
SURVEYING AND PLATTING
125 NORTH CHARLES ST.
WAUKESHA, WIS.

Walworth
RECEIVED
FEB - 5 2013
By

Plat of Survey

0.76137 acre tract of land in
SUPPLY quarter of section No.20
4-18

Scale 1 inch 50 feet

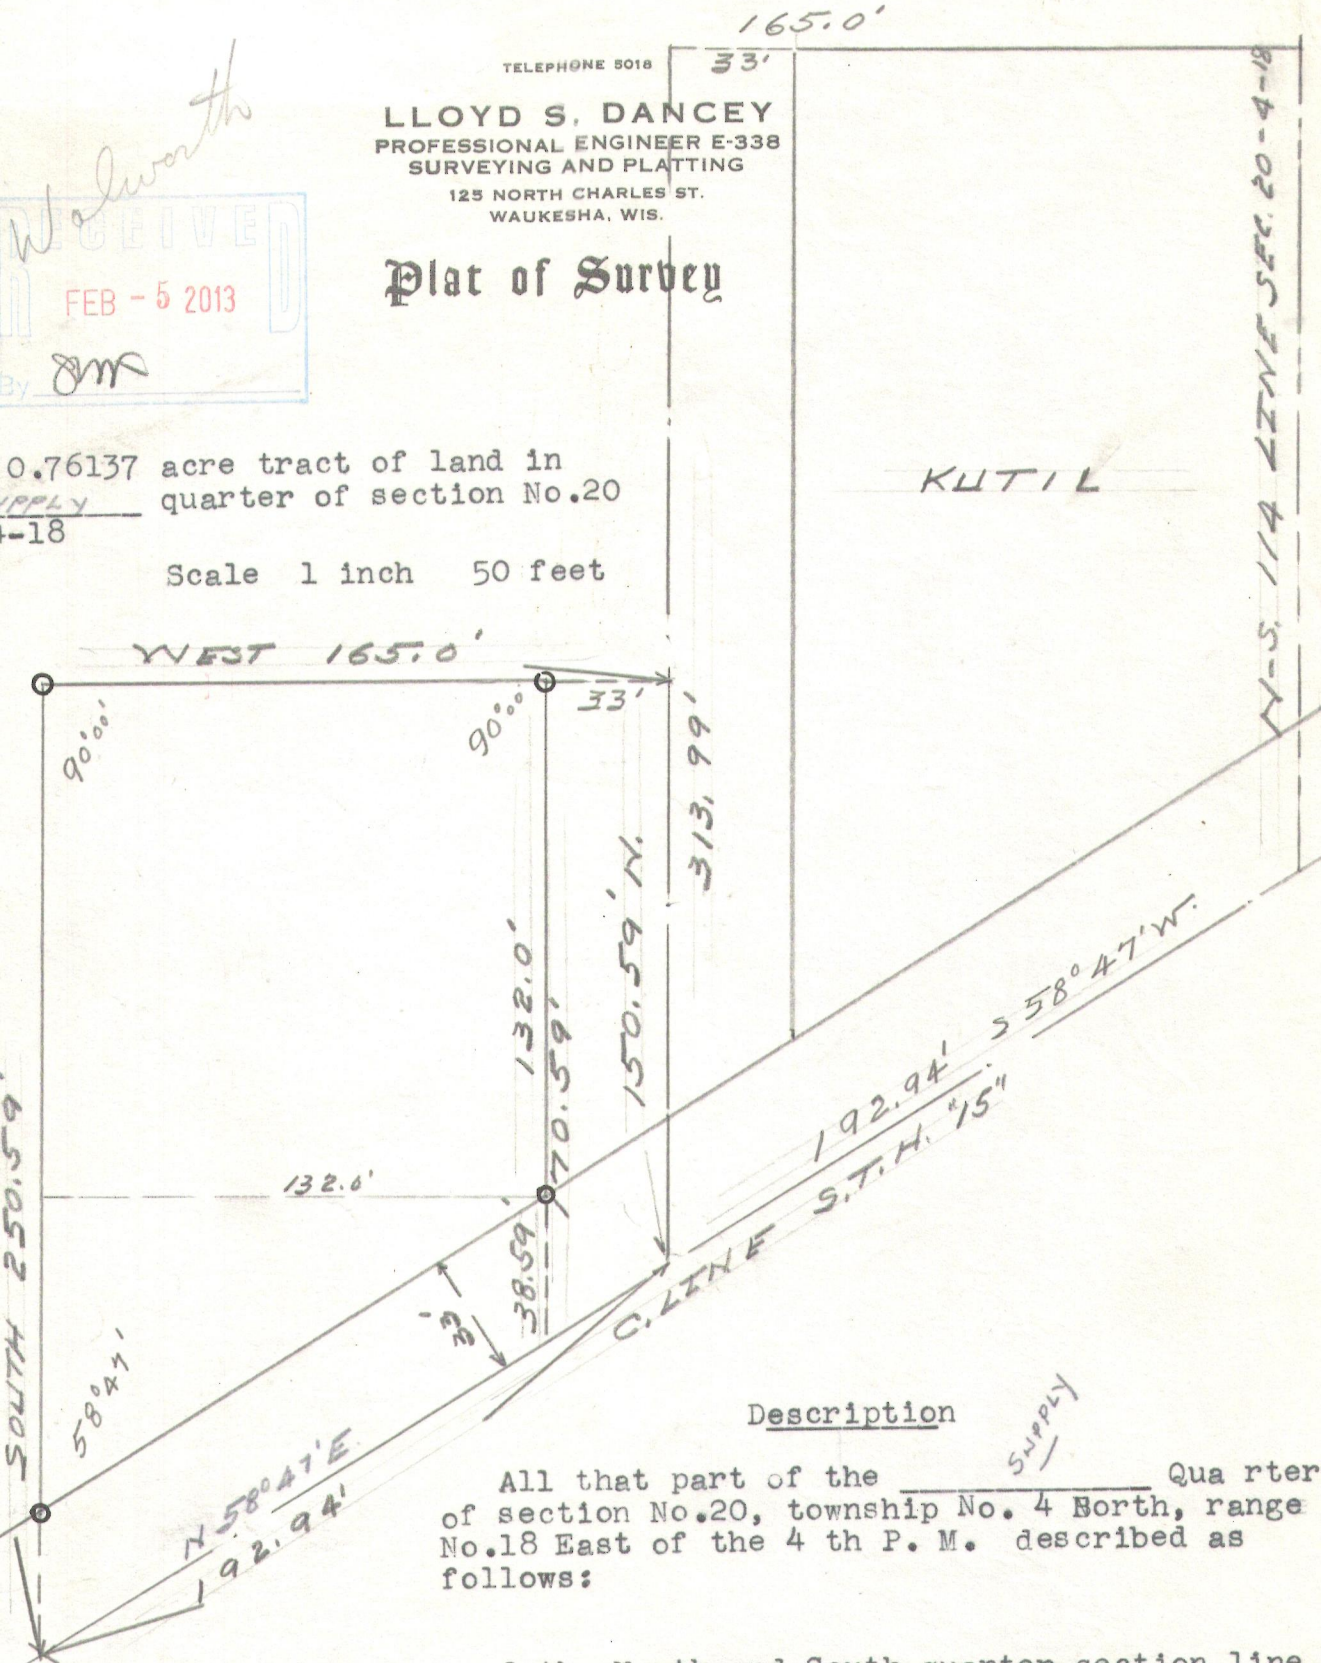

Description

All that part of the SUPPLY Qua rter of section No.20, township No. 4 North, range No.18 East of the 4 th P. M. described as follows:

cing at the intersection of the North and South quarter section line said section with the center line of pavement of S. T. H. #15 , ence South 58 degrees 47 minutes West on said center line (192.94) o the point of commencement of the lands herein described. North and parallel to said quarter line (150.59) feet; thence West degrees with said quarter line (165.0) feet; thence South and paralle d quarter line (250.59) feet to center line aforesaid; thence North rees 47 minutes East(192.94) feet to the point of commencement, ntaining 0.76137 acres of land. Reserving the East 33 feet thereof e as a public street.

f Wisconsin
of Waukesha } SS.

Certificate

d S. Dancey, surveyor, do hereby certify that I have made the survey of lands shown on the within d correctly represented the principal lines and measurements thereof and of the buildings shown thereon.

Lloyd S. Dancey Surveyor
Lloyd S. Dancey

this 11 day of Jan 19 54

003-1017

P-136