

PLAT OF SURVEY

BEING ALL OF LOT 101 OF LAKE BLUFF, LOCATED IN THE SW 1/4 OF SEC. 17 (GOVT LOT 3), T.4N., R.18E., VILLAGE OF EAST TROY, WALWORTH COUNTY, WI.




SURVEYOR:  
KEITH A. KINDRED, PLS S-2082  
SEH YAGGY  
501 MAPLE AVE  
DELAFIELD, WI 53018  
(414) 949-8919

SURVEY FOR:  
BIELINSKI HOMES, INC  
RE: DAVE & LINNEA FLYNN  
1830 MEADOW LANE, SUITE A  
PEWAUKEE, WI 53072

LEGEND

- - 1" IRON PIPE FOUND
- - UTILITY BOX
- Ⓢ - SANITARY MANHOLE

NOTES:  
1. UTILITY EASEMENTS SHOWN PER FINAL PLAT--NO TITLE POLICY PROVIDED  
2. THIS SURVEY IS SUBJECT TO ALL RESTRICTIONS AND NOTES SHOWN ON THE FINAL PLAT OF LAKE BLUFF RECORDED AT WALWORTH COUNTY REGISTER OF DEEDS OFFICE.  
3. PENALTY FOR DISTURBING LOT CORNER MONUMENTS \$250.00 OR UP TO 1 YEAR IMPRISONMENT PER SS. 236.32(2)  
4. MISSING LOT CORNER MONUMENTS WERE NOT RESET AT THIS TIME PER THE CLIENT'S REQUEST. SIGNED LOT PIPE PLACEMENT WAIVER ON FILE IN ACCORDANCE WITH AE 7.01(2).

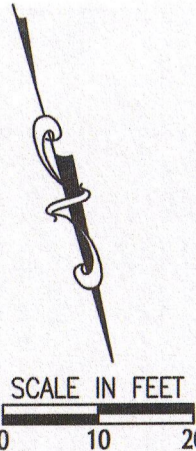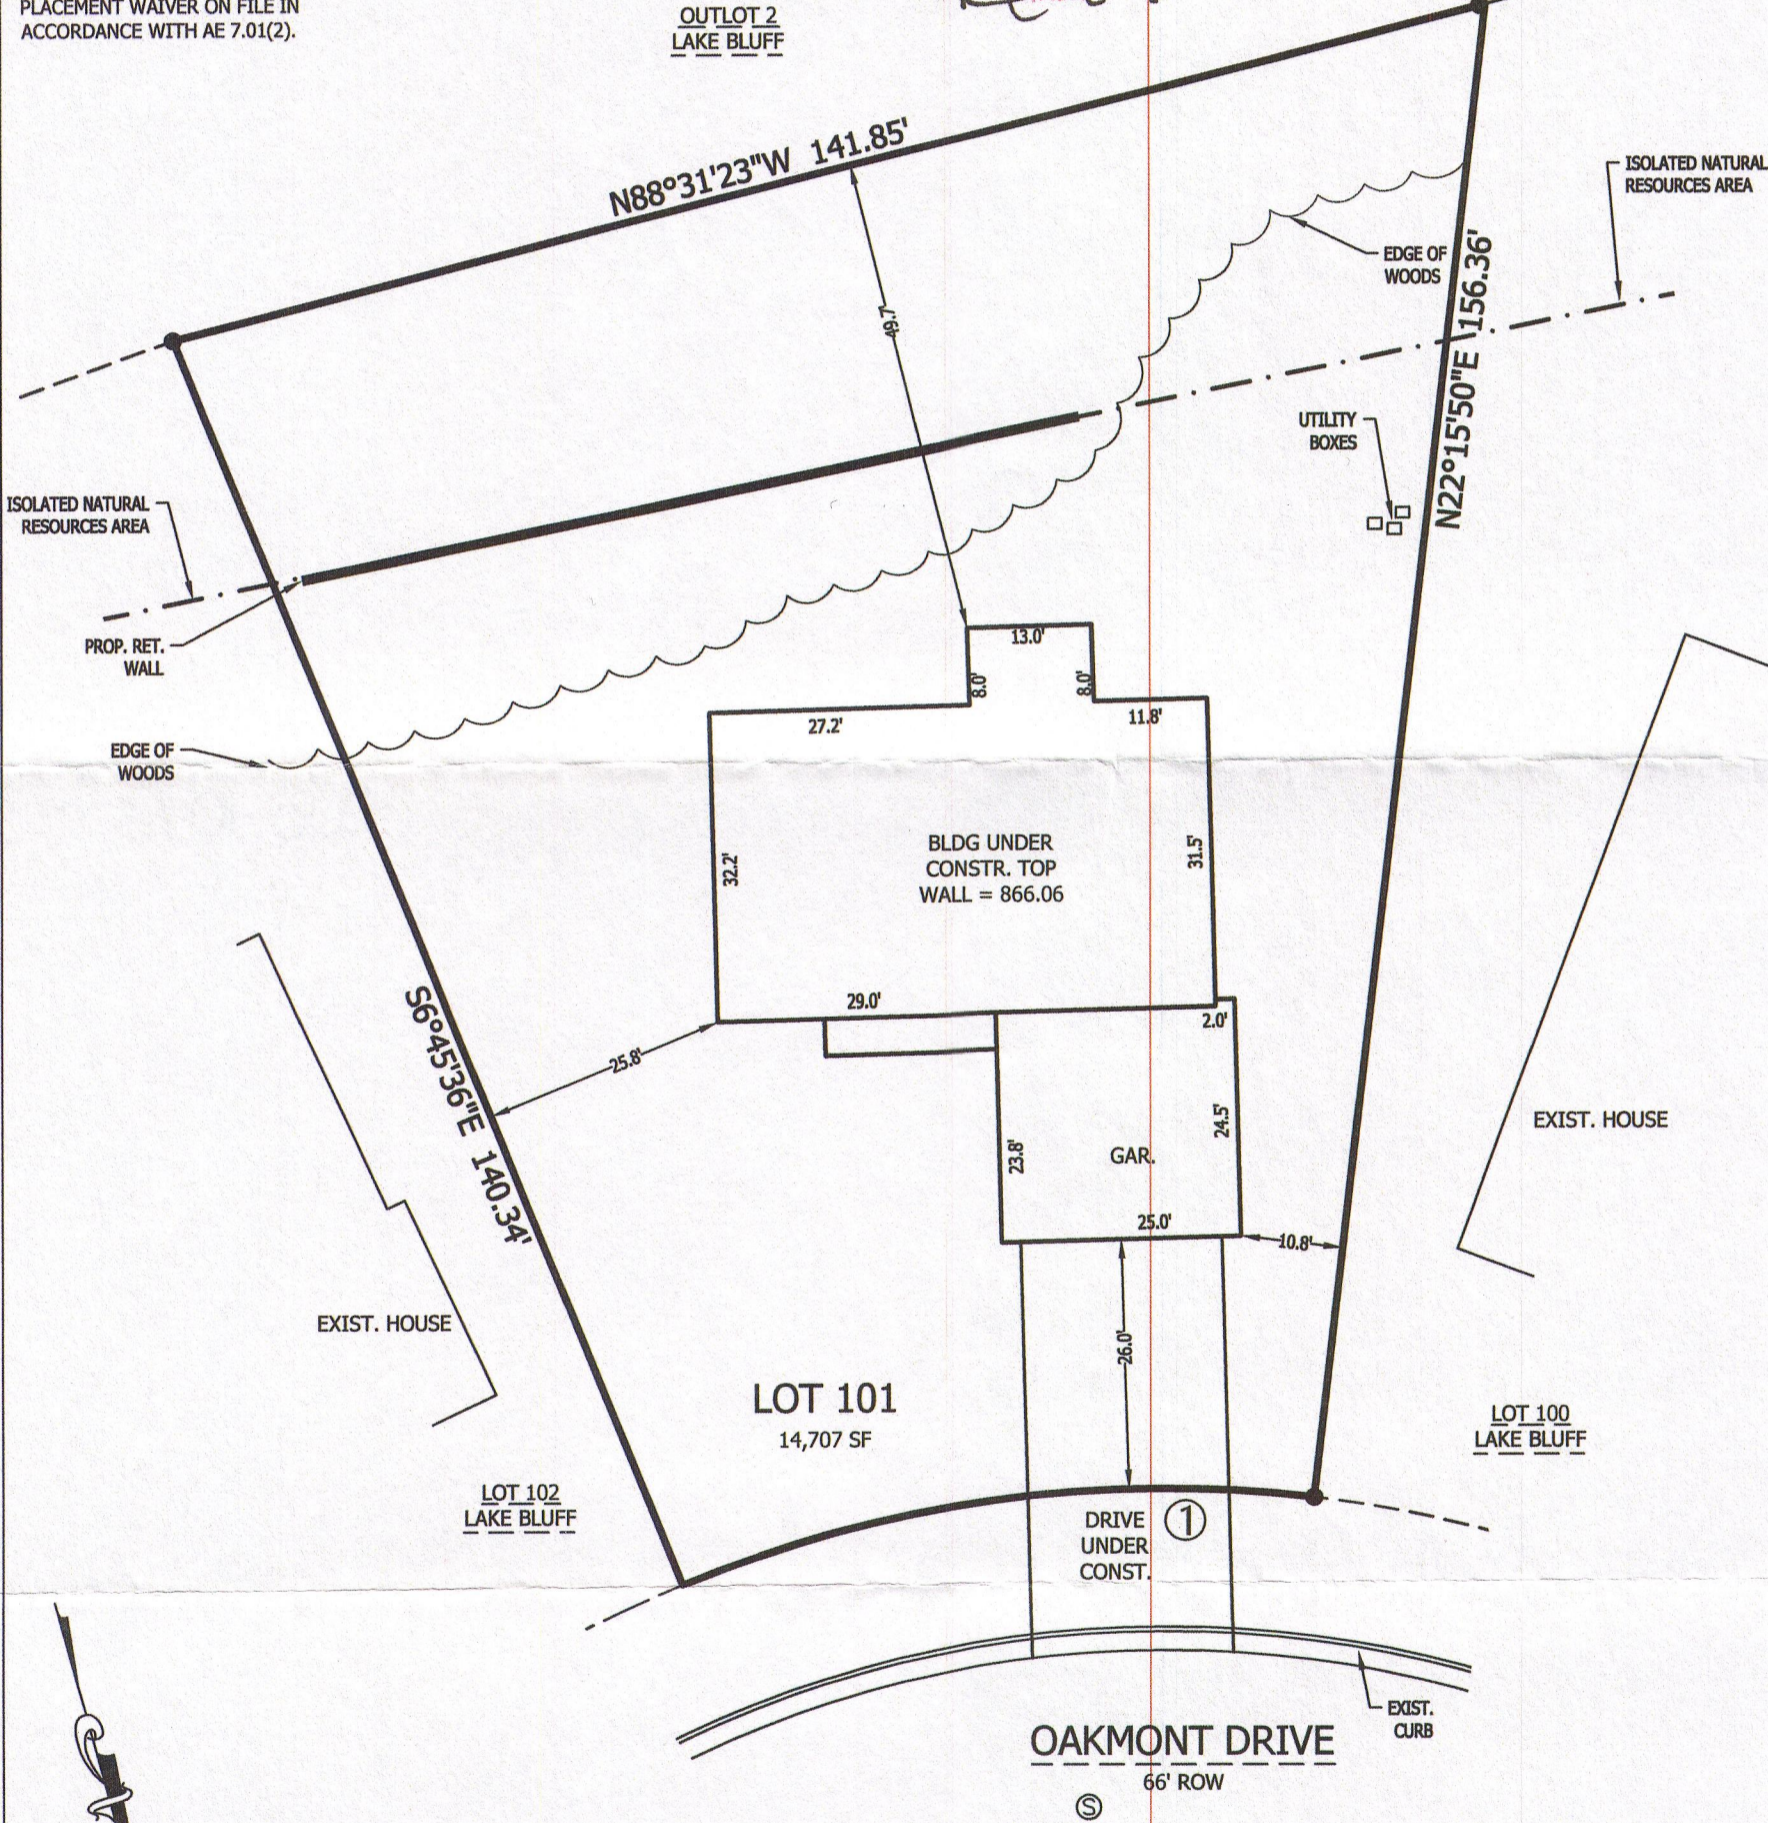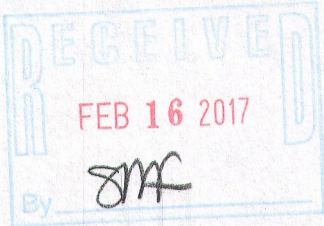

SURVEYOR'S CERTIFICATE:

I HEREBY CERTIFY THAT I HAVE SURVEYED THE ABOVE DESCRIBED PROPERTY AND THAT THE ABOVE MAP IS A TRUE REPRESENTATION THEREOF AND SHOWS THE SIZE AND LOCATION OF THE PROPERTY, ITS EXTERIOR BOUNDARIES, THE LOCATION OF ALL VISIBLE STRUCTURES AND DIMENSIONS OF ALL PRINCIPAL BUILDINGS THEREON, BOUNDARY FENCES, APPARENT EASEMENTS, ROADWAYS, AND VISIBLE ENCROACHMENTS, IF ANY.  
THIS SURVEY IS MADE FOR THE USE OF THE PRESENT OWNERS OF THE PROPERTY, AND ALSO THOSE WHO PURCHASE, MORTGAGE, OR GUARANTEE THE TITLE THERETO WITHIN ONE (1) YEAR FROM DATE HEREOF.  
SEH YAGGY 501 MAPLE AVE., DELAFIELD, WI 53018 262-646-6855  
PATH: P:\B12682\DWG\101 POS.DWG

① Chord: 66.65'  
Course: S 82°14'53" E  
Arc Length: 67.37'  
Radius: 133.00'  
Delta: 29°01'26"