(48-53)

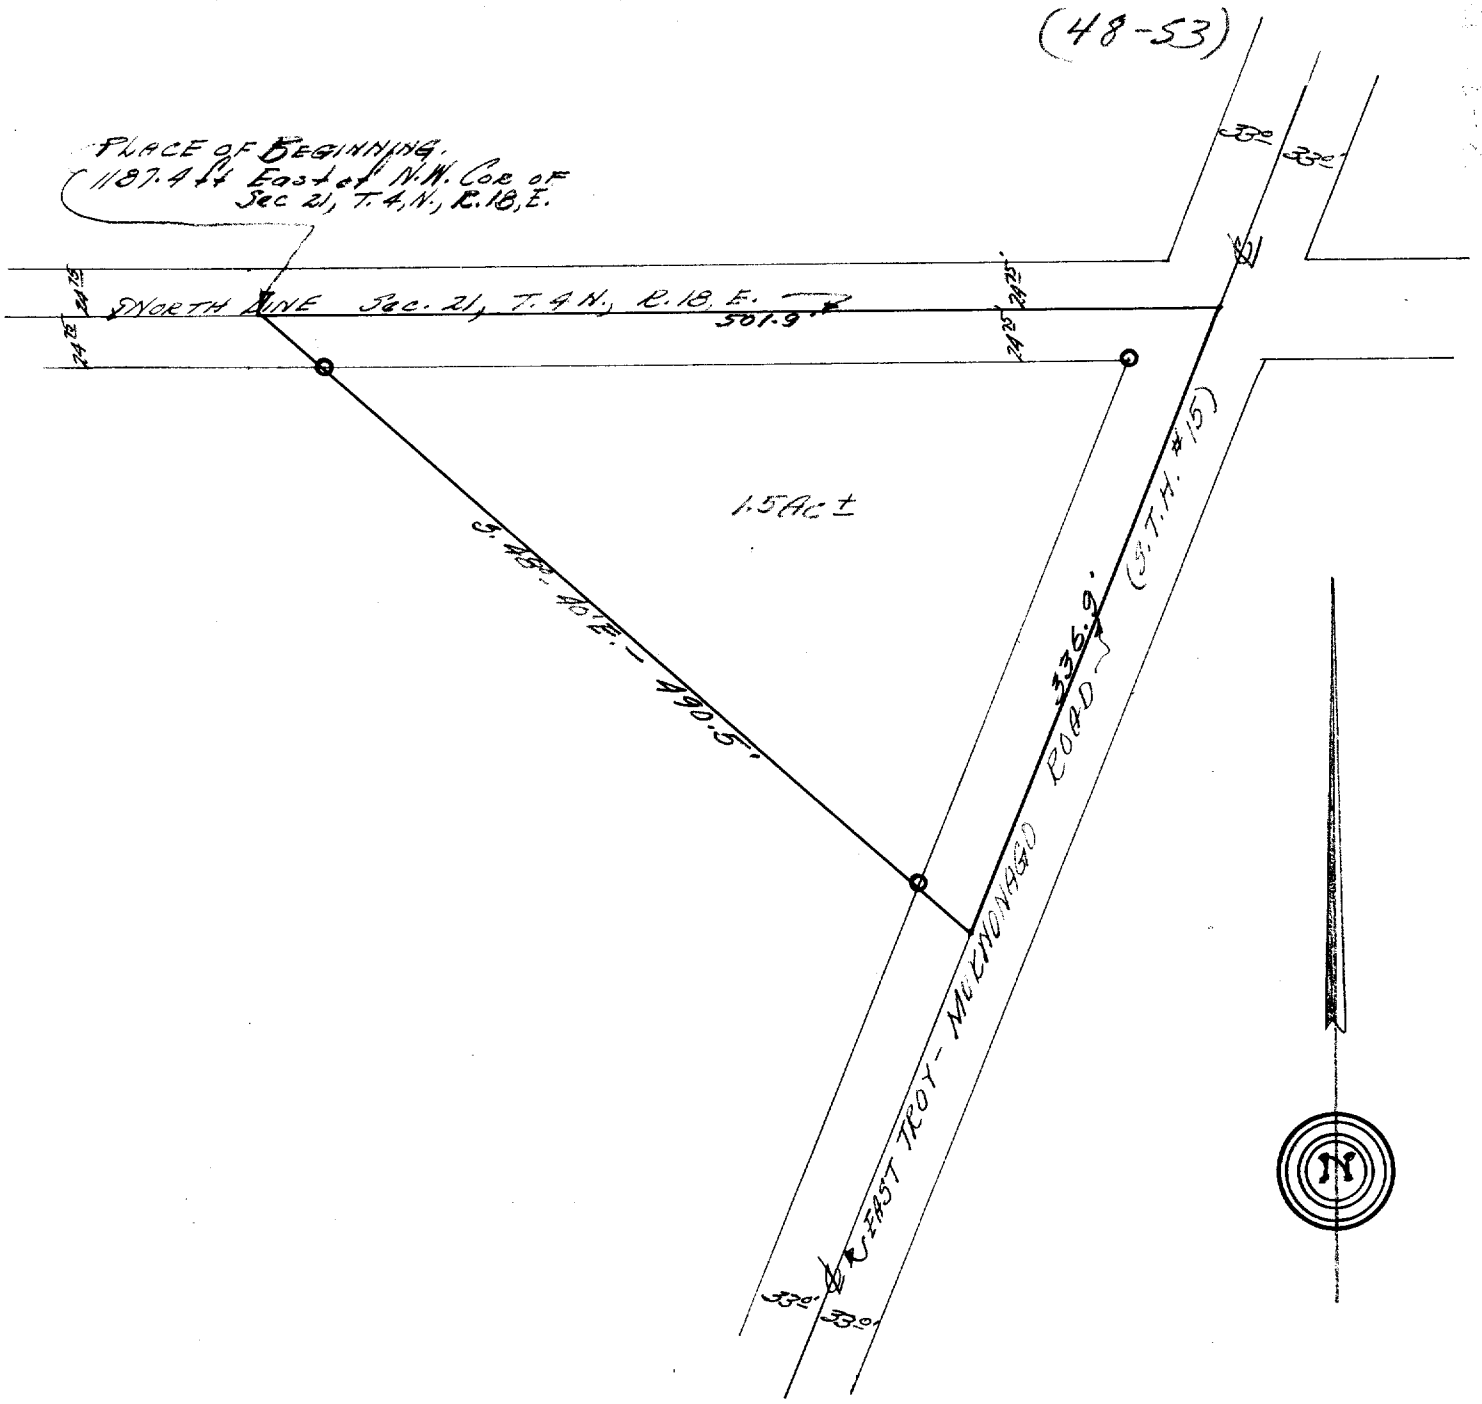

DESCRIPTION:

Commencing at a point in the north line of Section 21, Town 4 north, Range 18 east of the 4th Principal Meridian, that is 1187.4 feet East of the Noertwest corner of said section 21, thence S. 48 40' E., 490.5 feet to the centerline of the East Troy and Mukwonago Road (now known as the State Trunk Highway #15), thence Northwesterly along the centerline of said highway 336.9 feet to a point in the north line of said section 21, thence West in the north line of said section 501.9 feet to the place of beginning. Containing 1.5 acres more or less.

CERTIFICATE:

I, hereby certify that I have on this the 26th day of November, 1948, surveyed the above described property according to the official records on file in the office of the Recorder of Deeds in and for Walworth County, Wisconsin, and find that the measurements and bearings of the boundary lines of said property as takem at the site on this day, substantially agree with those in the above description and that no encroachments exist.

SIGNED AND SEALED THIS 29TH DAY OF NOVEMBER 1948.

Joseph M. Biagi.
Professional Engineer
Elkhorn Wisconsin.

XUP-212 (part of) Mukw Hwy

3-83B