

W 238 S 3712 BIG BEND ROAD
WAUKESHA, WIS 53186

TELEPHONE
542-5616

RONALD H. ZIMMERMAN
REGISTERED LAND SURVEYOR

PLAT OF SURVEY

FOR

WAUKESHA SAVINGS & LOAN

6

GRAYDON

AVE.

N 89° 55' E.

275.00'

R = 95.03'
Δ = 45°00'
CH = 72.74'
BR = N 22° 25' E.

6

2 ST.
BR
APT

N 89° 55' E.

203.02'

R = 161.03'
Δ = 33°53'
CH = 93.85'
BR = N 27° 58' 30" E.

9

SCALE 1" = 40'

STATE OF WISCONSIN)
COUNTY OF WAUKESHA) SS


CERTIFICATION

I, RONALD H. ZIMMERMAN, REGISTERED LAND SURVEYOR, DO HEREBY CERTIFY THAT I HAVE MADE A SURVEY
OF LOT 6, TROYJENS APARTMENTS SUBD., VILLAGE OF EAST TROY,
AND THE EXISTING BUILDING AND IMPROVEMENTS LOCATED THEREON AND THAT THE PLAT HEREWITH DRAWN
IS A CORRECT REPRESENTATION OF SAID SURVEY.

DATE NOV. 30, 19 73.

RONALD H. ZIMMERMAN

S - 868

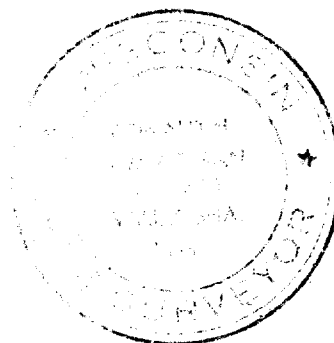

3-85