PLAT OF SURVEY

RSV ENGINEERING, INC.
Engineers • Land Surveyors • Environmental Scientists
801 MAIN STREET MUKWONAGO, WISCONSIN 53149 (262)363-2004

FOR: DAN CARMODY

DATE: 9/05/2003

DESCRIPTION:
LOT 97 OF ELKHORN WEST ADDITION NO. 1 BEING PART OF THE NORTHEAST 1/4 AND THE SOUTHEAST 1/4 OF THE SOUTHEAST 1/4 OF SECTION 35, T3N, R16E AND PART OF THE NORTHEAST 1/4 OF THE NORTHEAST 1/4 OF SECTION 2, T2N, R16E, CITY OF ELKHORN, WALWORTH COUNTY, WISCONSIN

LEGEND

- FOUND 1" IRON PIPE
- UTILITY PEDISTAL

CURVE TABLE DATA

NO.	DELTA	RADIUS	ARC	CHD. BRG.	CHD. L.
C1	15°45'23"	294.00'	80.85'	S78°29'55.5"W	80.60'

LINE TABLE DATA

L1	S70°37'14"W	19.58'
L2	N81°21'07"E	67.70'

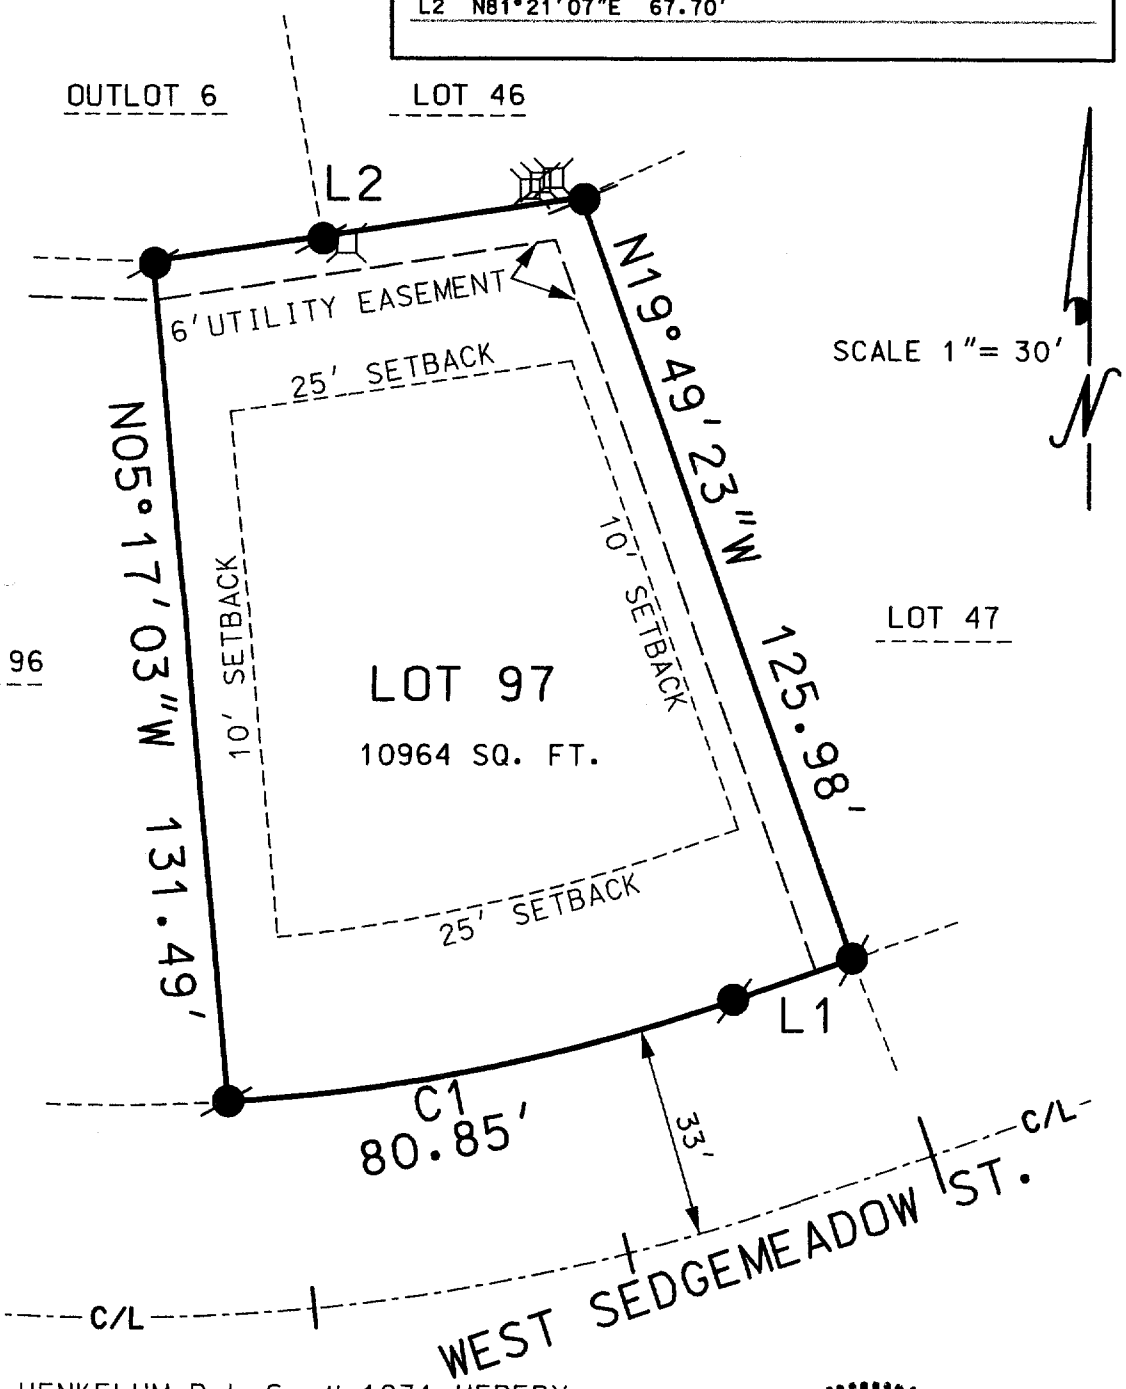

NOV 1 8

KW

I PAUL H. VAN HENKELUM R.L.S. # 1931 HEREBY CERTIFY THAT THIS SURVEY WAS MADE IN ACCORDANCE WITH THE MINIMUM STANDARDS FOR PROPERTY SURVEYS (CHAPTER A-E7) STATE OF WISCONSIN AND HAS BEEN PREPARED UNDER MY DIRECTION AND CONTROL AND IS CORRECT TO THE BEST OF MY KNOWLEDGE AND BELIEF.

9/7/03

PAUL H. VAN HENKELUM, R.L.S. # 1931
RSV# 00291 291LOT97.DGN

WISCONSIN
PAUL H. VAN HENKELUM S-1931 MUKWONAGO, WI
LAND SURVEYOR

004-1689

YEW1-97