205-62

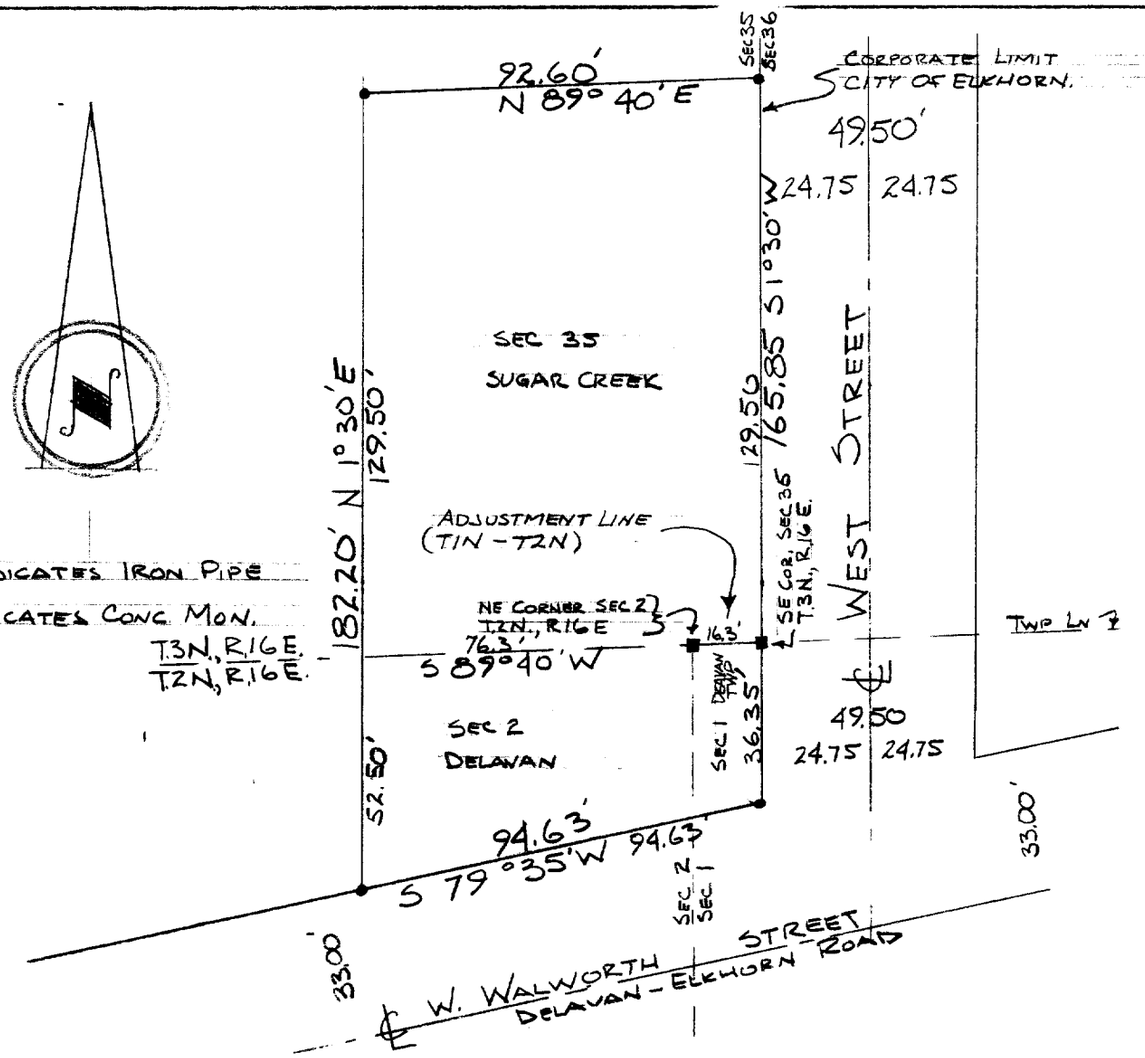

DESCRIPTION: Commencing at the NE corner of Section 2, T.2 N.,R.16 E. Walworth County, Wisconsin, thence S. 89° 40' W along the N line of said section 76.30 feet thence south parallel to the East line of said section 52.50 feet to the northerly right of way line of the Elkhorn-Delavan road (S.T.Hwy. #15) thence N 79° 35' E along said right of way 94.63 feet, thence north parallel to the east line of said section 36.35 feet to the north line of said section, thence S 89° 40' W. 16.30 feet to the place of beginning. Also the South 129.50 feet of the East 92.60 feet of the SE¼ of section 35, T.3 N., R.16 E. Walworth County Wisconsin.

CERTIFICATE: I, James F. Biagi, surveyor, do hereby certify that I have surveyed the property hereon described on this 18th. day of September, 1962.

WISCONSIN
JAMES F. BIAGI
MILWAUKEE, WIS.
LAND SURVEYOR

James F. Biagi RLS 272

UNW-148

4-187