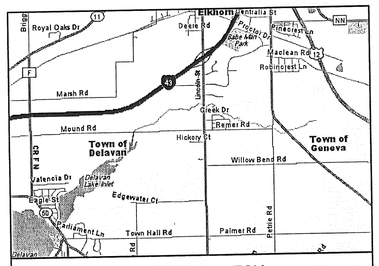

LOCATION SKETCH

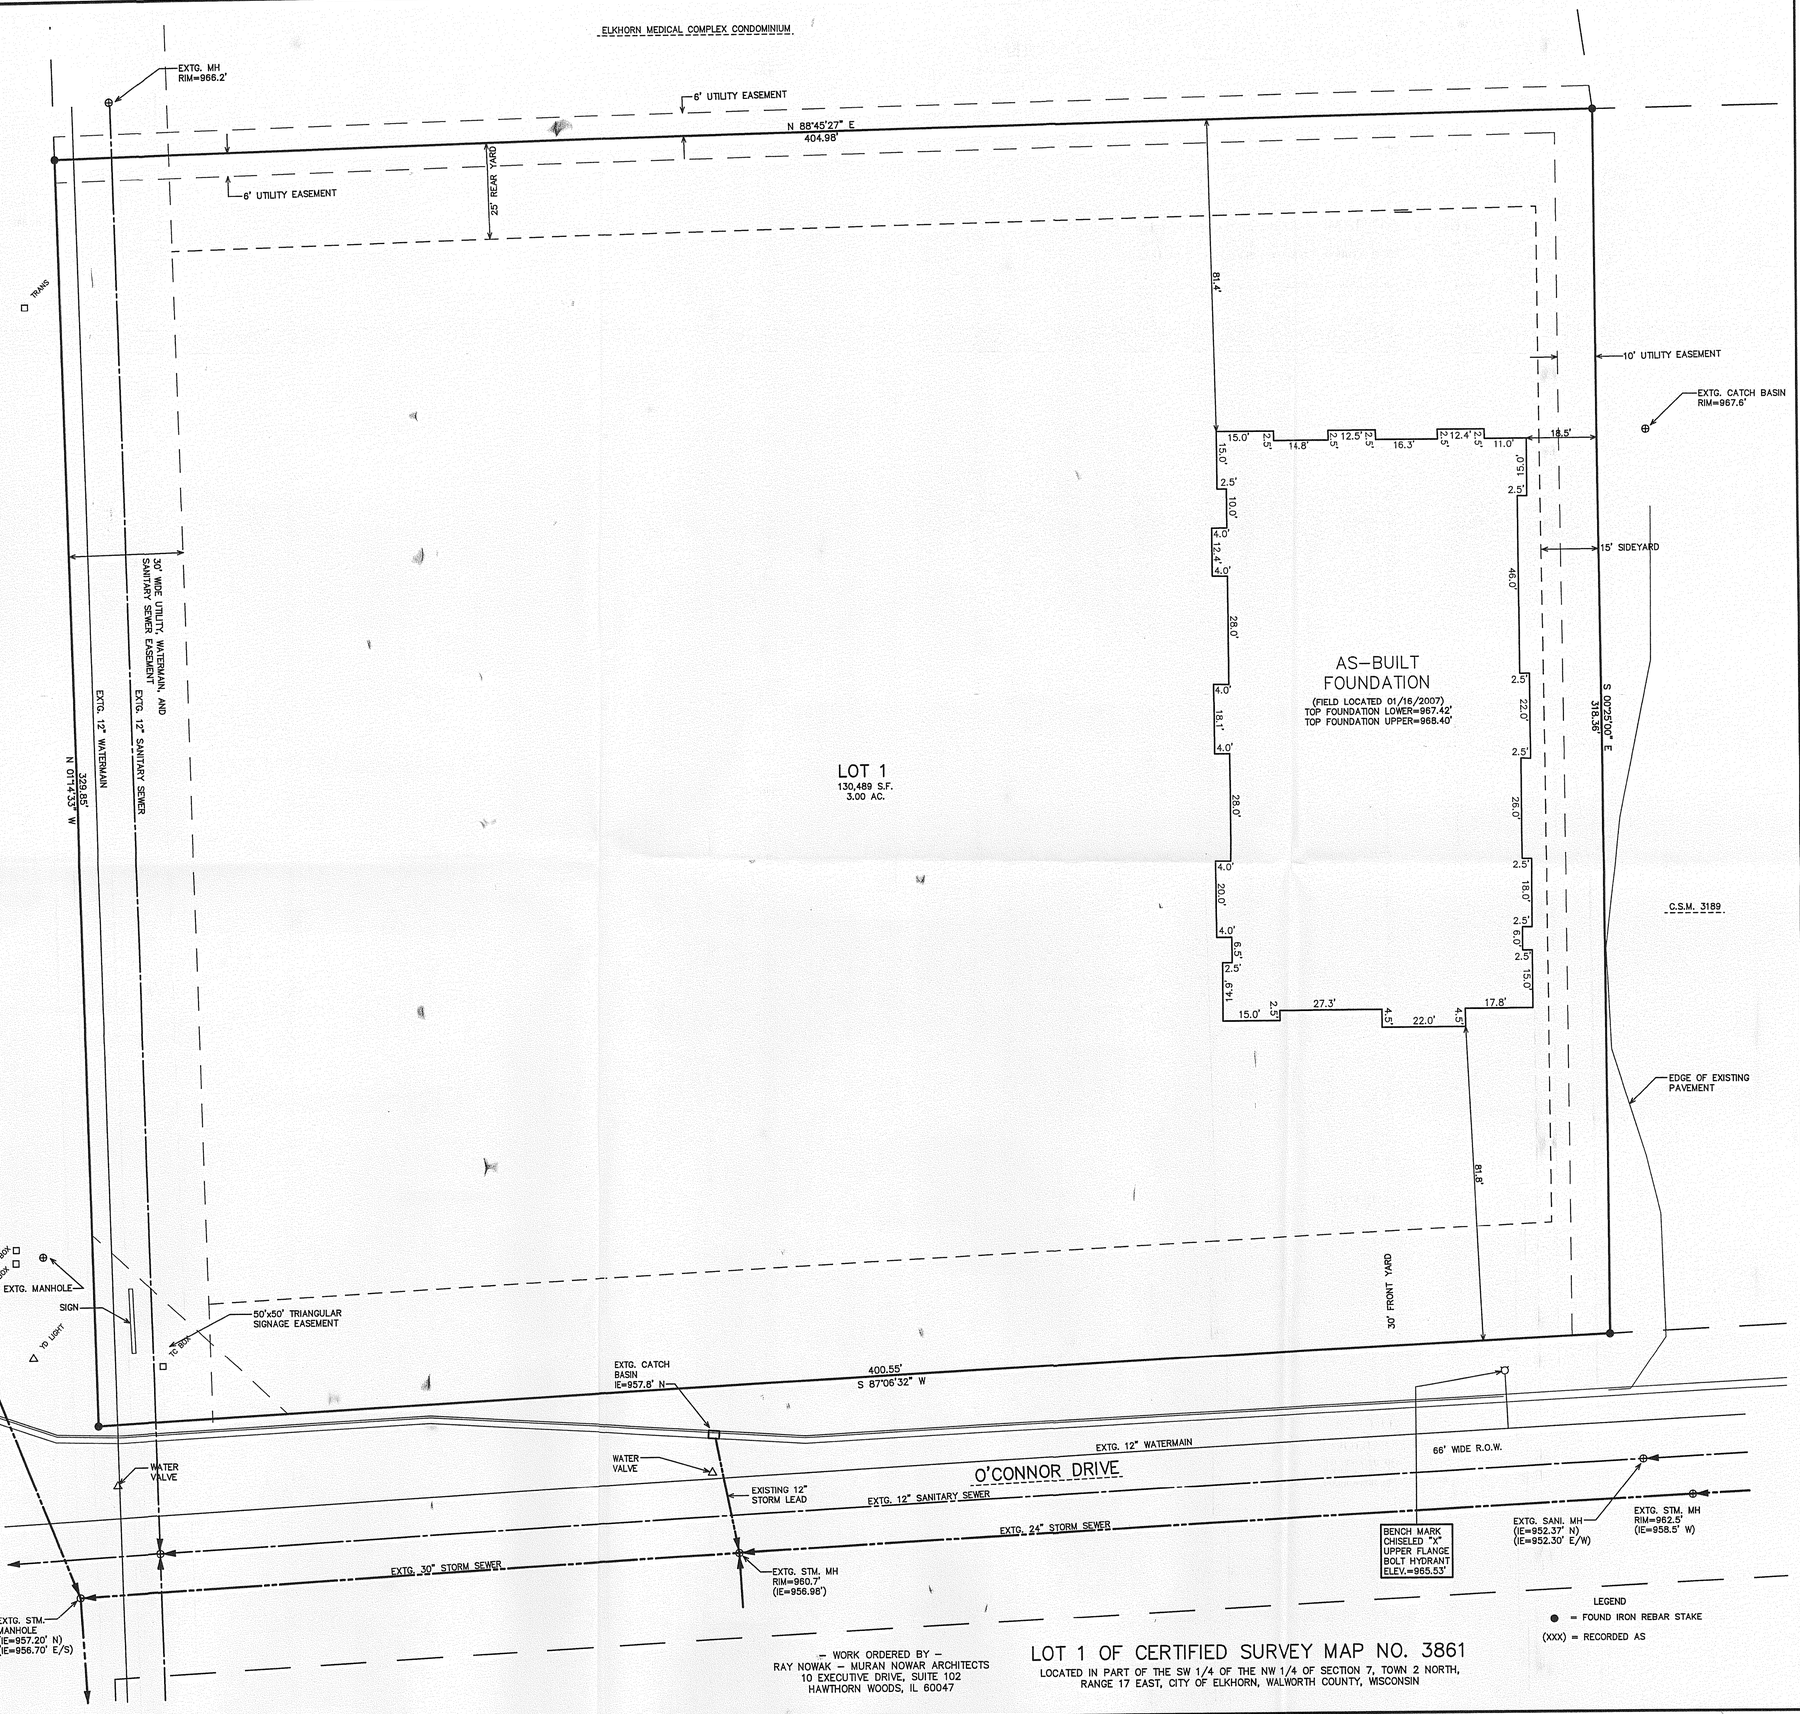

RECEIVED FEB 19 2007 SMF

NOTE: COPIES OF THIS MAP TO WHICH THE FOLLOWING CERTIFICATE WILL APPLY SHOW THE SURVEYOR'S ORIGINAL SEAL AND SIGNATURE IN RED INK. COPIES BY ANY OTHER MEANS MAY HAVE ALTERATIONS WHICH DO NOT REPRESENT THE SURVEYOR'S WORK PRODUCT.

I HEREBY CERTIFY THAT THE ABOVE DESCRIBED PROPERTY HAS BEEN SURVEYED UNDER MY DIRECTION AND THAT THE ABOVE MAP IS A TRUE REPRESENTATION THEREOF AND SHOWS THE SIZE AND LOCATION OF THE PROPERTY AND ITS EXTERIOR BOUNDARIES. THIS SURVEY IS MADE FOR THE USE OF THE PRESENT OWNERS OF THE PROPERTY, AND ALSO THOSE WHO PURCHASE, MORTGAGE, OR GUARANTEE THE TITLE THERETO WITHIN ONE YEAR FROM THE DATE HEREOF.

DATED: JANUARY 17, 2007

PETER S. GORDON R.L.S. 2101

WISCONSIN PETER S. GORDON S-2101 ELKHORN, WI LAND SURVEYOR

— WORK ORDERED BY —
RAY NOWAK – MURAN NOWAR ARCHITECTS
10 EXECUTIVE DRIVE, SUITE 102
HAWTHORN WOODS, IL 60047

LEGEND
● = FOUND IRON REBAR STAKE
(XXX) = RECORDED AS

LOT 1 OF CERTIFIED SURVEY MAP NO. 3861

LOCATED IN PART OF THE SW 1/4 OF THE NW 1/4 OF SECTION 7, TOWN 2 NORTH, RANGE 17 EAST, CITY OF ELKHORN, WALWORTH COUNTY, WISCONSIN

BUSINESS PARK PLAZA
CITY OF ELKHORN
WALWORTH COUNTY, WISCONSIN

AS-BUILT MAPPING

FARRIS, HANSEN & ASSOCIATES, INC.
ENGINEERING – ARCHITECTURE – SURVEYING
7 RIDGWAY COURT P.O. BOX 437
ELKHORN, WISCONSIN 53121
OFFICE: (262) 723-2098 FAX: (262) 723-5886

REVISIONS
04/14/2006 MISC. ADVANCMENT
05/04/2006 BS MISC. REVISIONS
05/10/2006 KD MISC. REVISIONS
05/31/2006 KD MISC. REVISIONS
09/05/2006 PJ MISC. REVISIONS
09/18/2006 PJ MISC. REVISIONS
01/17/2007 KD TO SHOW SIZE AND LOCATION OF AS-BUILT FOUNDATION BLDG. #2

PROJECT NO. 6906
DATE 12/22/05
SHEET NO. 1 of 1

1/17/2007 K:\Projects\6906\Dwgs\AS_BUILT

YA3861-1

004-2110