


PLAT OF SURVEY
TAX PARCEL YV SE 00003D1A

LOCATED IN PART OF THE NE 1/4 OF THE SE 1/4 OF
SECTION 6, TOWN 2 NORTH, RANGE 17 EAST,
CITY OF ELKHORN, WALWORTH COUNTY, WISCONSIN

SOUTHWEST LINE OF PROJECT PARCEL
BEARS N 69°54'51" W
PER SURVEY OF RECORD

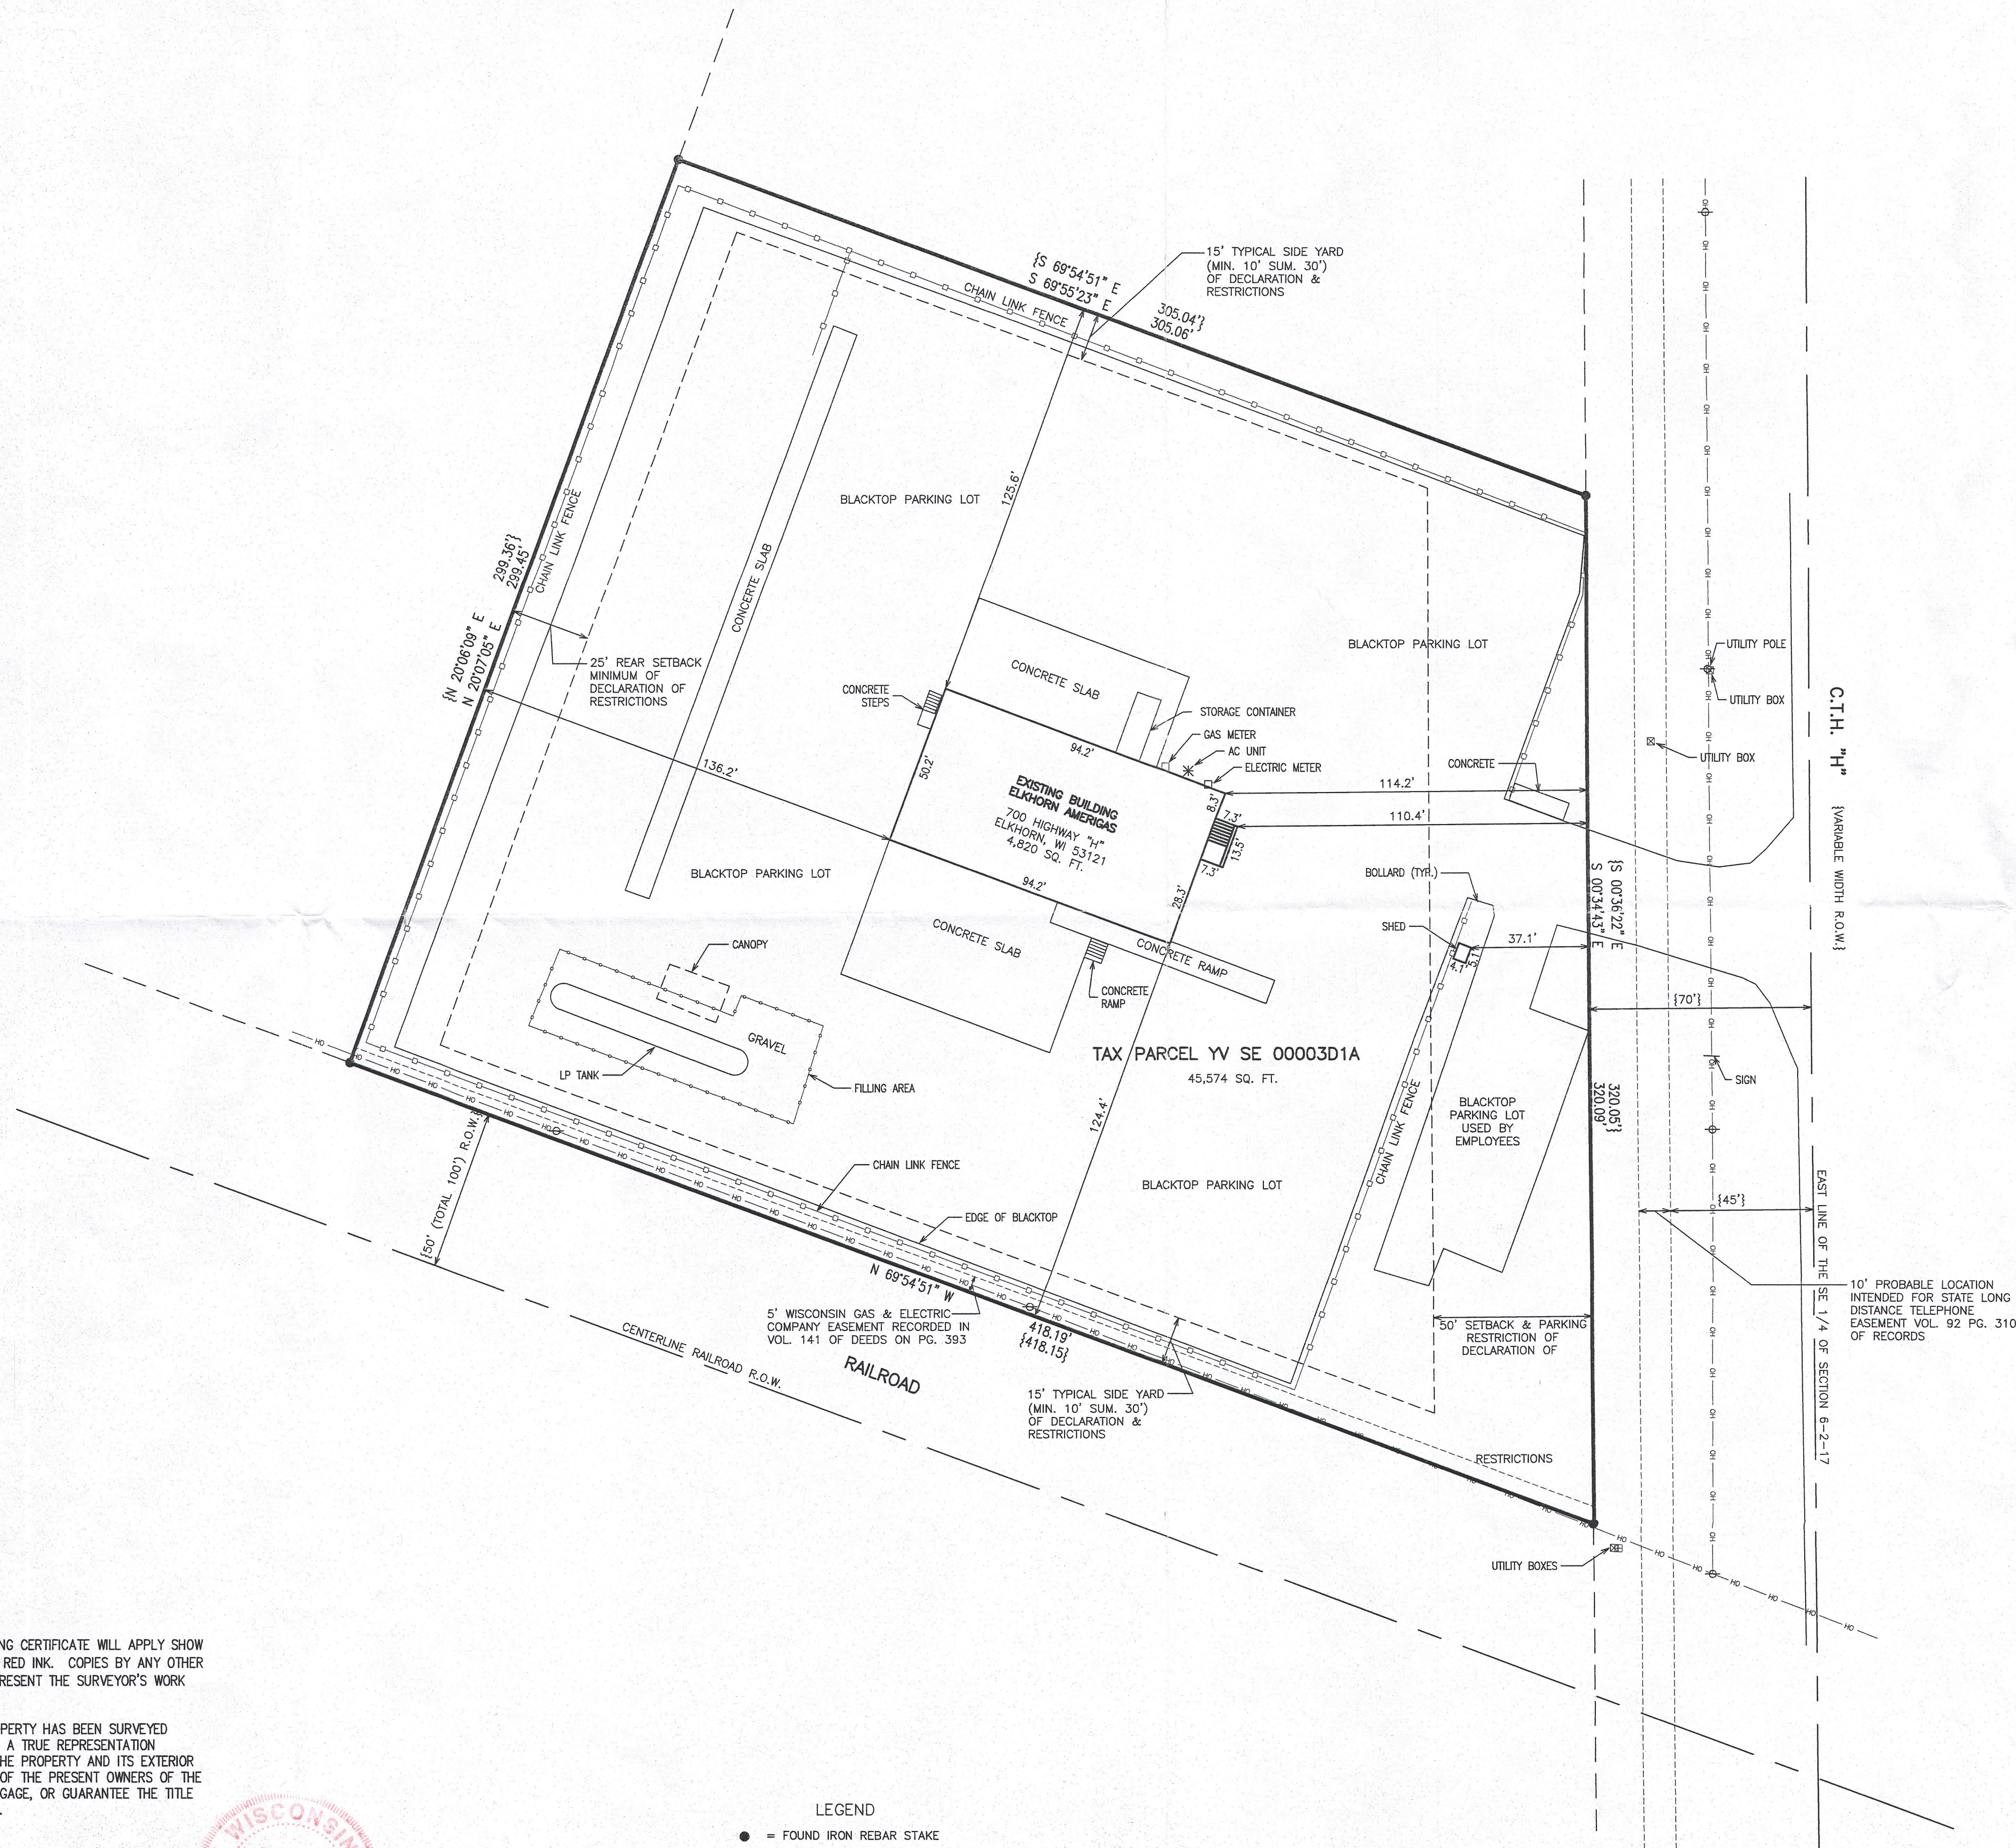


NOTE: COPIES OF THIS MAP TO WHICH THE FOLLOWING CERTIFICATE WILL APPLY SHOW
THE SURVEYOR'S ORIGINAL SEAL AND SIGNATURE IN RED INK. COPIES BY ANY OTHER
MEANS MAY HAVE ALTERATIONS WHICH DO NOT REPRESENT THE SURVEYOR'S WORK
PRODUCT.



I HEREBY CERTIFY THAT THE ABOVE DESCRIBED PROPERTY HAS BEEN SURVEYED
UNDER MY DIRECTION AND THAT THE ABOVE MAP IS A TRUE REPRESENTATION
THEREOF AND SHOWS THE SIZE AND LOCATION OF THE PROPERTY AND ITS EXTERIOR
BOUNDARIES. THIS SURVEY IS MADE FOR THE USE OF THE PRESENT OWNERS OF THE
PROPERTY, AND ALSO THOSE WHO PURCHASE, MORTGAGE, OR GUARANTEE THE TITLE
THERETO WITHIN ONE YEAR FROM THE DATE HEREOF.

DATED: JULY 27, 2015

Peter S. Gordon
PETER S. GORDON P.L.S. 2101

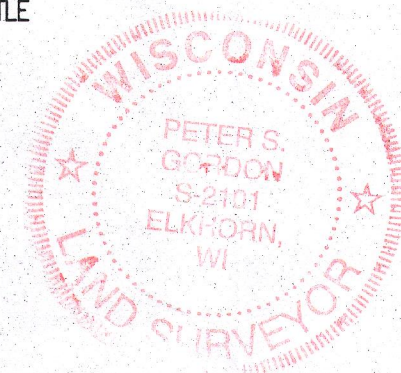

LEGEND
● = FOUND IRON REBAR STAKE
{XXX} = RECORDED AS

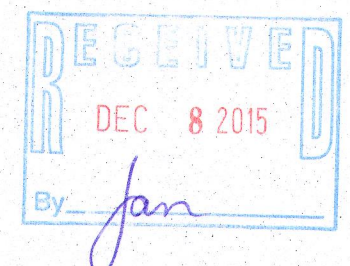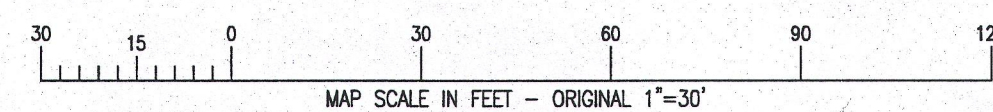

PLAT OF SURVEY

WORK ORDERED BY -
ARLIS REAL ESTATE
396 BELDEN AVENUE
GLENDALE HEIGHTS, IL 60131

FARRIS, HANSEN & ASSOCIATES, INC.
ENGINEERING - ARCHITECTURE - SURVEYING
7 RIDGWAY COURT P.O. BOX 437
ELKHORN, WISCONSIN 53121

REVISIONS

PROJECT NO.
3267.15

DATE
7/27/2015

SHEET NO.
1 OF 1