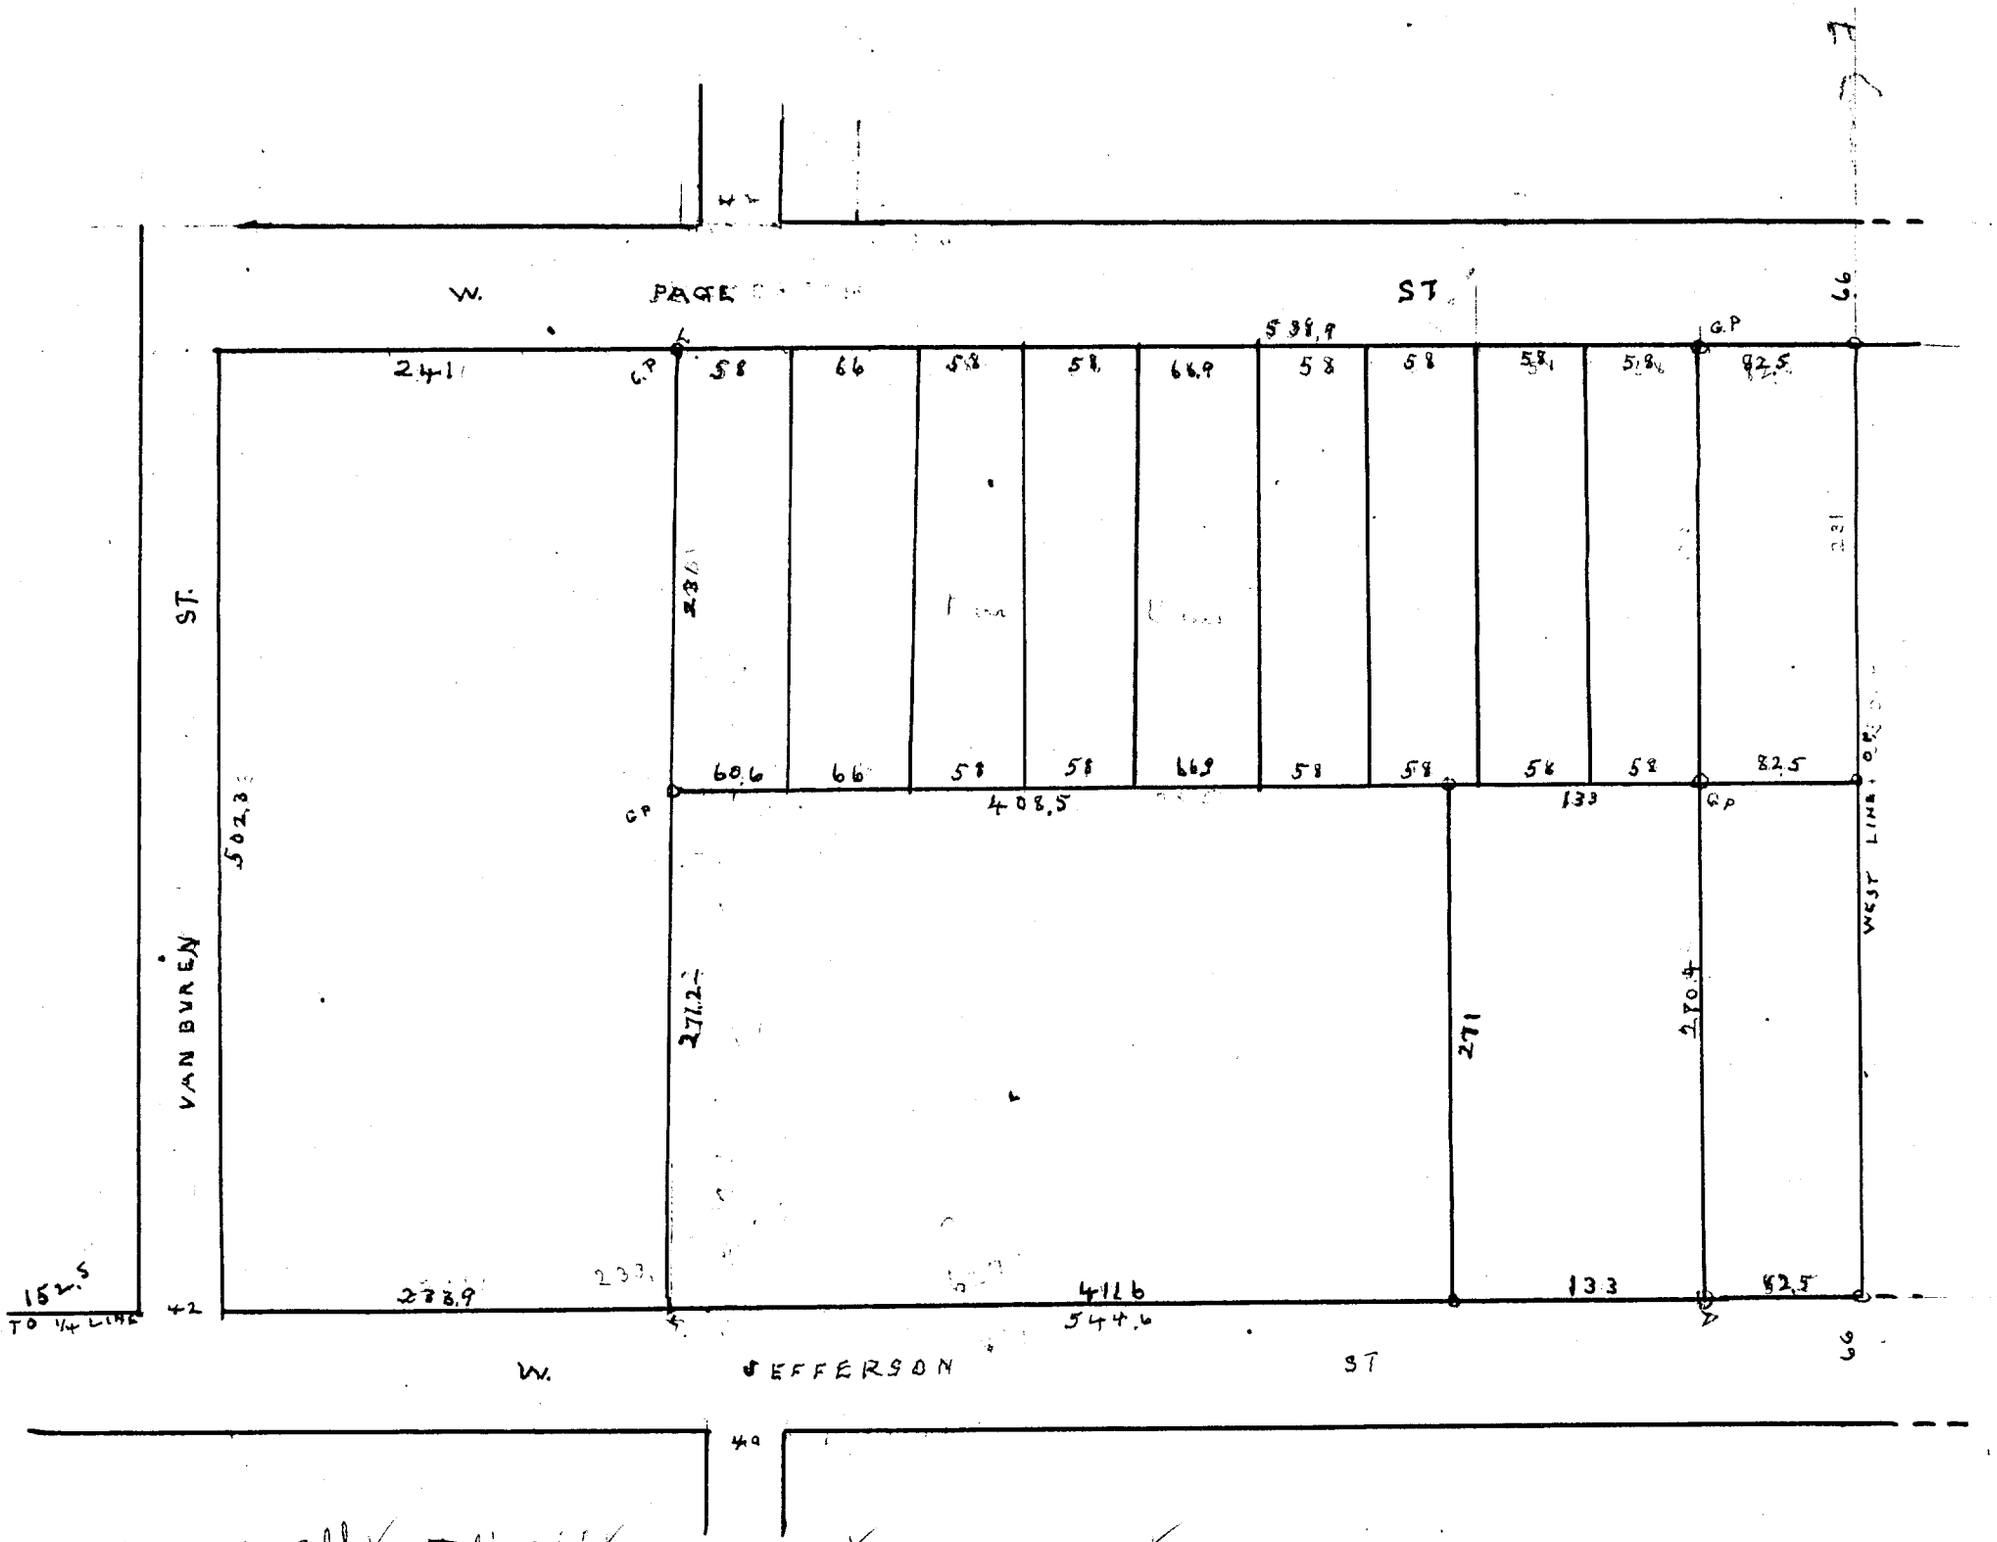

Jarvis Add. ✓ Fed's Add. ✓ U-NW 87 thru U-NW 93 ✓ Tubbs 4-25-T