

Oakwood Lane

(66' Wide)

recorded as(N0°06'35"E 208.04')
N0°05'00"E 208.11'

100.04'
(100.00')

recorded as(N0°05'12"E 911.20')
N0°05'00"E 910.89'

102.96'
(103.00')

599.82'
(600.00')

Culvert

Driveway

108.07'
(108.04')

MacLean Road

(66' Wide)

recorded as(S86°00'10"E 214.47')
S85°59'14"E 214.38'

recorded as(S86°02'30"E 428.98')
S85°59'14"E 428.76'

(214.49')
214.38'

Overhead Wires

Plat of Survey

of

Lots 1 & 2 of Certified Survey Map No. 2163,

recorded in Vol. 10 of Certified Survey Maps of Walworth County on Page 222
and located in the Northeast 1/4 of the Northwest 1/4 of Section 8, Town 2
North, Range 17 East, City of Elkhorn, Walworth County, Wisconsin.

Surveyed for: **Lynn Koonz**
1115 Oakwood Lane
Elkhorn, Wisconsin. 53121

Lot 1
C.S.M. 1737

Tax Parcel
YA216300001

0.985 Acre
42,910 Sq.Ft.

S89°59'26"E 213.94'
recorded as(S89°58'50"E 214.02')

Lot 2

S89°58'49"W 214.01'
recorded as(S89°58'50"E 214.06')

House


Lot 3
C.S.M. 2163

recorded as(S89°58'50"E 214.11')
S89°59'52"W 214.09'


6' Wide Utility Easement
As shown on Certified Survey Map No. 2163

S0°02'29"W 193.03'
recorded as(S0°05'00"W 193.16')

6' Wide Utility Easement
As shown on Certified Survey Map No. 1737

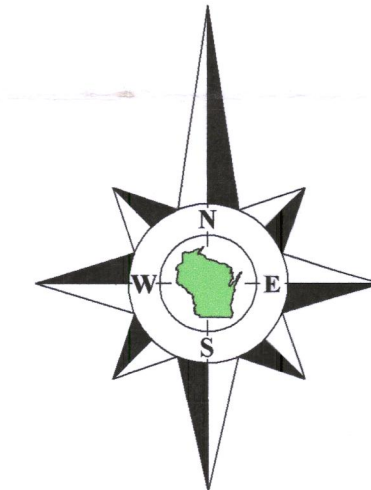

Bearings referenced to the East line of Oakwood Lane,
recorded as N0°05'E on the plat of Oakwood Subdivision.

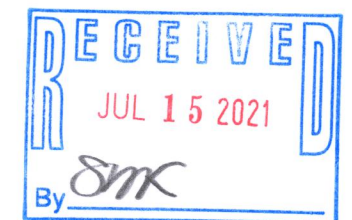

Notes:

- 1) This Plat of Survey is not certified unless signed and sealed in red ink.
- 2) This survey is subject to Wisconsin lien laws. This Plat of Survey is the notice of intent to file lien. Lien waiver required.
- 3) The Survey Date shown on this Plat of Survey is the completion date of the field work.

Lot 2
C.S.M. 1737

Copyright ©2021 by Olson Land Surveying, LLC.


All rights reserved. No part of this survey plat may be reproduced or transmitted in any form by any means - graphic, electronic, or mechanical, including photocopying, tracing, or information storage and retrieval systems - without permission in writing from Douglas G. Olson, Olson Land Surveying, LLC.

I hereby certify that I have surveyed the above described property in compliance with Chapter A-E 7 of the Wisconsin Administrative Code and that the map hereon is correct to the best of my professional knowledge and belief and shows the size and location of the property, its exterior boundaries, the location and dimensions of all visible structures thereon, boundary fences, apparent easements and roadways and visible encroachments, if any.

This survey is made for the exclusive use of the present owners of the property, and also those who purchase, mortgage or guarantee title thereto, within one year from the date hereof.

Douglas G. Olson
Wisconsin Professional Land Surveyor - 2093

Survey Date: June 3, 2021.
Revisions:

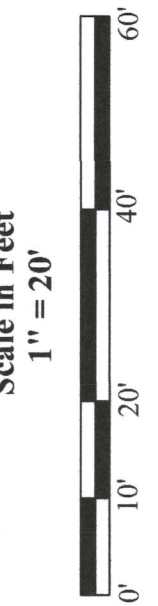

45 South Wisconsin Street | P.O. Box 322
Elkhorn, Wisconsin. 53121
Telephone: (262) 723-3434
Facsimile: (262) 723-8044
Email: doug@olsonsurveying.com
Website: www.olsonsurveying.com

OLSON
LAND SURVEYING, LLC
Rural | Residential | Commercial

Legend of Symbols & Abbreviations
North Arrow
Found Iron Rod, 1-3/16" dia.
Found Iron Rod, 1-1/16" dia.
