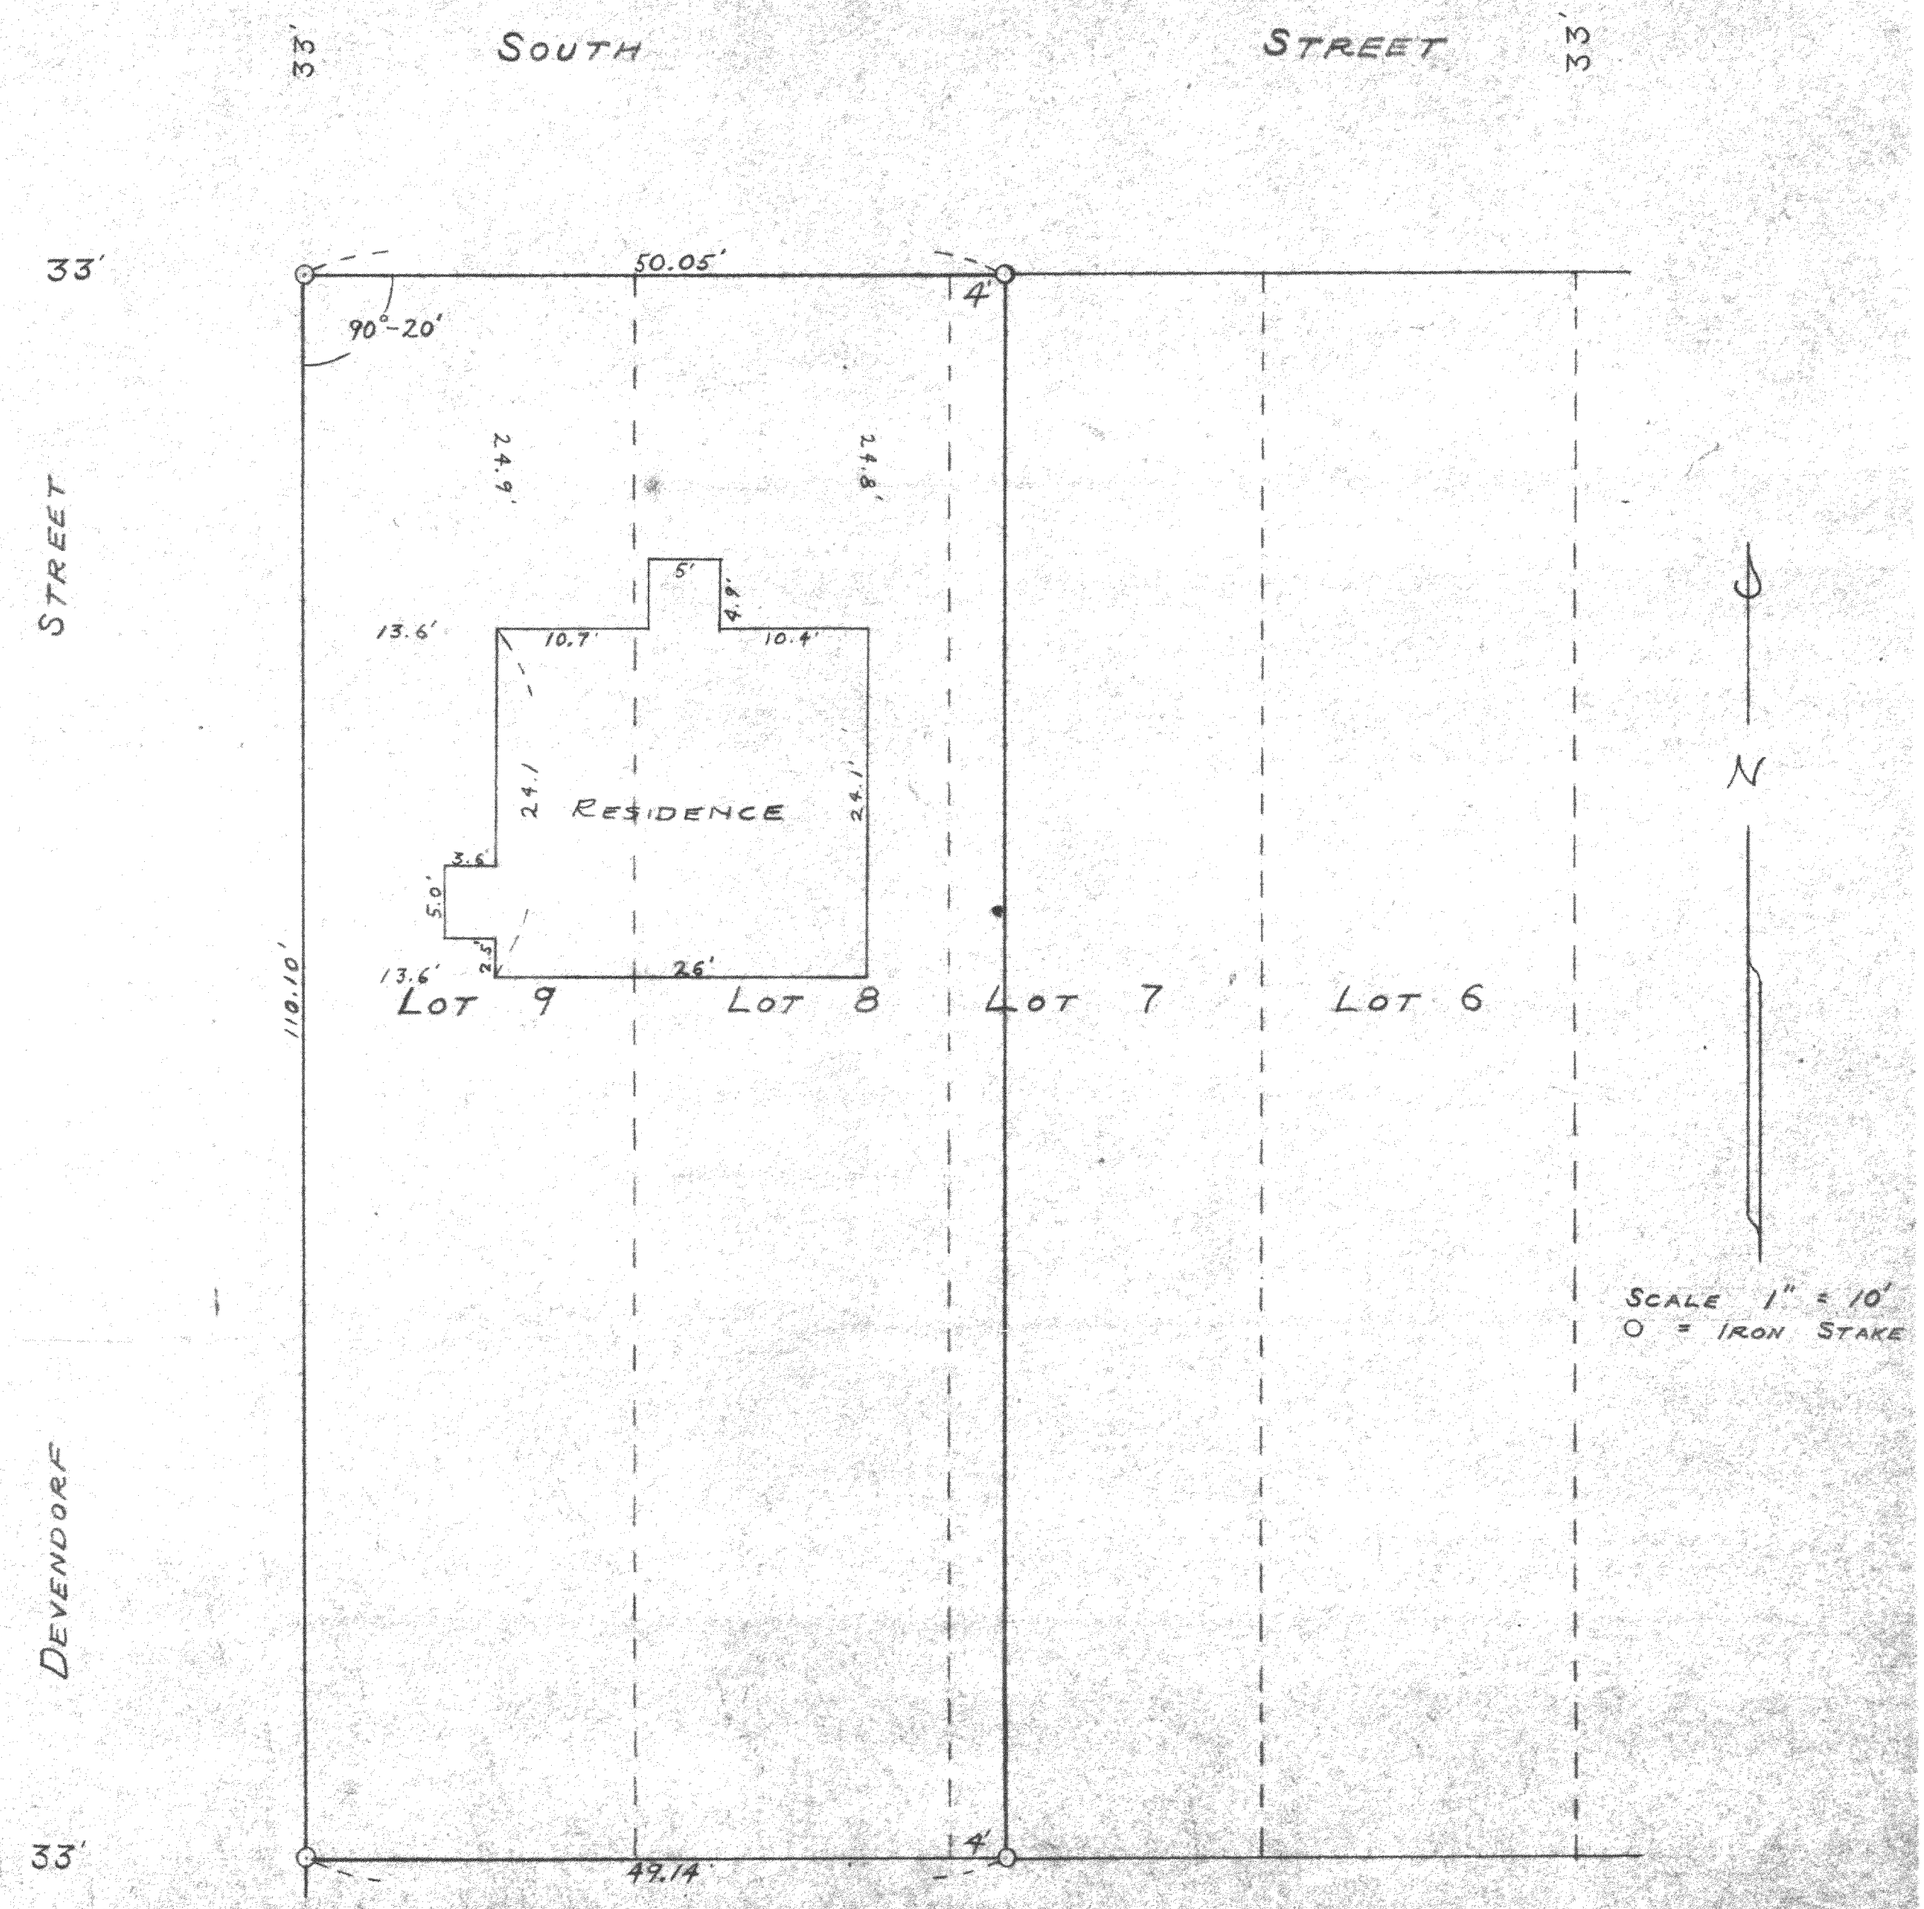

YEN-17C

PLAT OF SURVEY OF THE WEST 4' OF LOT 7 AND LOTS 8 AND 9, BLOCK 3 IN ELKHORN GARDENS; LOCATED IN THE CITY OF ELKHORN WALWORTH COUNTY, WISCONSIN
APRIL 3, 1952

Floyd L. Jensen
COUNTY SURVEYOR

4-32