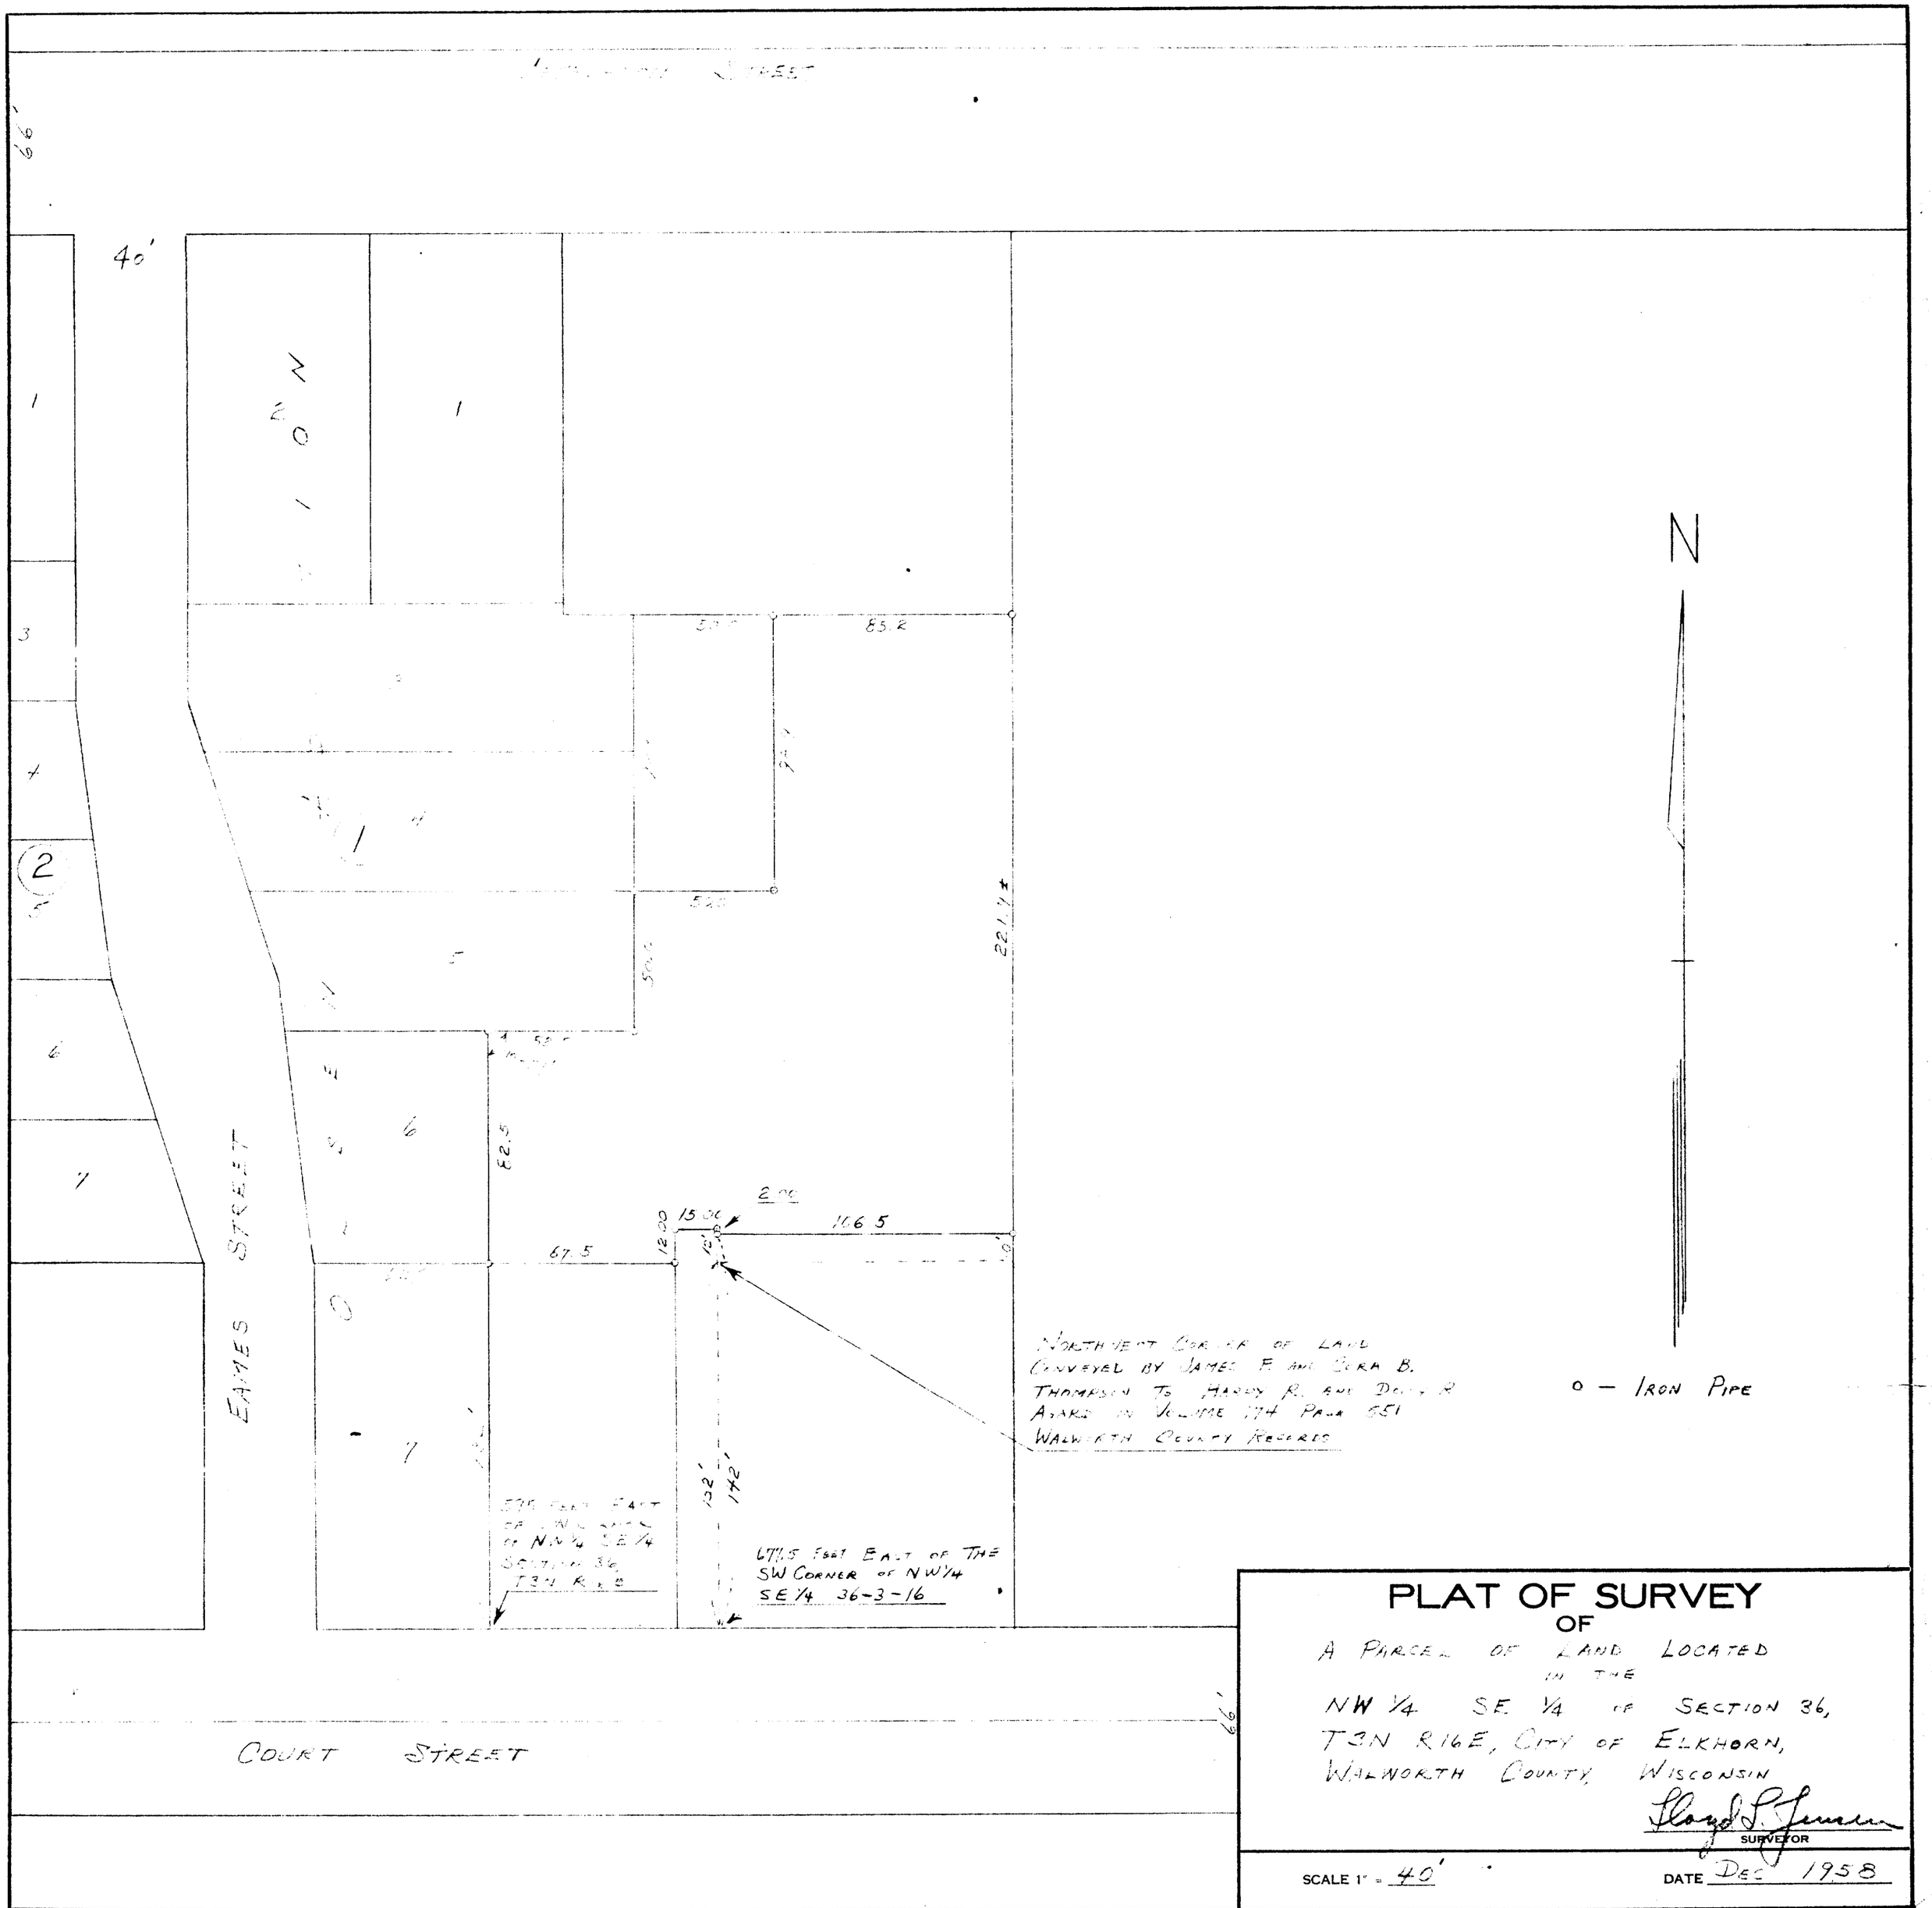

NO 175H—400—1-30-58

U-NW-105 + 106 + on Misc card Olsen's Add

4-45J