


$\phi\phi 4 = 770$

NOTED

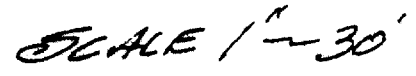

BY: DENISE SURVEYING & MAPPING S.C.
E.L.K. 6/15. 1992.100