ABERNATHY and ASSOCIATES
Kenneth B. Abernathy Jr.
Wisconsin Registered Land Surveyor S-1594

W4056 Bray Road
Elkhorn, Wisconsin 53121
Phone: (414) 723-4260 (office)
(414) 723-4813 (residence)

PLAT OF SURVEY

Lot 9 of Block 3 of Edgewood 2nd Addition Subdivision, located in the West 1/2 of the Northeast 1/4 of Section 36, Town 3 North, Range 16 East, City of Elkhorn, County of Walworth, State of Wisconsin.

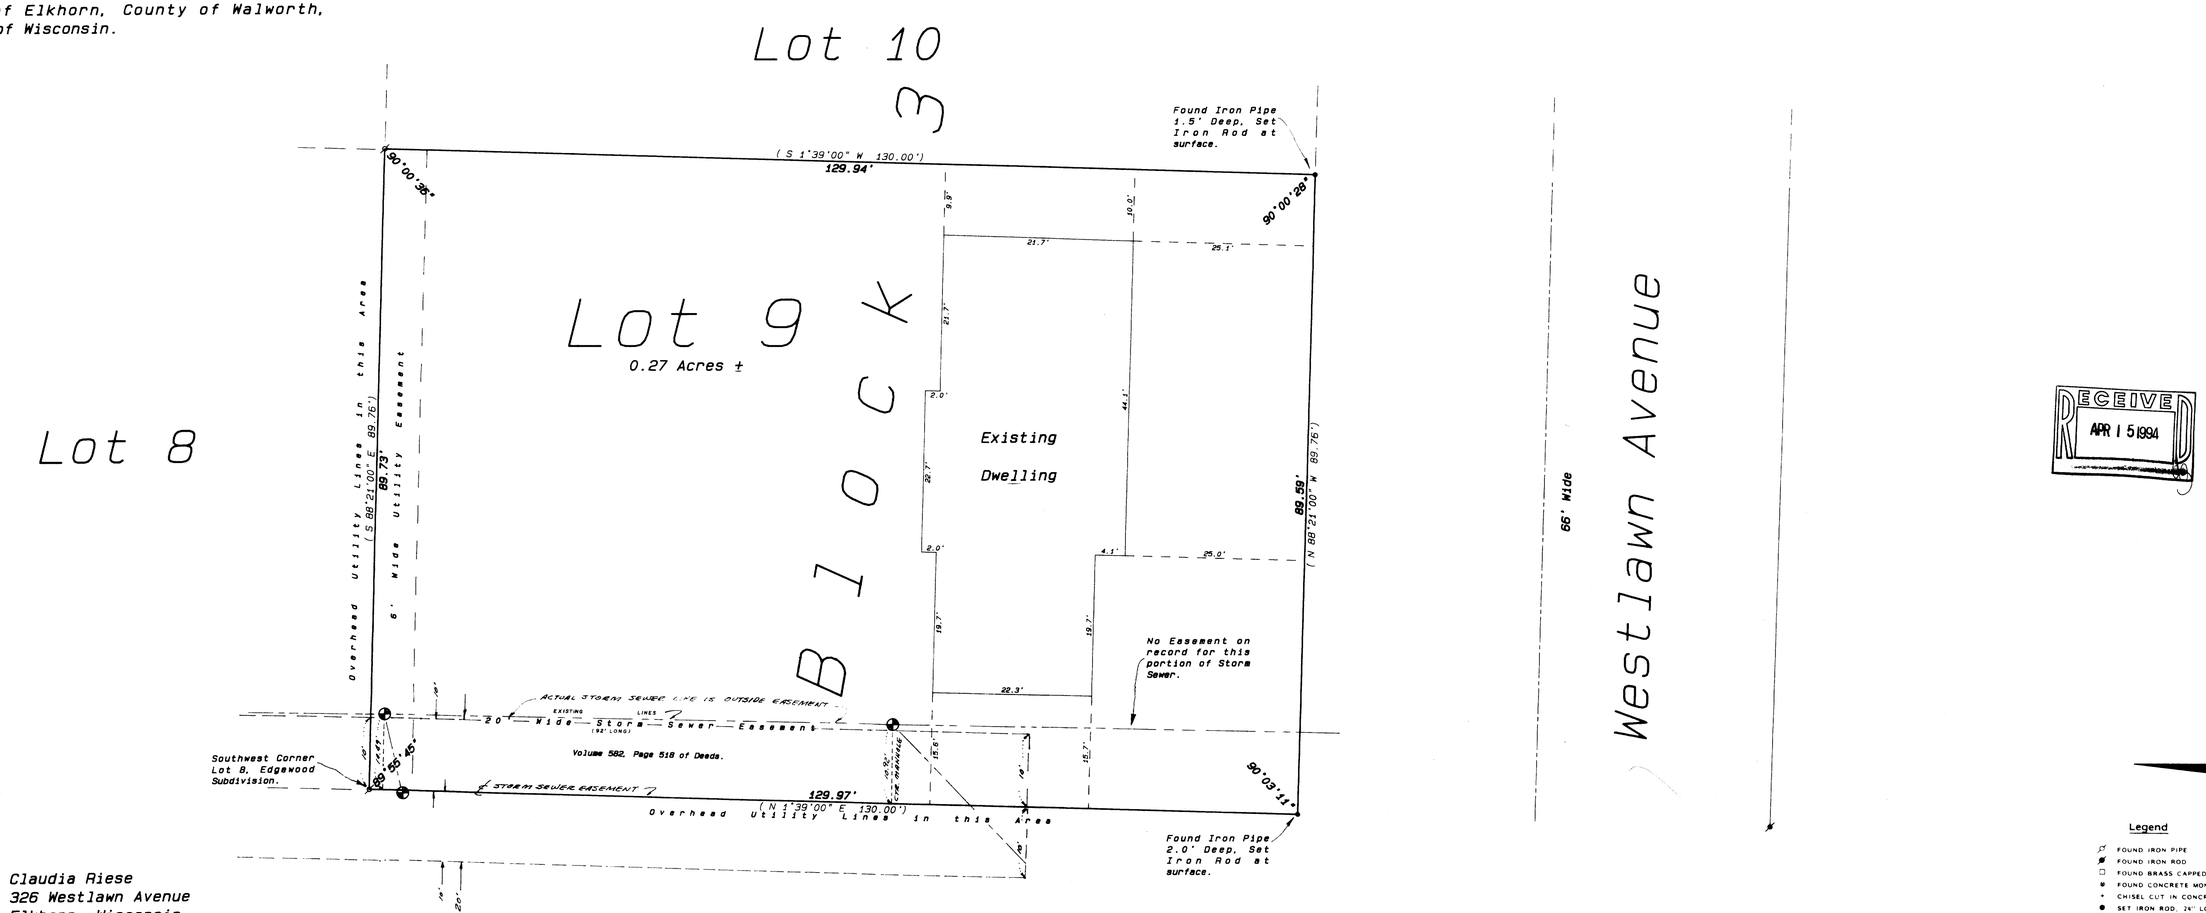

RECEIVED
APR 15 1994

Owner: Claudia Riese
326 Westlawn Avenue
Elkhorn, Wisconsin
53121

Ordered by: Van Brown Jr.
Corner Realty
228 Amos Road
Elkhorn, Wisconsin
53121

Legend

- FOUND IRON PIPE
- FOUND IRON ROD
- FOUND BRASS CAPPED MONUMENT
- FOUND CONCRETE MONUMENT
- CHISEL CUT IN CONCRETE
- SET IRON ROD, 24" LONG, WEIGHING 1.5 LBS./LINEAL FT., 3/4" DIA.
- SET IRON ROD, 30" LONG, WEIGHING 4.5 LBS./LINEAL FT., 1-11/16" DIA.
- (xx)' RECORDED AS DIMENSION
- EXISTING FENCE
- STORM SEWER MANHOLE

SCALE: 1"= 10 FEET

I hereby certify that the above described property has been surveyed by me or under my direction and that the above map is a true representation thereof and shows the size and location of the property, its exterior boundaries, the location of all visible structures and dimensions of all principal buildings thereon, boundary fences, apparent easements, roadways and visible encroachments, if any.
This survey is made for the use of the present owners of the property, and also those who purchase, mortgage, or guarantee the title thereto within one year from date hereof.

KENNETH B. ABERNATHY, JR.
WISCONSIN REGISTERED LAND SURVEYOR, S-1594
REVISED 8-24-93
Date: August 17, 1993 Job No. 1993.806

DESIGN PRODUCTS

Yeff 2-1

4-851