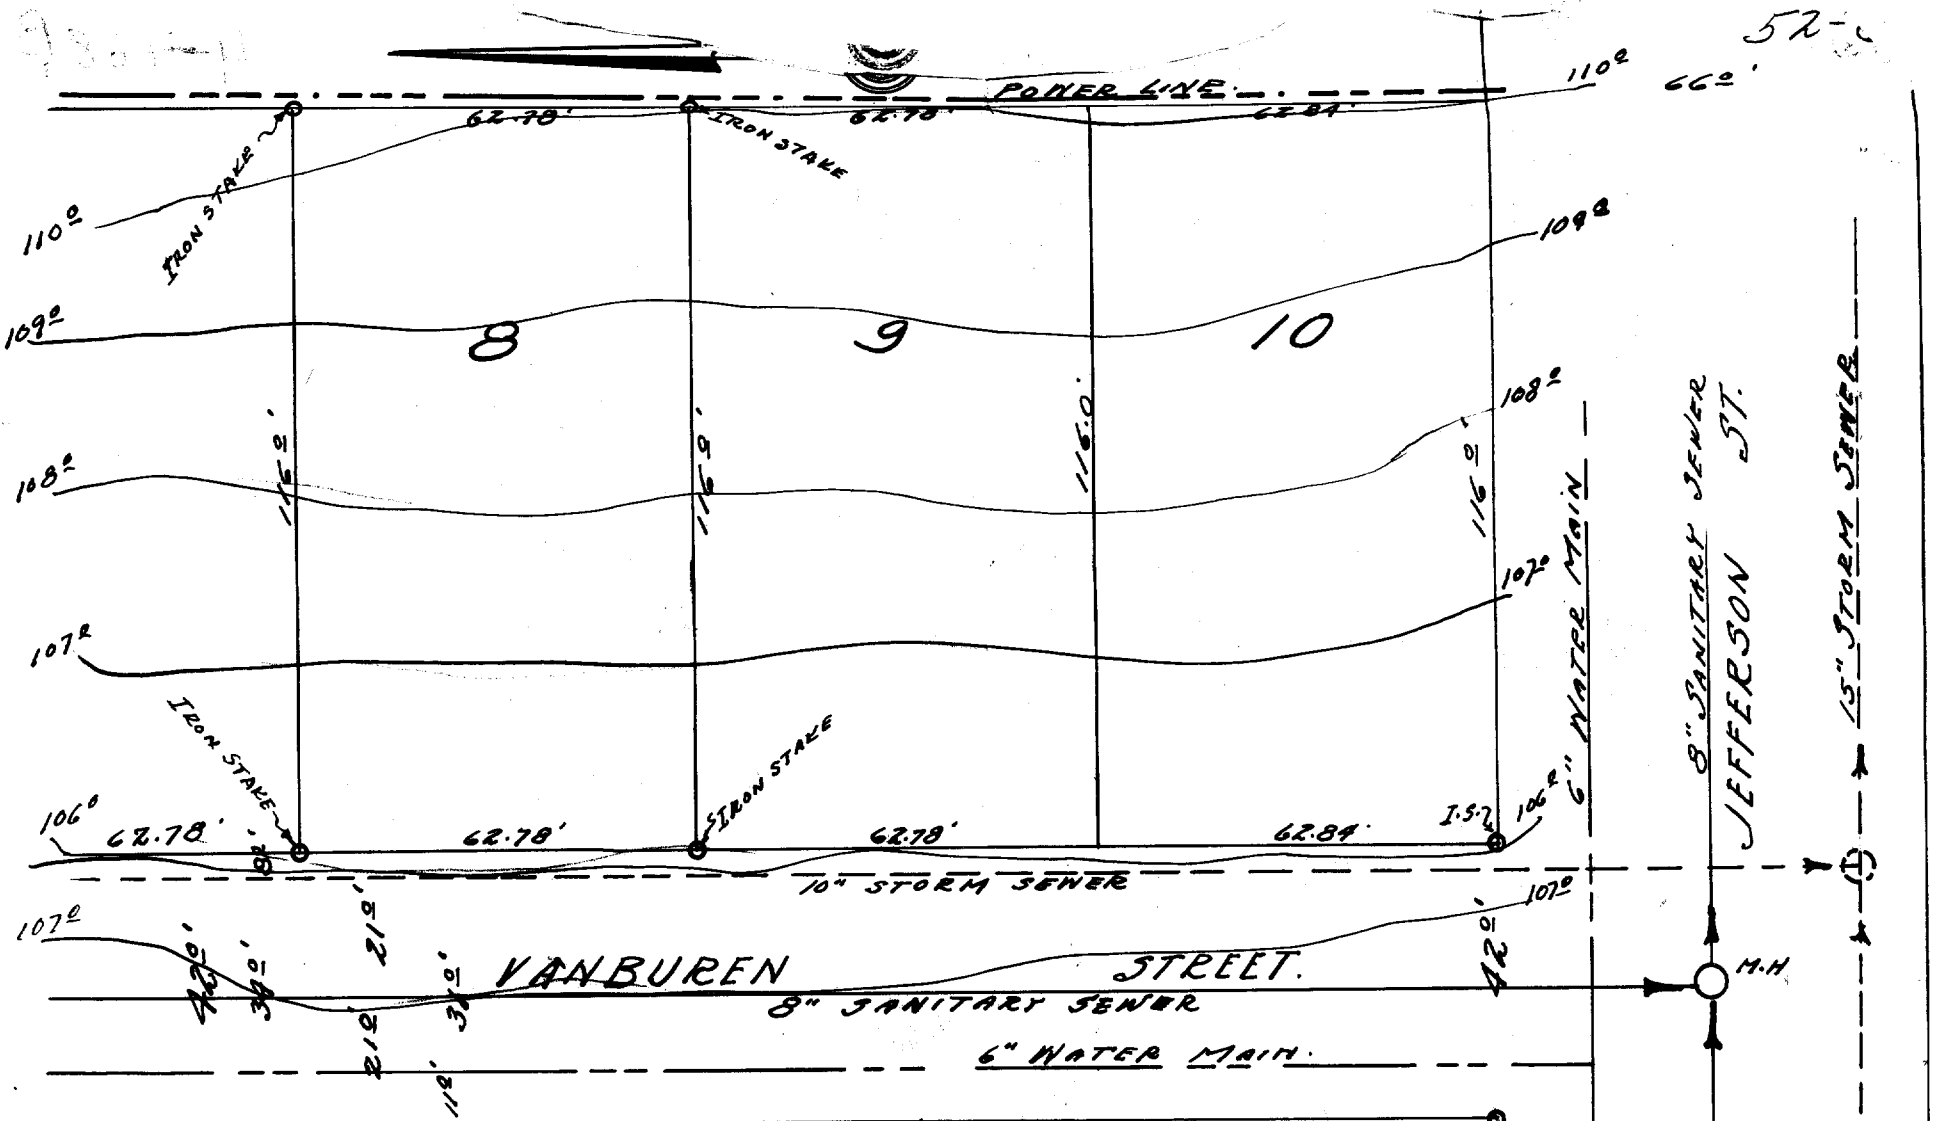

DESCRIPTION:

Lot 8, Ted's Addition to the City of Elkhorn
Walworth County, Wisconsin.

CERTIFICATE:

I, hereby certify that I have on this the 17th day of June 1952, surveyed the above described property according to the official plat on file in the office of the Recorder of Deeds in and for Walworth County, Wisconsin, and find that the measurements and bearings of the boundary lines of said property as taken at the site on this day substantially agree with those in said official plat, and that as shown on the above portrayed plat, no excavation, building, sidewalk, alley, drive, or curbs and gutters are in evidence on said lot, and that no encroachments exist.

SIGNED AND SEALED ON THIS THE 18TH DAY OF JUNE 1952

Joseph M. Biagi. Professional Engineer.
Elkhorn Wisconsin.

YTA-8

4-168B