#160-65

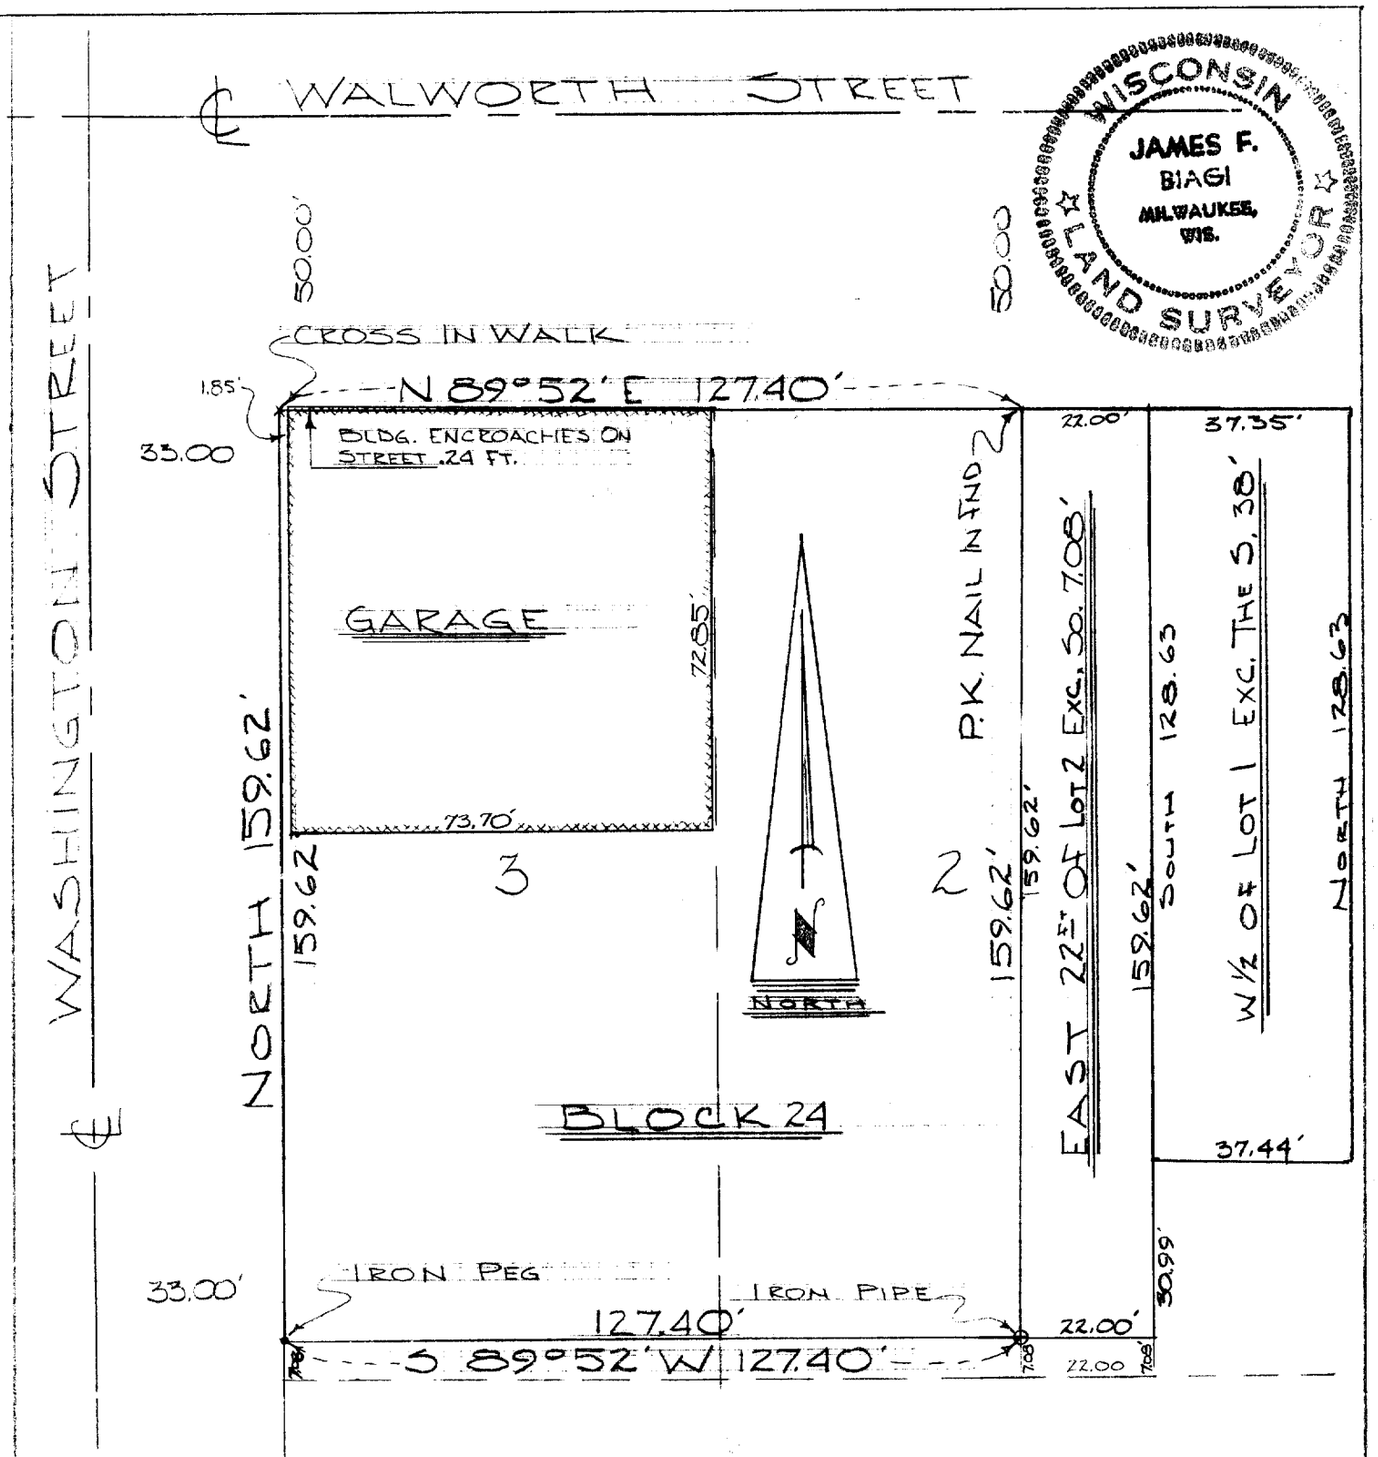


DESCRIPTION: Lots 2 and 3 of Block 24, except the East 22.00 feet of Lot 2 and the South 7.08 feet of lots 2 and 3, located in Block 24 of the Original Plat of the City of Elkhorn, Walworth County, Wisconsin. Also the East 22.00 feet of Lot 2 except the South 7.08 feet and the west ½ of Lot 1 except the South 38.00 feet, all in Block 24.

CERTIFICATE: I hereby certify that I have surveyed the property hereon described.

James F. Biagi, RLS 272

December 13, 1965.

4-129B

PP-180