168 - 67

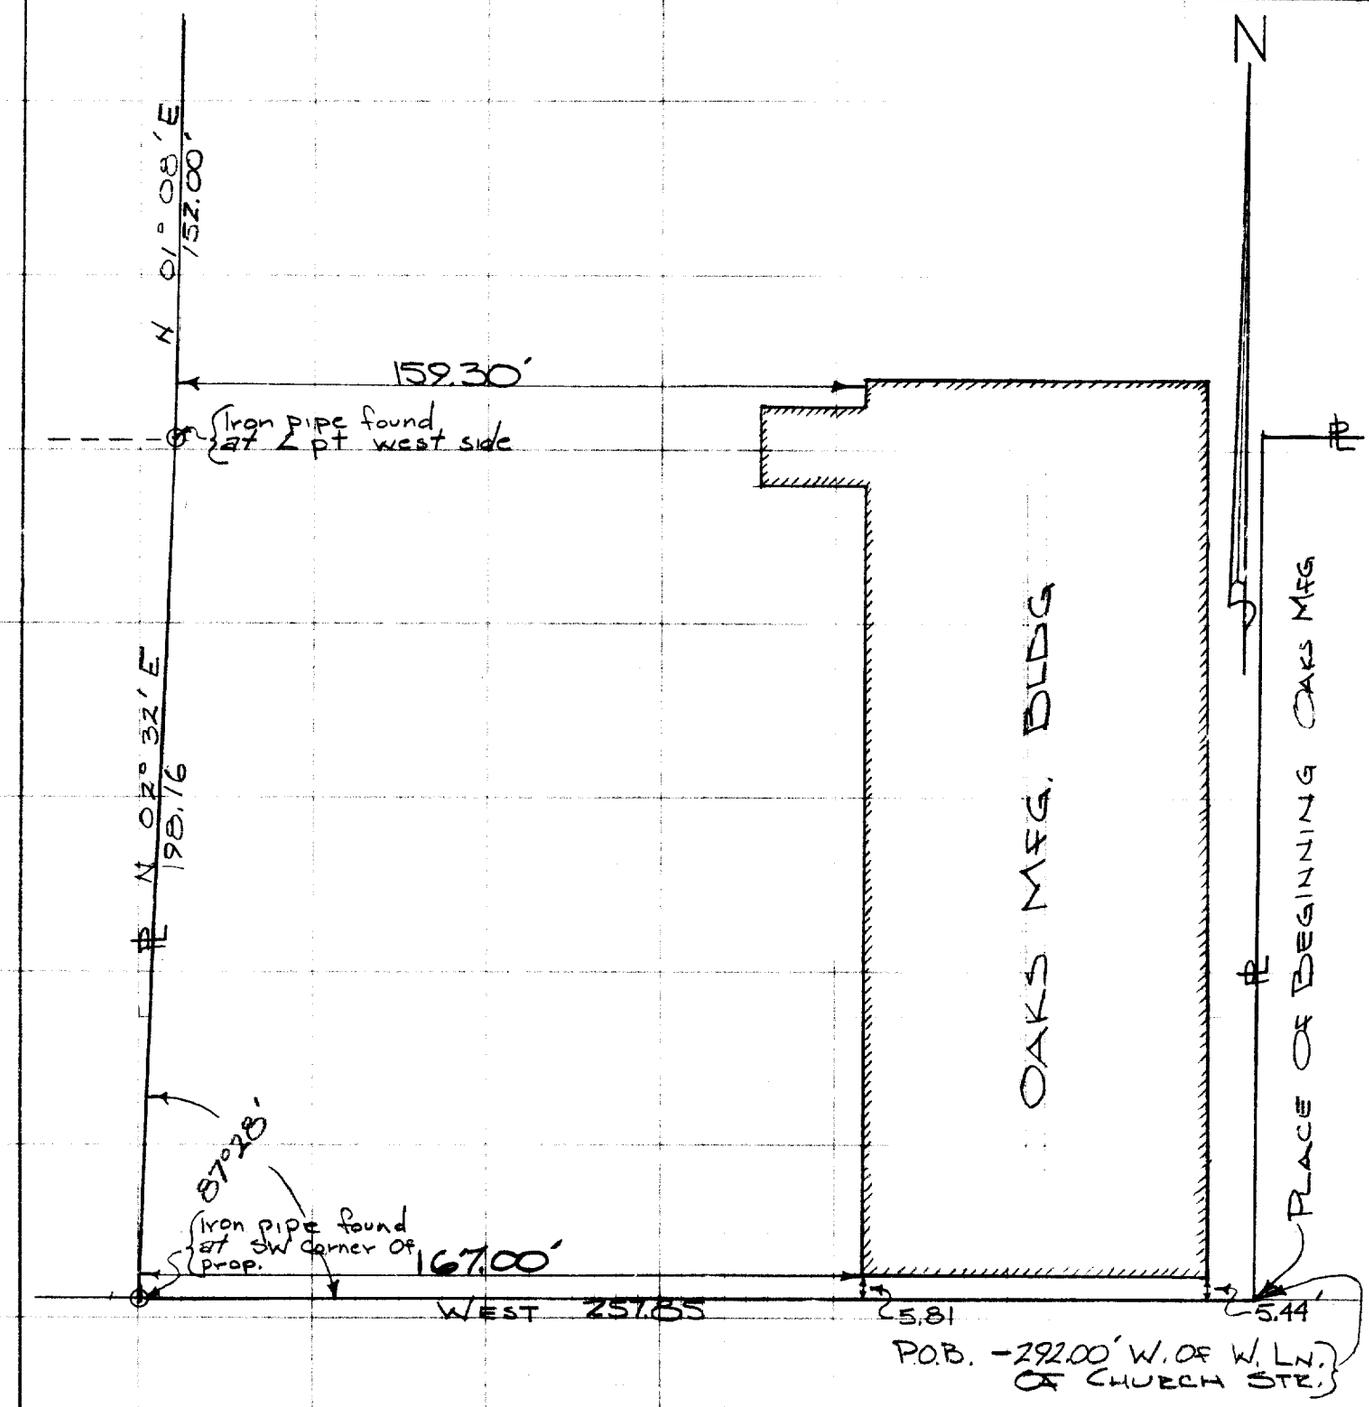

SURVEYORS CERTIFICATE: I, James F. Biagi, surveyor, do hereby certify that the location of the Oaks Manufacturing building is located as shown on the plat hereon with regard to the west line of said property as is now monumented in the field.

November 2, 1967.

James F. Biagi

WISCO
JAMES F. BIAGI
MILWAUKEE, WIS.
LAND SURVEYOR

U-SW-46I (part of)

4-183B