


PLAT OF SURVEY

Survey No. 16-5181

December 2, 2016

LOCATION: 409 Broad Street, City of Elkhorn , Wisconsin
PREPARED FOR: Keefe Real Estate, Inc.
RECORDED LEGAL DESCRIPTION (taken from Warranty Deed, Doc. No. 837035):
Lot 7 in Block 40 of Davis Addition to the City of Elkhorn, Walworth County, State of Wisconsin.
SUGGESTED LEGAL DESCRIPTION (Due to apparent typos in the Record Description):
Lot 7 in Block 40 of Davis' Addition to the Village of Elkhorn, according to the recorded plat thereof and located in the East
1/2 of the NE 1/4 of Section 36, Town 3 North, Range 16 East, City of Elkhorn, Walworth County, State of Wisconsin.

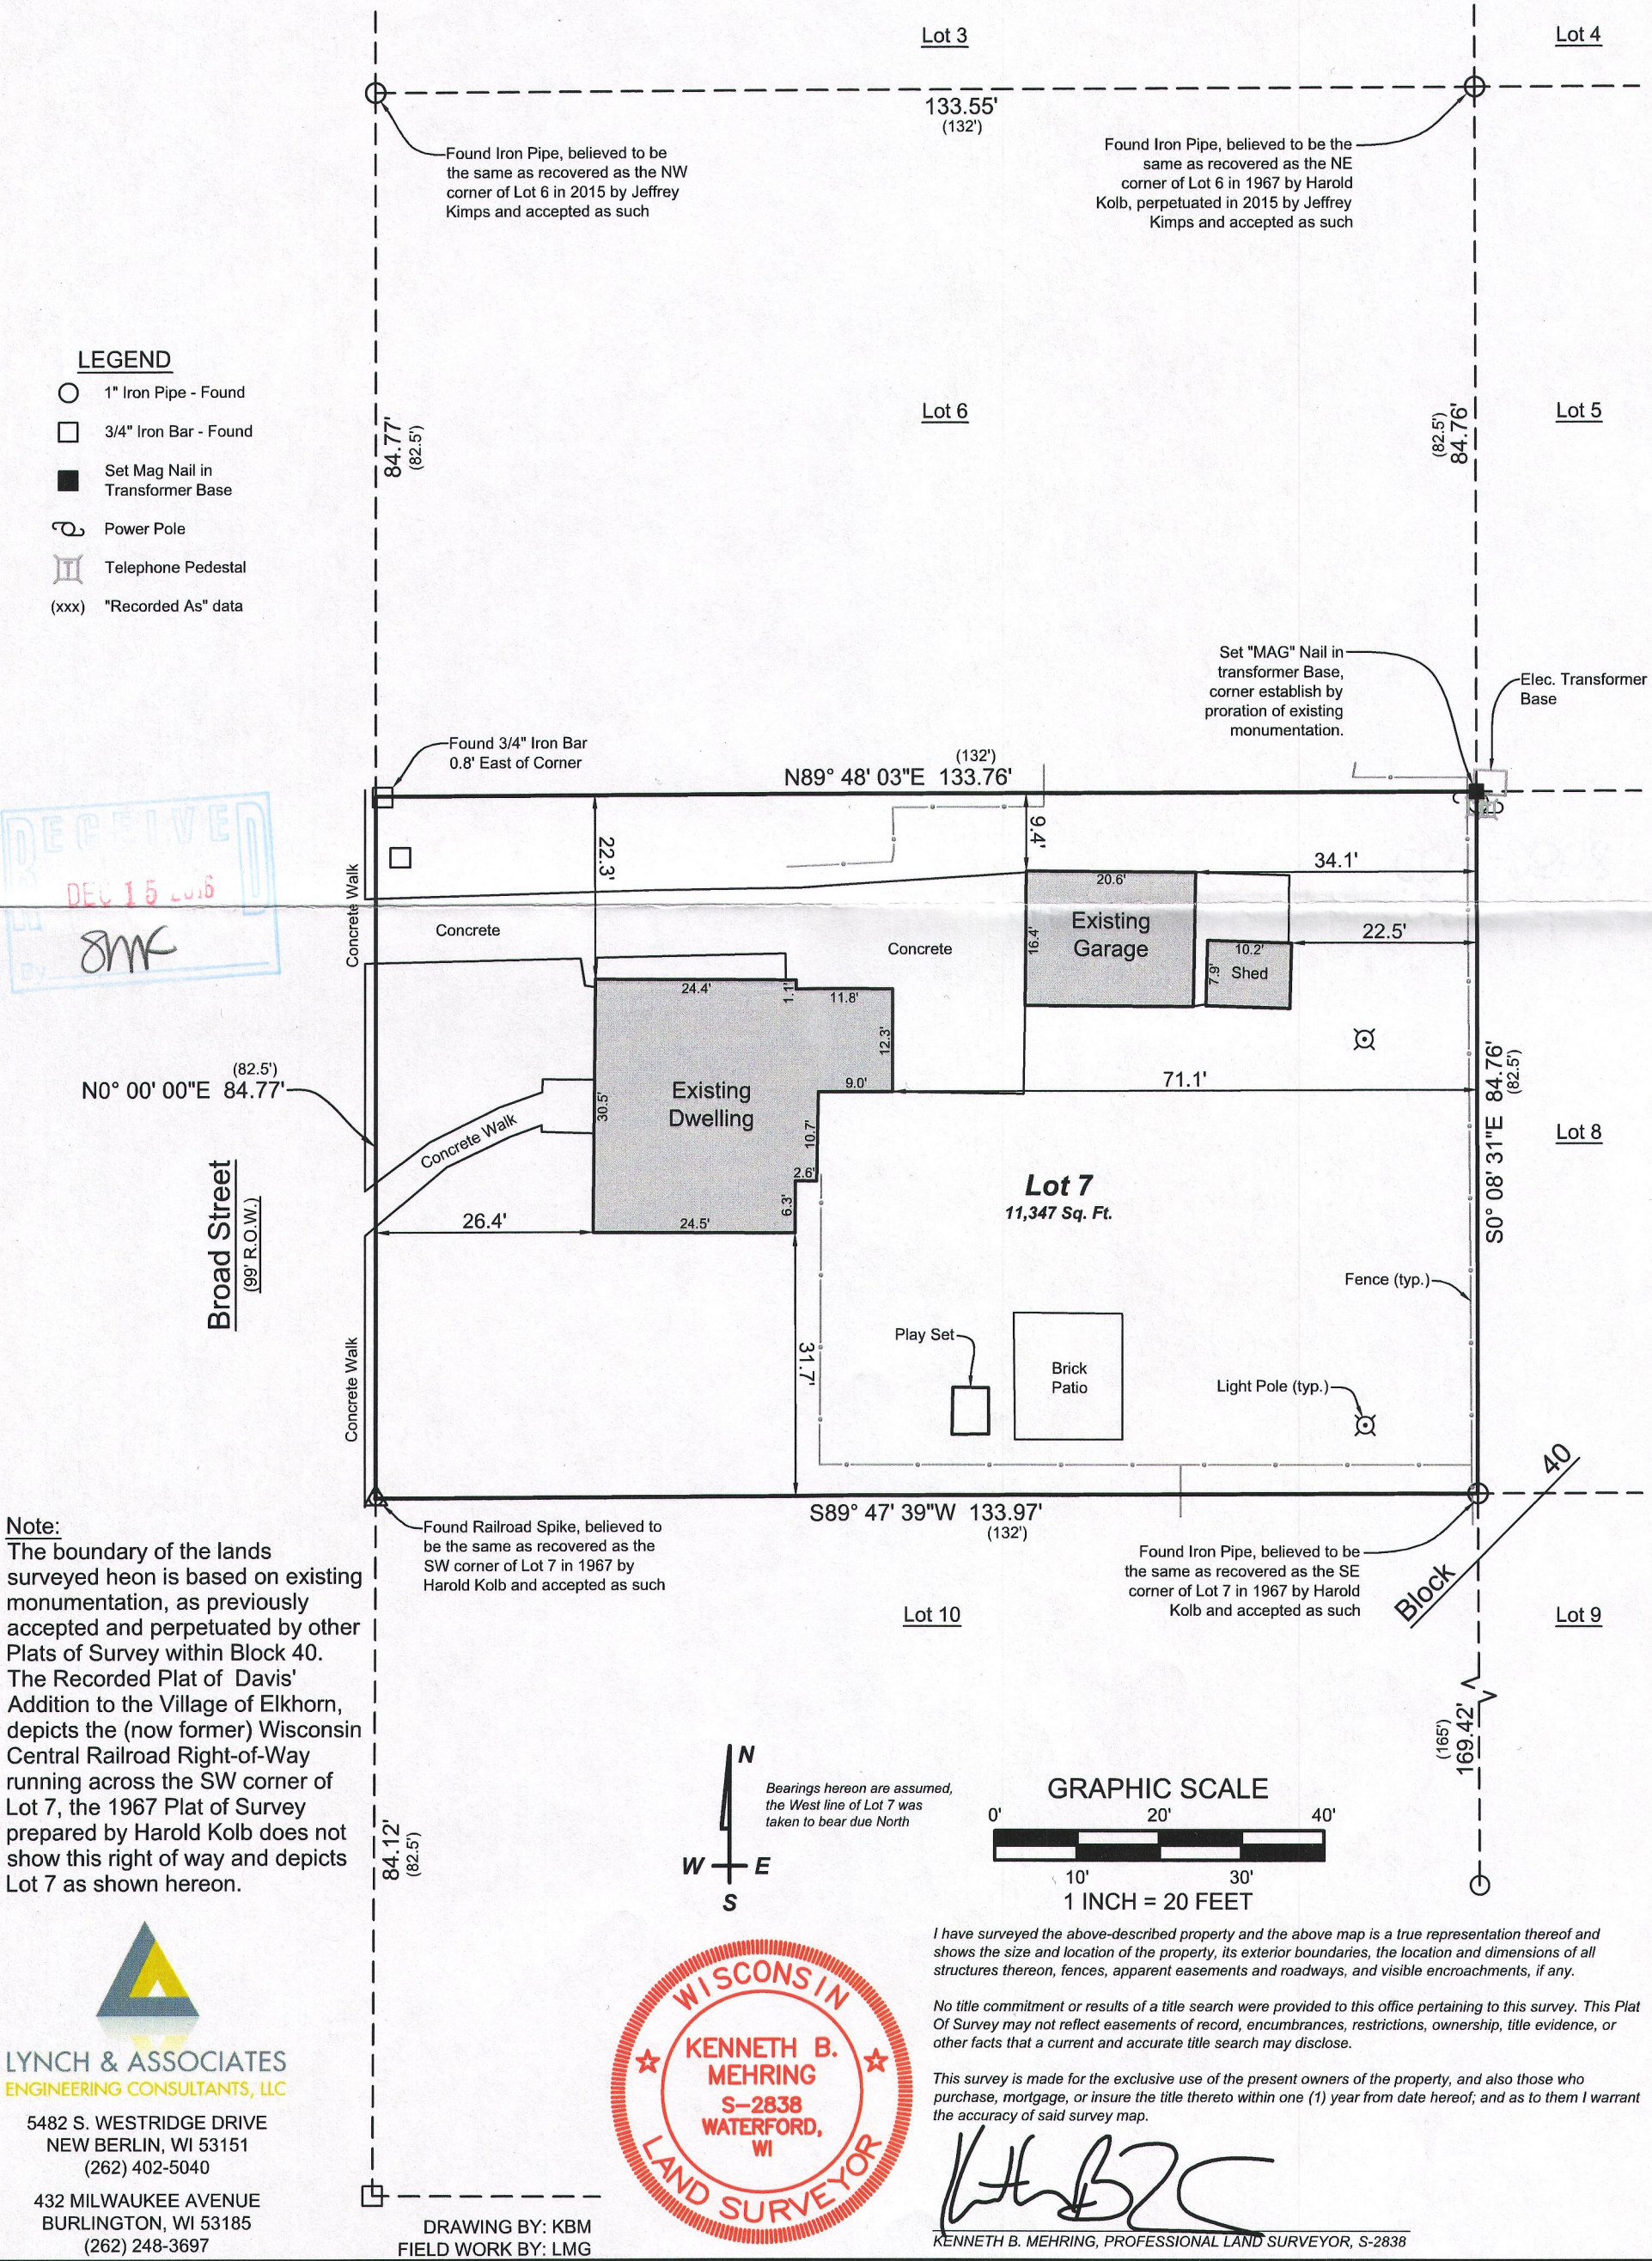

YD-36

004-2558