PREPARED FOR
LEAH GETZEN

PLAT OF SURVEY

- OF -

LOT 17, ADLER SUBDIVISION, RECORDED IN CABINET C OF PLATS, ON SLIDE 20 AS DOCUMENT No. 406650 AT THE WALWORTH COUNTY REGISTER OF DEEDS, LOCATED NW 1/4, SW 1/4 AND SE 1/4 OF THE NW 1/4 OF SECTION 36, TOWN 3 NORTH, RANGE 16 EAST IN THE CITY OF ELKHORN, COUNTY OF WALWORTH AND STATE OF WISCONSIN.

PATHFINDER SURVEYING INC.
(formerly)
J.K. SURVEYING INC.
P.O BOX 322
LAKE GENEVA, WI. 53147
WWW.PATHFINDERSURVEYING.NET
262-248-8303

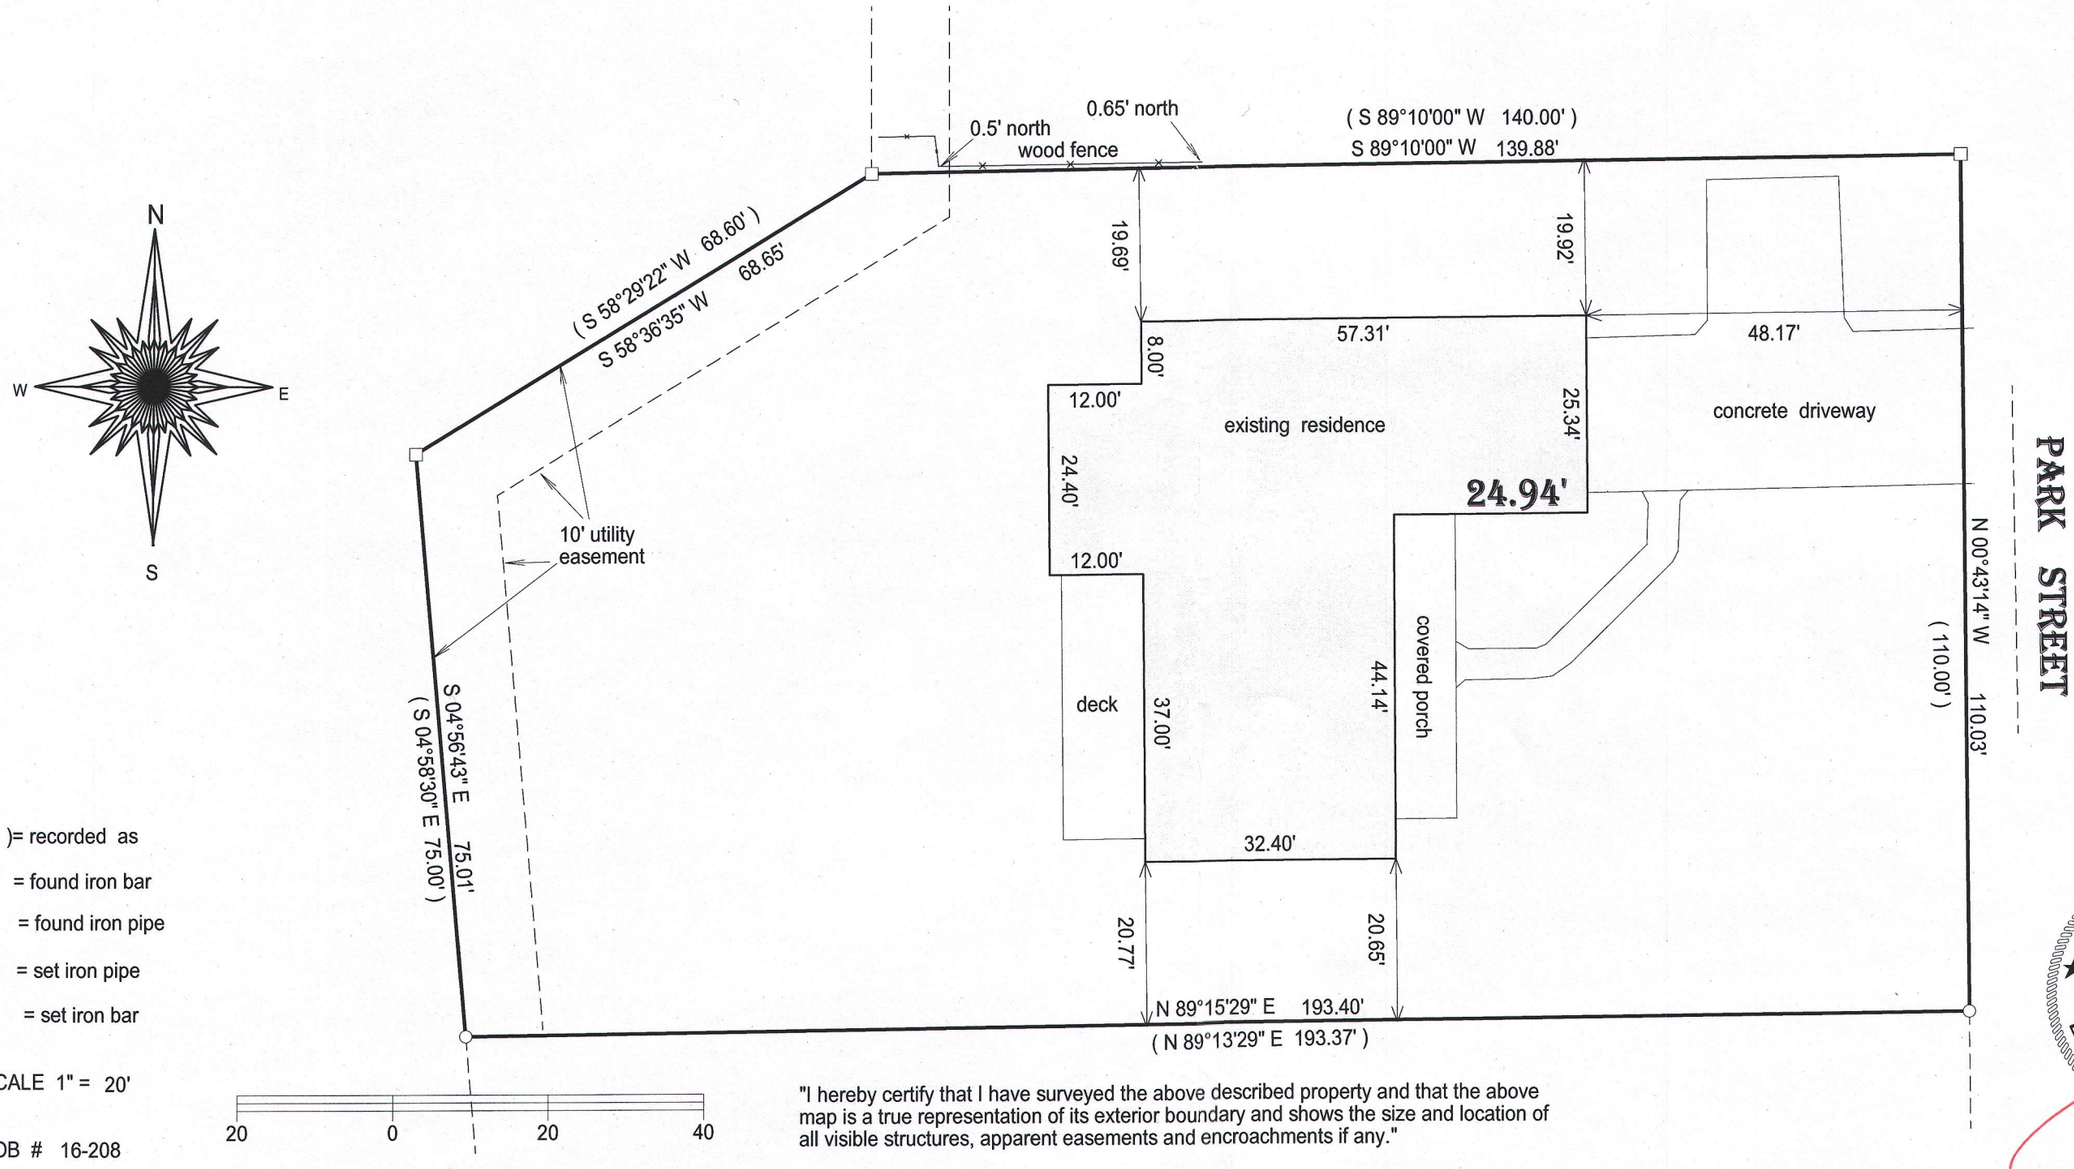

( )= recorded as

□ = found iron bar

○ = found iron pipe

● = set iron pipe

■ = set iron bar

SCALE 1" = 20'

JOB # 16-208

TAX ID #
YALD 00017

BASIS OF BEARING OF THIS PLAT: THE SUBDIVISION PLAT OF RECORD.

"I hereby certify that I have surveyed the above described property and that the above map is a true representation of its exterior boundary and shows the size and location of all visible structures, apparent easements and encroachments if any."

This survey is made for the present owners of the property, and those who purchase, mortgage, or guarantee the title thereto, within one year from the date hereof.

DATED THIS 11TH DAY OF JULY, 2016.

RECEIVED
JAN 18 2017
BY Jan

WISCONSIN
JEFFREY L. KIMPS
S-2436
LAKE GENEVA. WIS.
LAND SURVEYOR

JEFFREY L KIMPS S - 2436
Wisconsin Professional Land Surveyor
(original if signed in red)

YALD-17 004-2566