


Plat of Survey

of




Lots 7 & 8 in Block 2 of Hodge's Addition to the Village (now City) of Elkhorn,

a subdivision located in the Northwest 1/4 of the Northeast 1/4 of Section 1, Town 2 North, Range 16 East, City of Elkhorn, Walworth County, Wisconsin.

Surveyed for: Eric Jones
511 South Lincoln Street
Elkhorn, Wisconsin. 53121

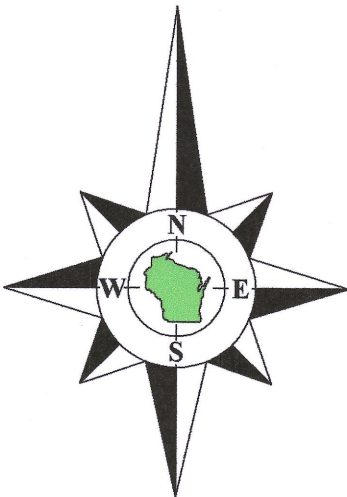

Bearings referenced to the North line of James Jones Addition, recorded as N 89°22' E.

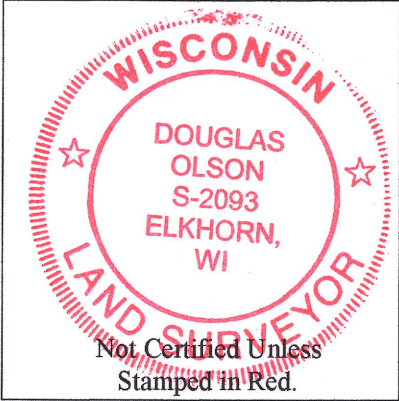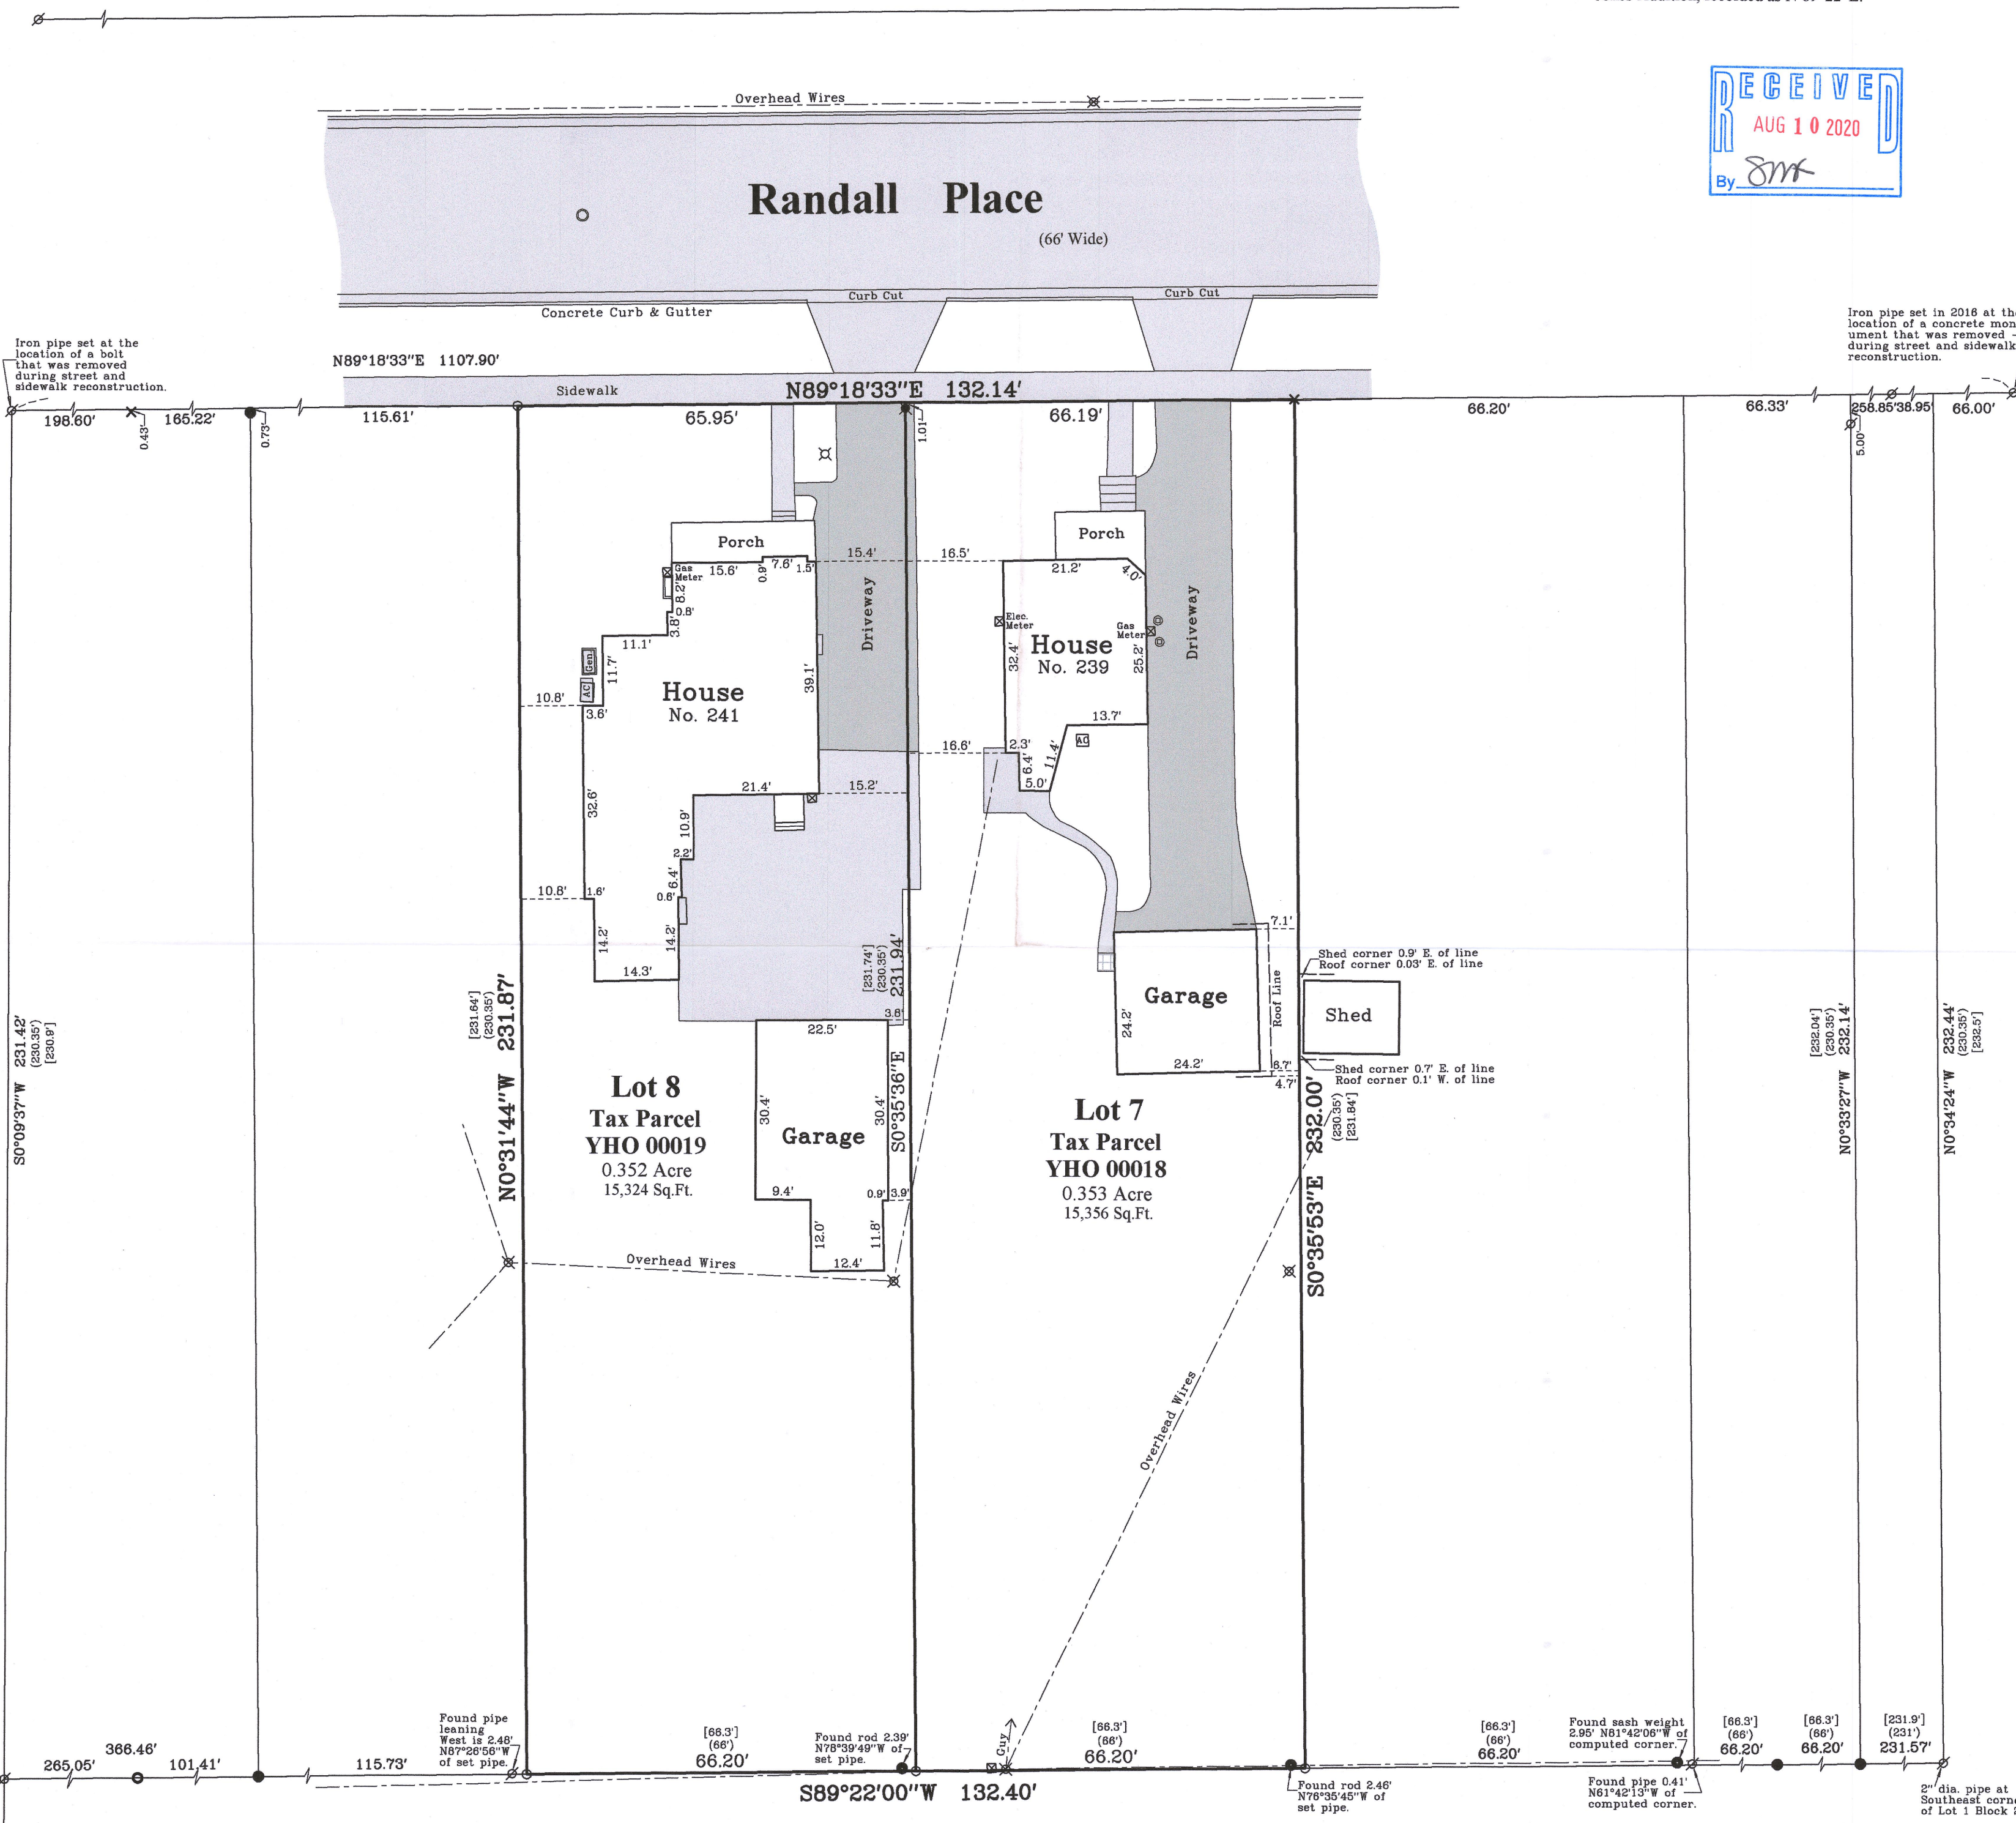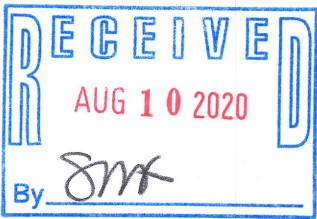

- Notes:
- 1) This Plat of Survey is not certified unless signed and sealed in red ink.
 - 2) This survey is subject to Wisconsin lien laws. This Plat of Survey is the notice of intent to file lien. Lien waiver required.
 - 3) The Survey Date shown on this Plat of Survey is the completion date of the field work.

Copyright © 2020 by Olson Land Surveying, LLC.
All rights reserved. No part of this survey plat may be reproduced or transmitted in any form by any means - graphic, electronic, or mechanical, including photocopying, tracing, or information storage and retrieval systems - without permission in writing from Douglas G. Olson, Olson Land Surveying, LLC.

I hereby certify that I have surveyed the above described property in compliance with Chapter A-E 7 of the Wisconsin Administrative Code and that the map hereon is correct to the best of my professional knowledge and belief and shows the size and location of the property, its exterior boundaries, the location and dimensions of all visible structures thereon, boundary fences, apparent easements and roadways and visible encroachments, if any.
This survey is made for the exclusive use of the present owners of the property, and also those who purchase, mortgage or guarantee title thereto, within one year from the date hereof.

Douglas G. Olson
Wisconsin Professional Land Surveyor - 2093

2020.060

Sheet 1 of 1 Sheets

Drawing Name:

Job Reference Number

2020.060

YHO-19 YHO-18

Legend of Symbols & Abbreviations

Found Iron Pipe

Found Iron Rod

Set Iron Pipe, 1" dia.

Found Chiseled Cross

Recorded Information Plat

Utility Pole

Utility Pedestal

Asphalt Surface

Concrete Surface

Found Mag Nail

Found Lamp

Manhole

Bollard

Brick Pavers

N North

S South

E East

W West

In Bearings

Degrees

Minutes

Seconds

In Distances

Feet

Inches

Tubbs

OLSON

LAND SURVEYING, LLC

Rural | Residential | Commercial

45 South Wisconsin Street | P.O. Box 322

Elkhorn, Wisconsin. 53121

Telephone: (262) 723-3434

Facsimile: (262) 723-8044

Email: doug@olsonsurveying.com

Website: www.olsonsurveying.com

Scale in Feet

1" = 20'

0' 10' 20' 40' 60'

Survey Date: June 23, 2020.

Revisions:

004-2111