PLAT OF SURVEY

OF LOT 22 (EXCEPT THE SOUTH 4 FEET) OF HARMONY ACRES SUBDIVISION ADDITION No. 1. LOCATED IN THE N.W. QUARTER OF SECTION 6, TOWN 2 NORTH, RANGE 17 EAST, CITY OF ELKHORN, WALWORTH COUNTY, WISC.

JENSEN SURVEYING & MAPPING S.C.
P.O. BOX 322
ELKHORN, WISC 53121
(414) 723-3434

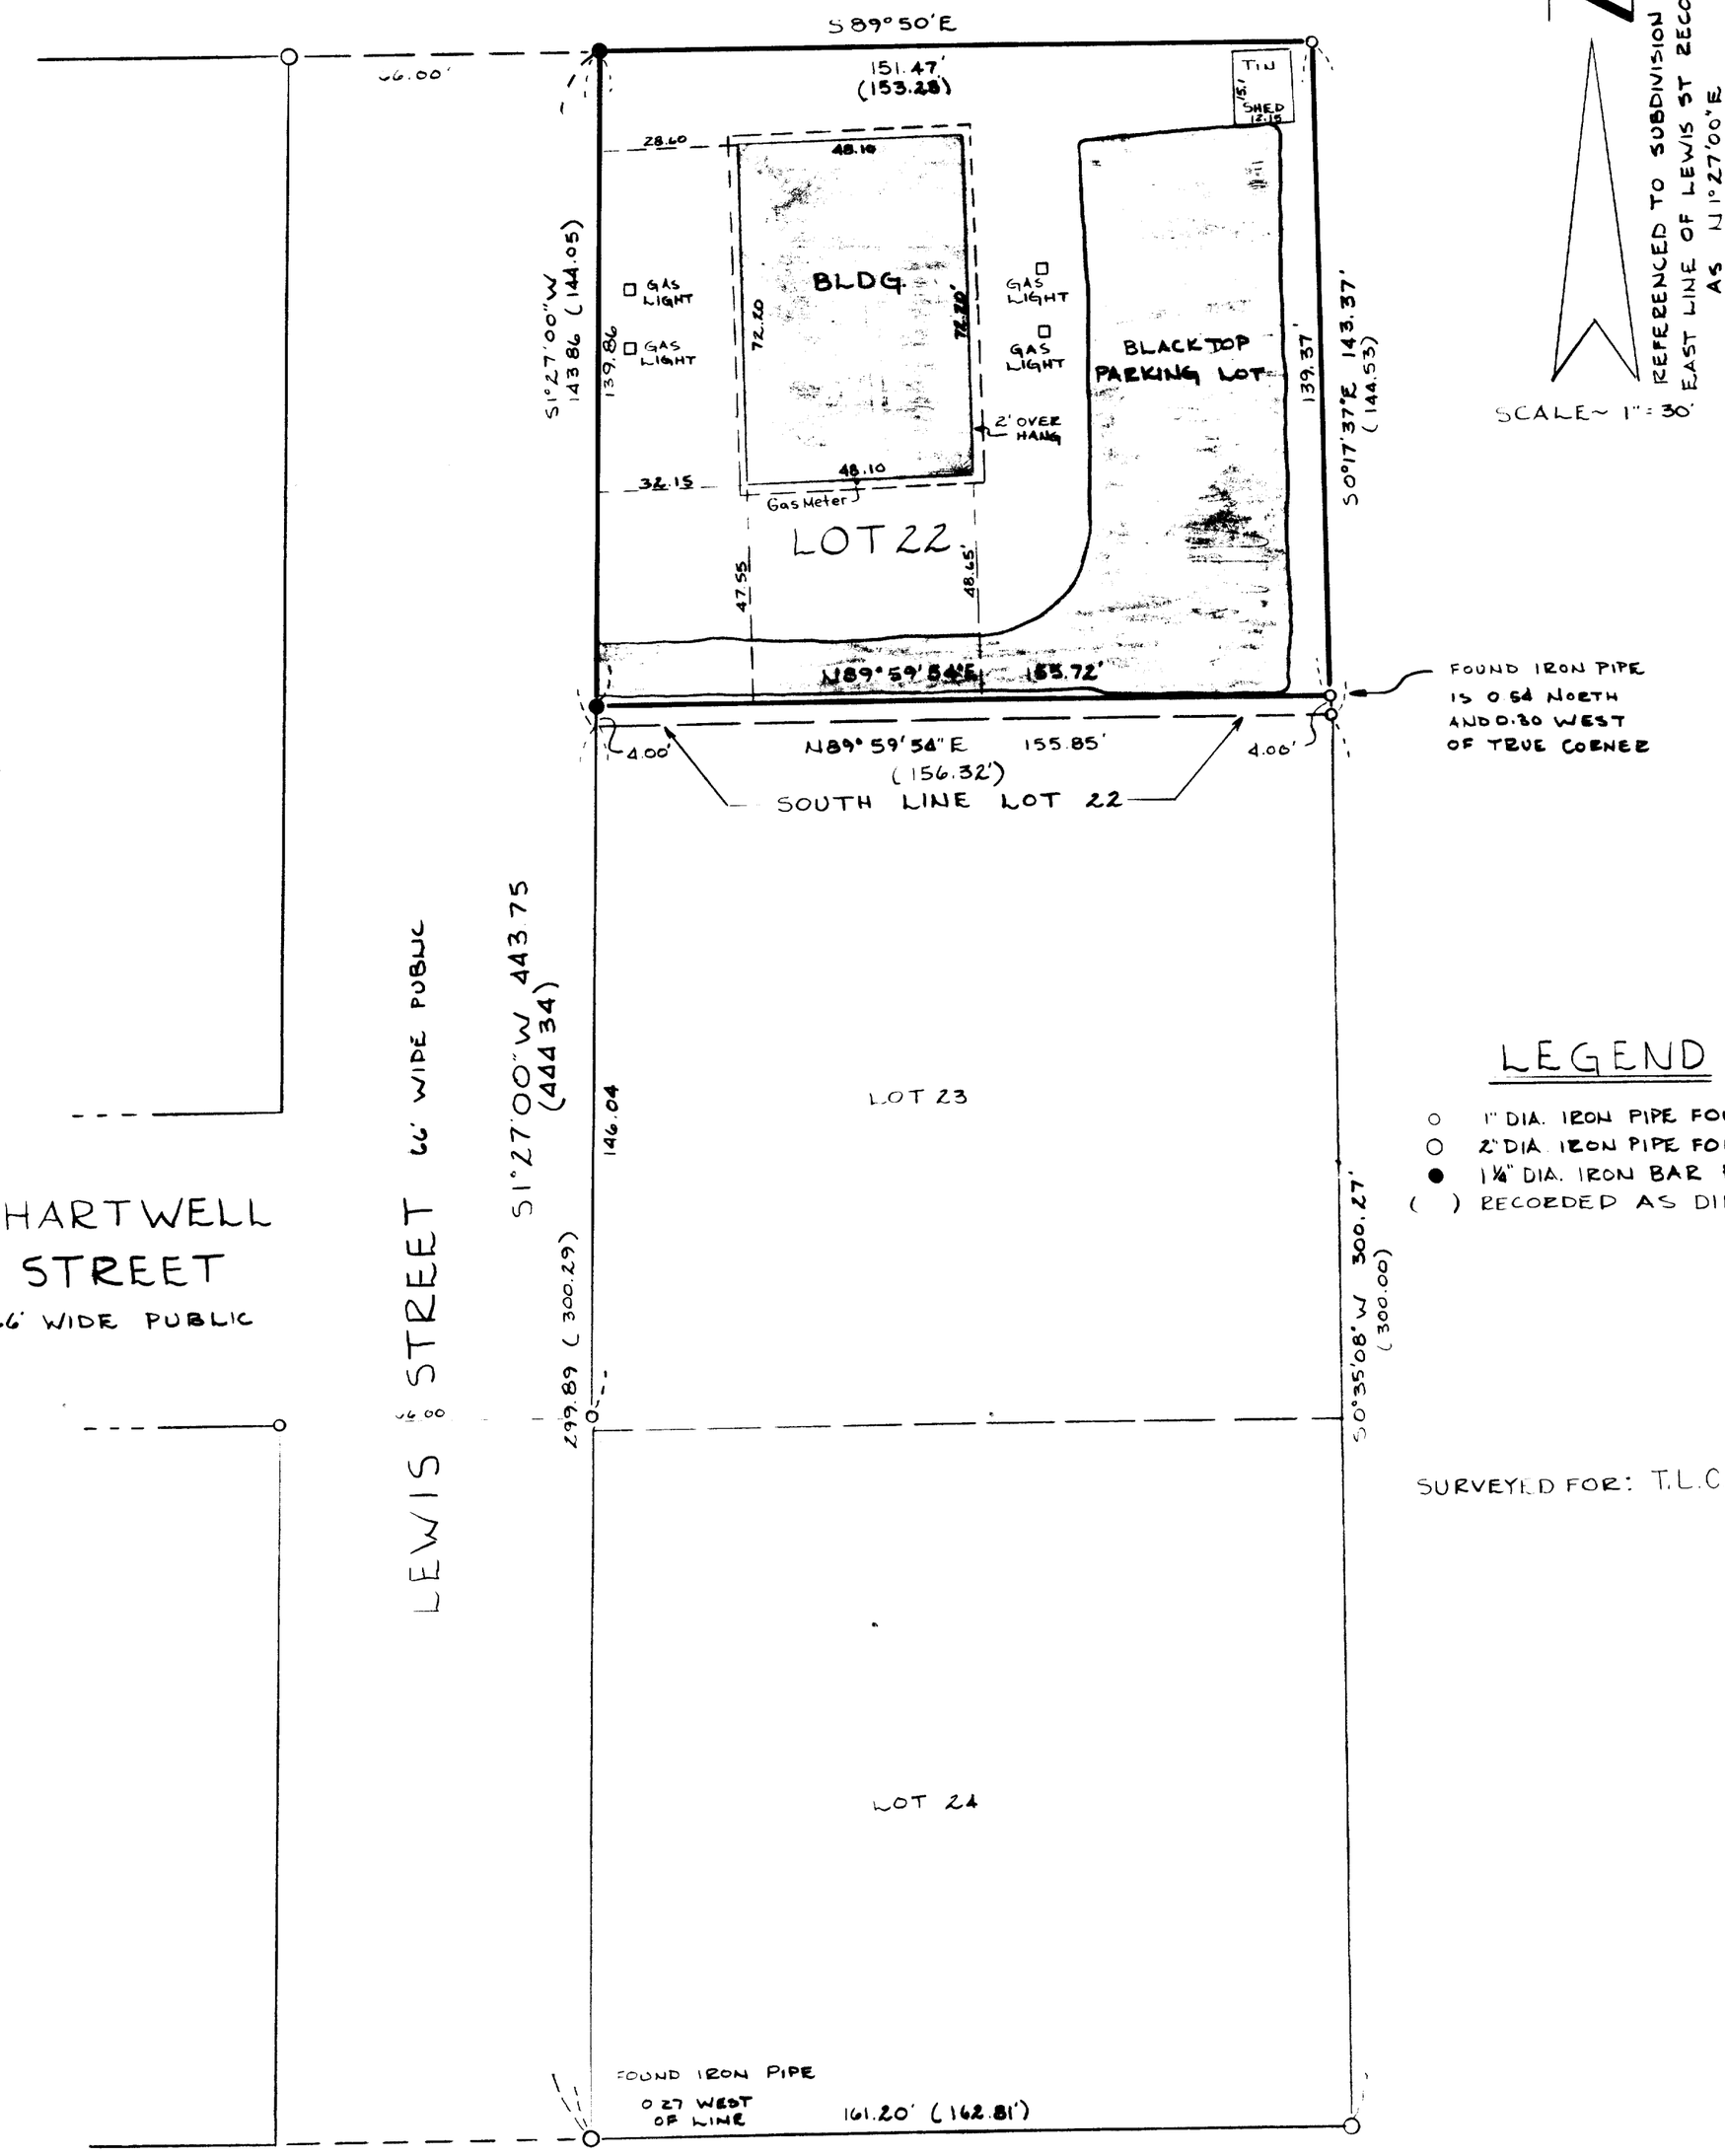

SCALE ~ 1" = 30'

REFERENCED TO SUBDIVISION PLAT EAST LINE OF LEWIS ST RECORDED AS N1°27'00"E

LEGEND

- ○ 1" DIA. IRON PIPE FOUND
- ○ 2" DIA. IRON PIPE FOUND
- ● 1¼" DIA. IRON BAR PLACED
- ( ) RECORDED AS DIMENSION

SURVEYED FOR: T.L.C. REALTY

I HEREBY CERTIFY THAT THE ABOVE DESCRIBED PROPERTY HAS BEEN SURVEYED UNDER MY DIRECTION THAT THE PLAT SHOWN HEREON IS AN ACCURATE SURVEY, A TRUE REPRESENTATION THEREOF, CORRECTLY SHOWS THE EXTERIOR BOUNDARY LINES ON SAID PROPERTY AND THE CORRECT MEASUREMENTS THEREOF AND THE BUILDINGS THEREON TO THE BEST OF MY KNOWLEDGE AND BELIEF.

Thomas P.A. Jensen

THOMAS P.A. JENSEN R.L.S. # 1084

1983.054 4-33PJ