

85

Sept. 19 & 20,

Surveyed lots 1 & 2 B. 3,
Glenwood Springs by request
of Wm Best.

See record in Field Book
#AAA, Page 55, & Blue Print
6 original iron stks found
on W. line Block 16, All
O.K.

Found original iron stks at
N.E. Cor. lot 1. Block 16.

and also iron pipe.

Run west line Block 16
& 2 to Park Place.

Checked over for corners
of 1 & 2 Block 3,


and set iron stks at S.E.

Cor. of 1 & S.W. Cor. of 2

And Brass & Wood stks

at N. corners

See Record in AAAA
and Blueprint

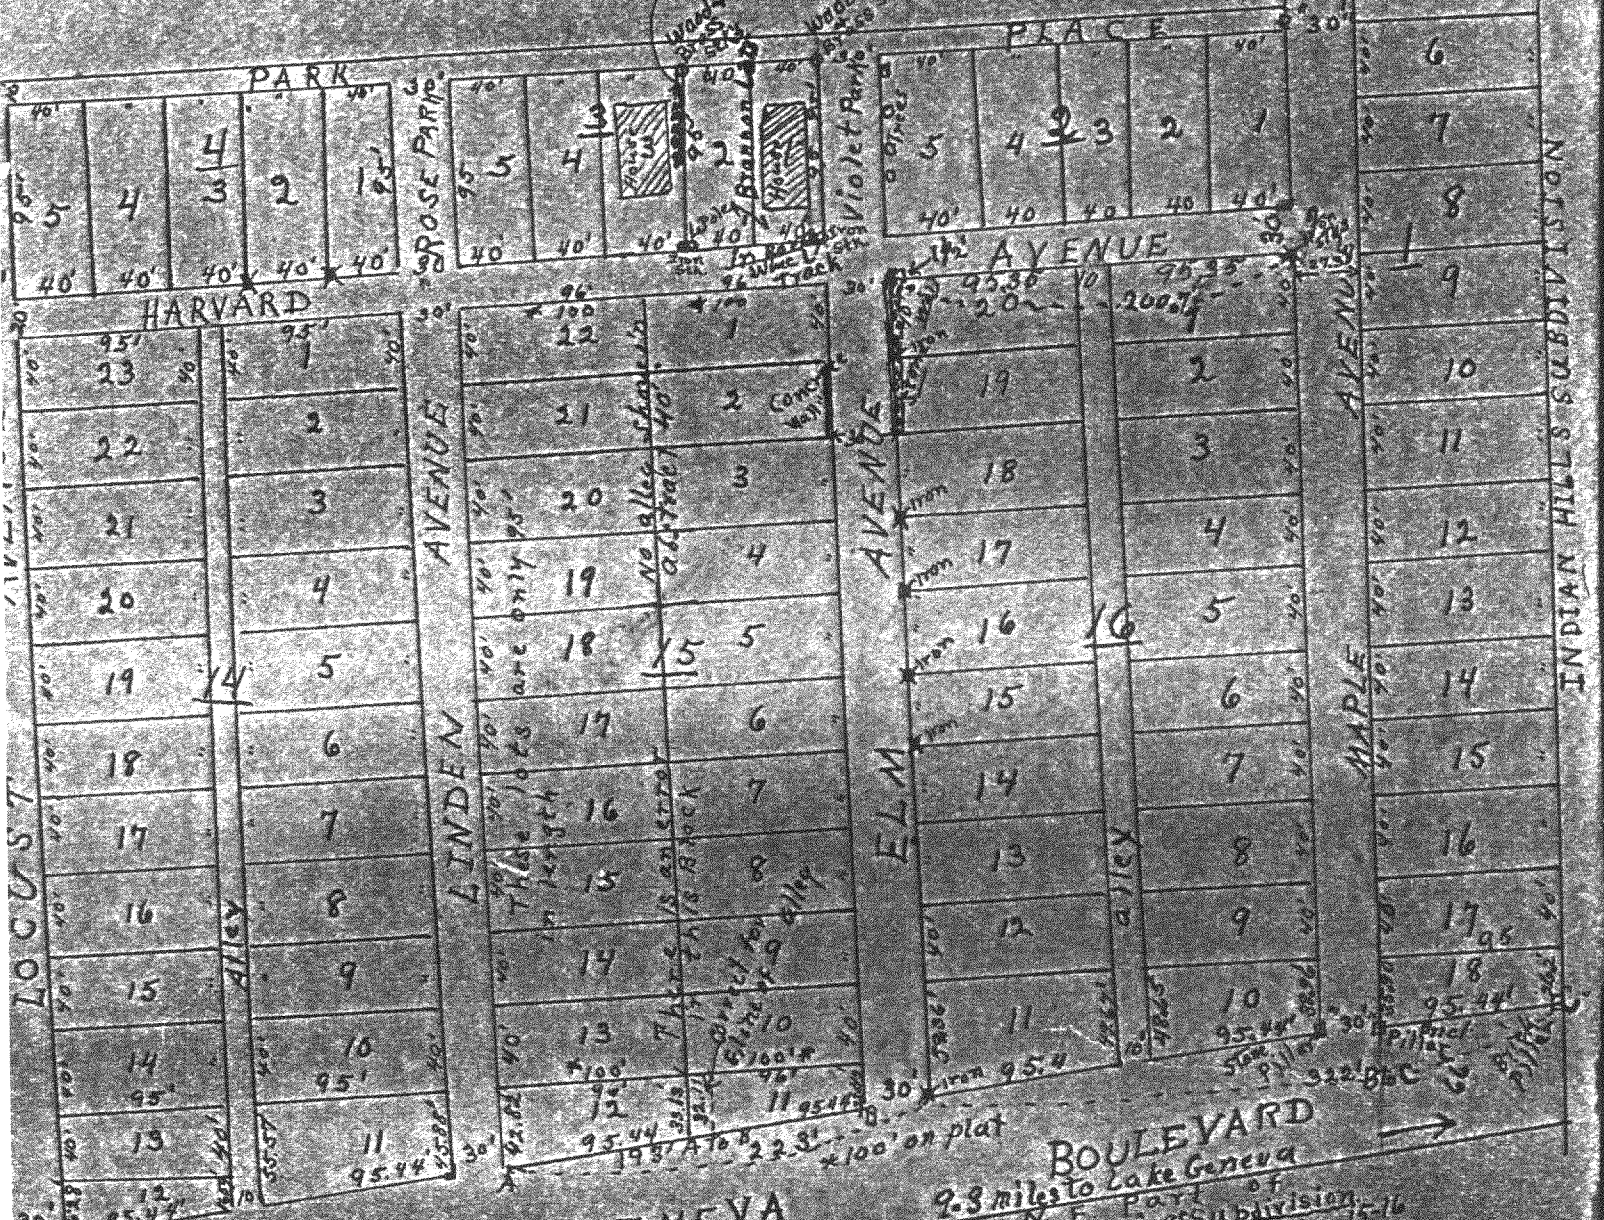

Lake Geneva, Wisconsin 140 Block 3

5-106 sh ✓