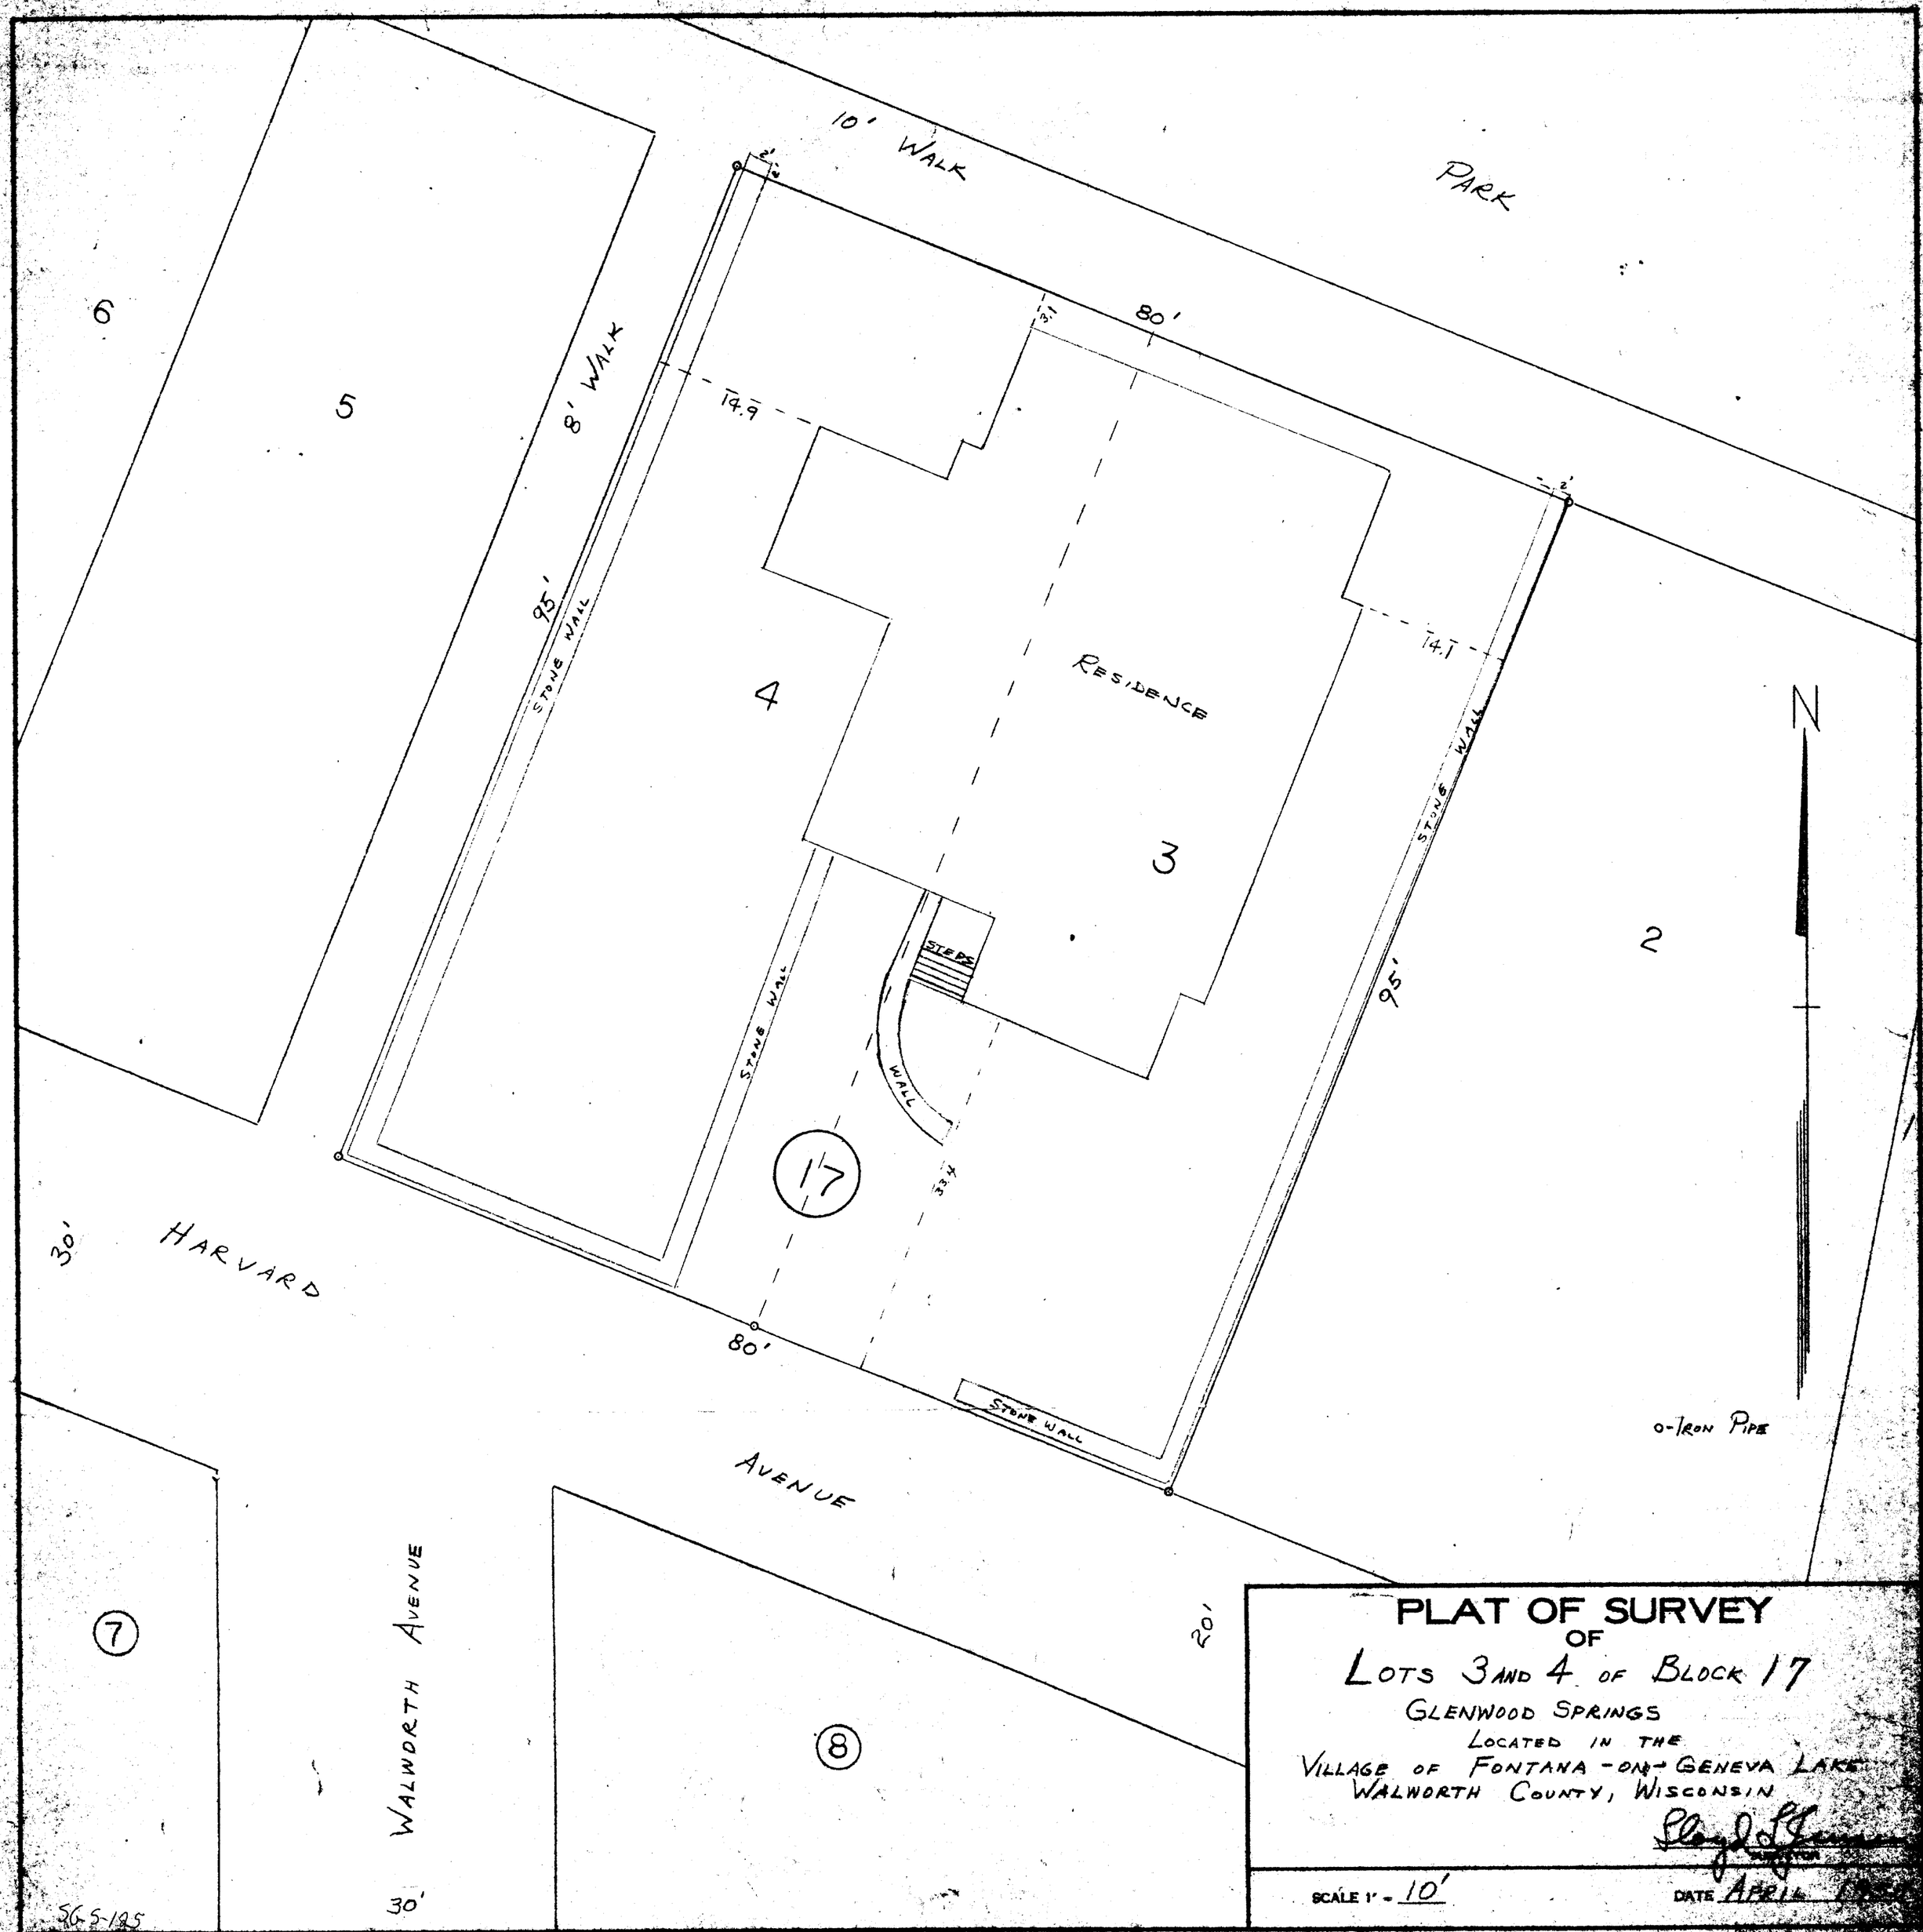
10' WALK
PARK
6
5
8' WALK
80'
14.9
95'
STONE WALL
4
RESIDENCE
3
14.1
STONE WALL
2
95'
STEPS
STONE WALL
WALL
17
33.4
30'
HARVARD
80'
STONE WALL
AVENUE
O-IRON PIPE
N
7
WALWORTH AVENUE
30'
8
20'
PLAT OF SURVEY
OF
LOTS 3 AND 4 OF BLOCK 17
GLENWOOD SPRINGS
LOCATED IN THE
VILLAGE OF FONTANA-ON-GENEVA LAKE
WALWORTH COUNTY, WISCONSIN
SURVEYOR
SCALE 1" = 10'
DATE APRIL
56-5-125
5-12