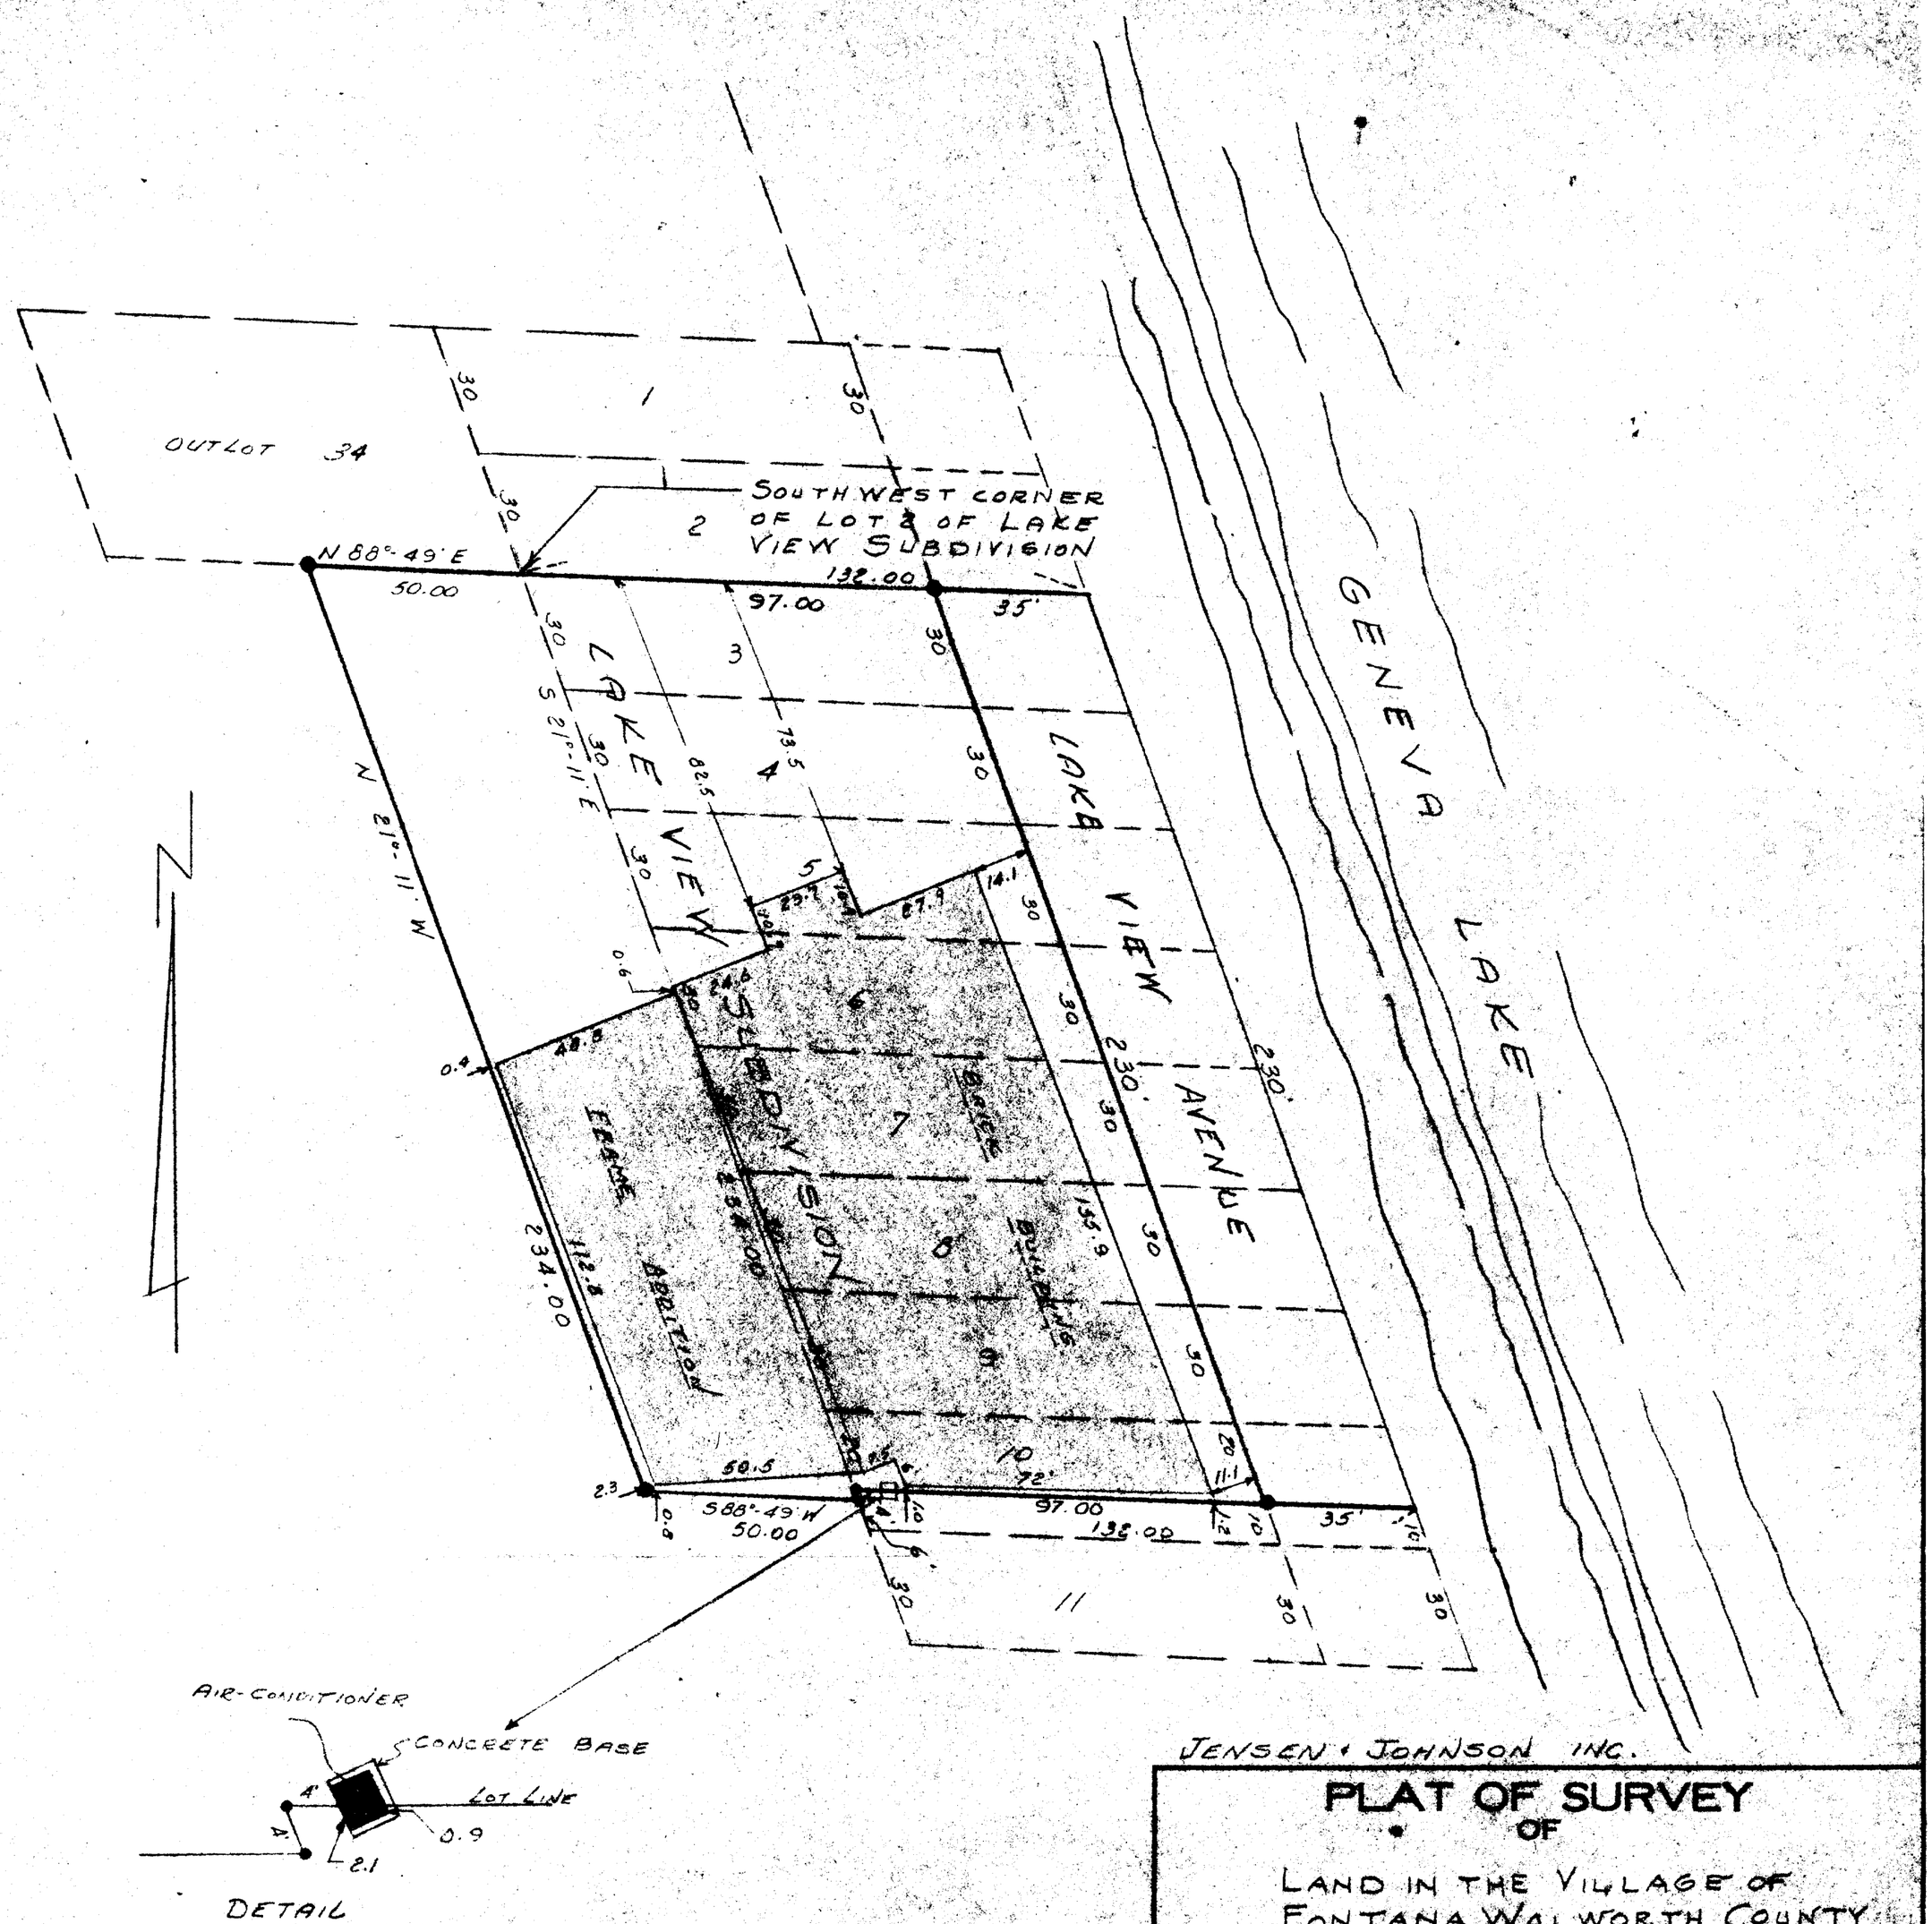

DETAIL

LEGEND

● — CONCRETE MONUMENT

PALMER BOAT COMPANY
5-171J

JENSEN & JOHNSON INC.

PLAT OF SURVEY
OF

LAND IN THE VILLAGE OF FONTANA, WALWORTH COUNTY WISCONSIN.

George Bruce Wilson
REGISTERED LAND SURVEYOR

SCALE 1" = 30'

DATE Nov. 20, 1968