PLAT OF SURVEY

UNIT 1505 OF ABBEY SPRINGS CONDOMINIUM NO. 15

LOCATED IN PART OF THE SW 1/4 OF SECTION 13, TOWN 1 NORTH, RANGE 16 EAST, VILLAGE OF FONTANA-ON-GENEVA LAKE, WALWORTH COUNTY, WISCONSIN

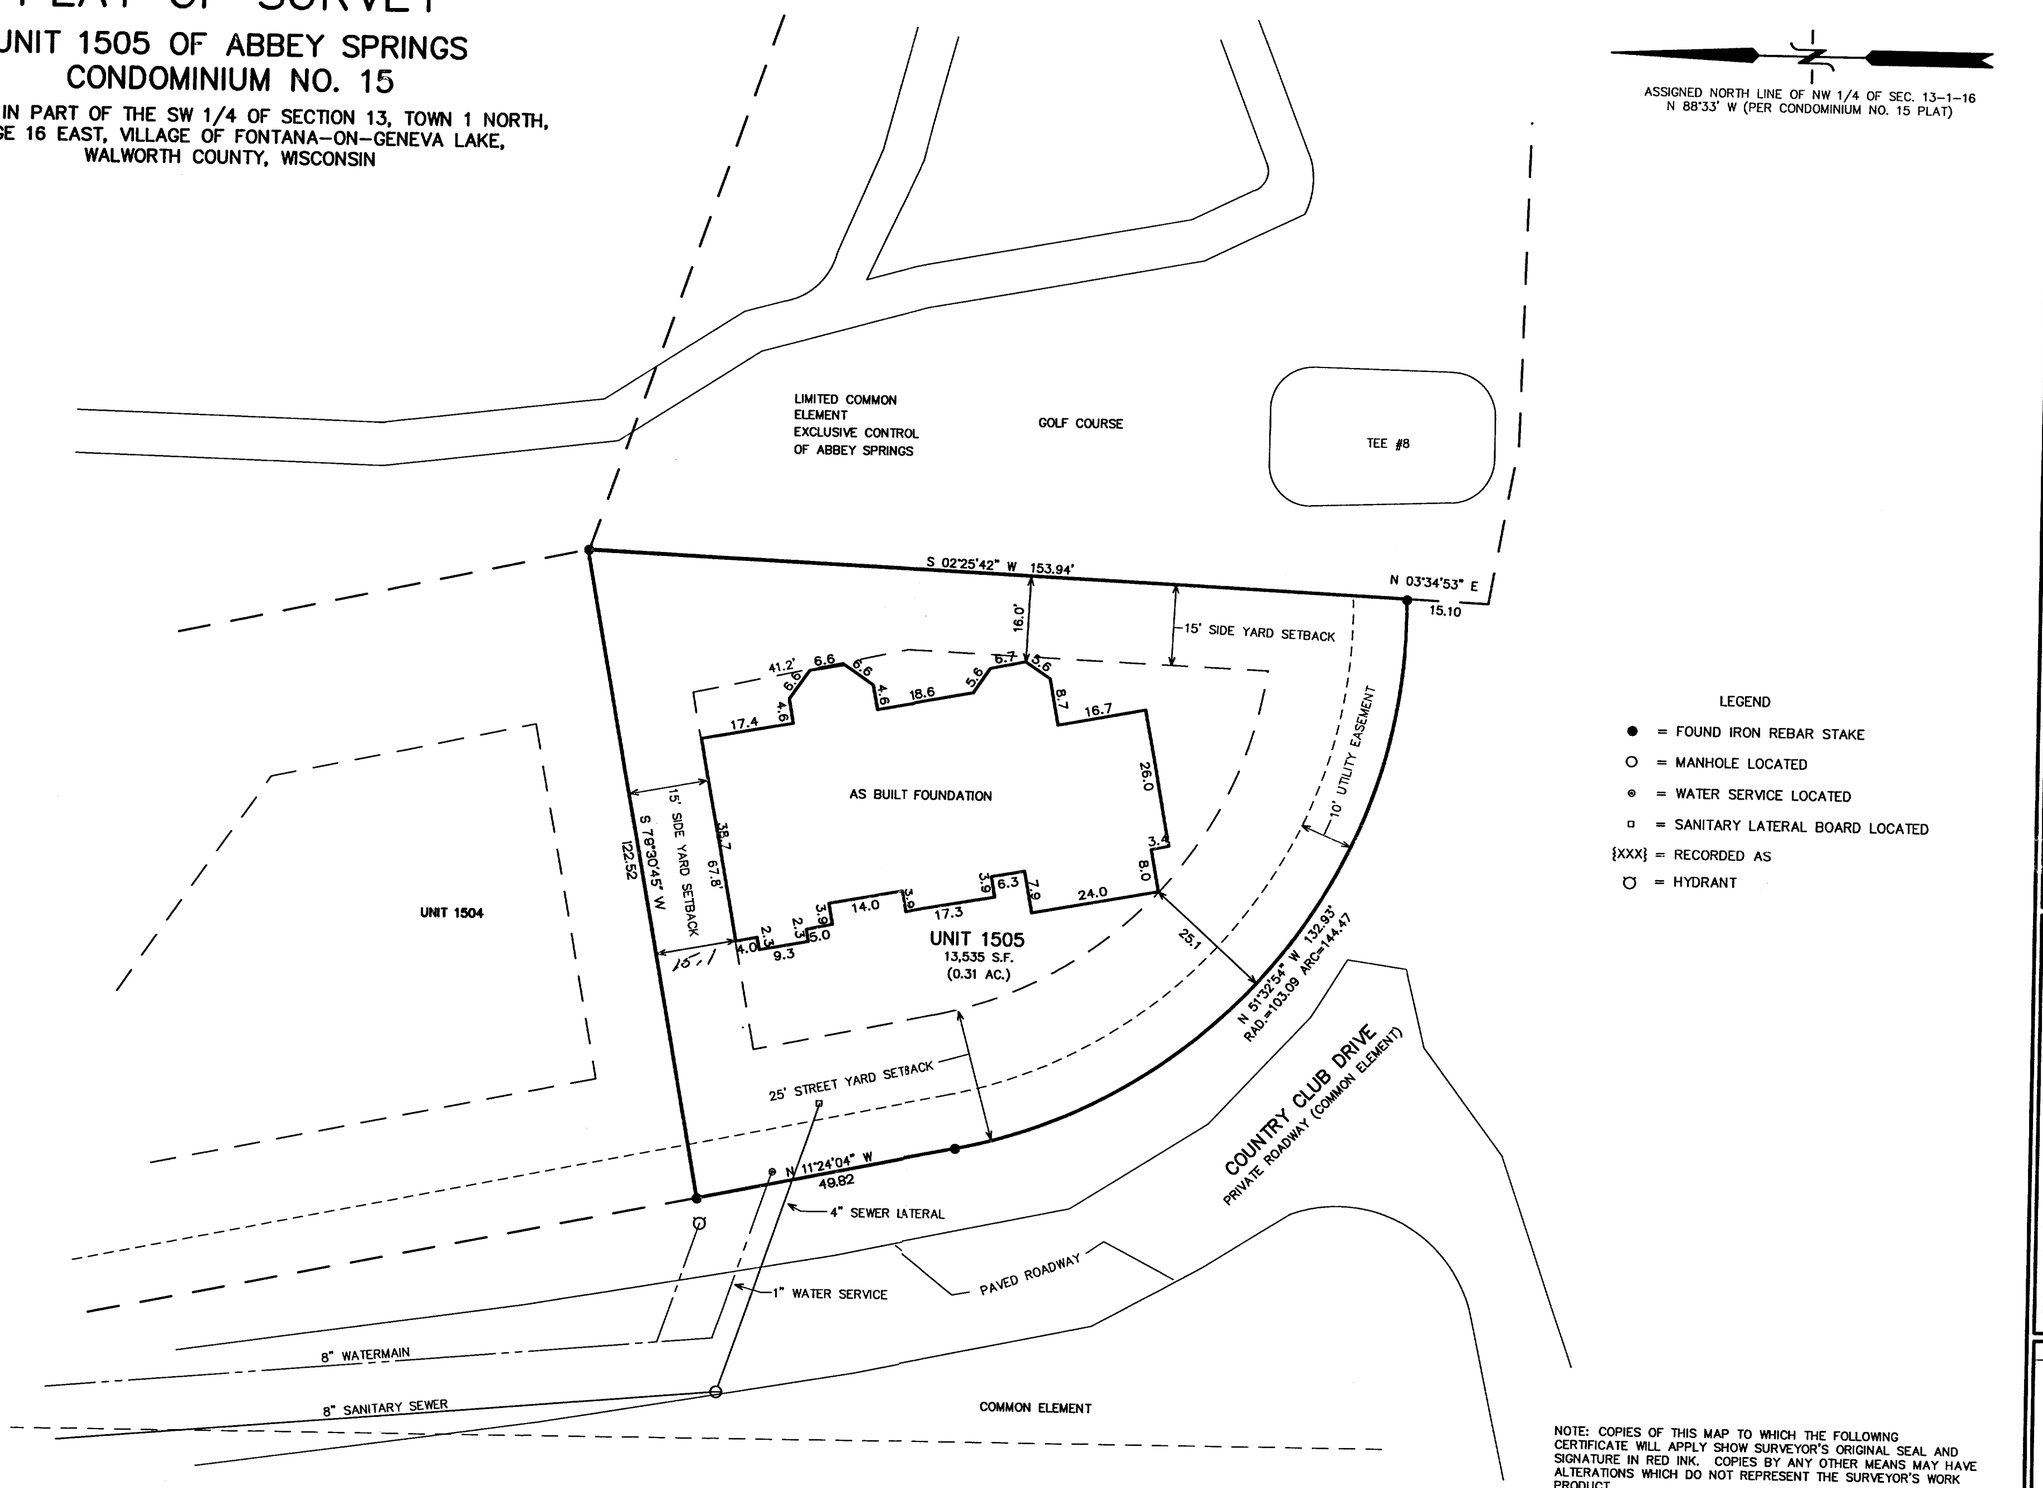

LEGEND

- ● = FOUND IRON REBAR STAKE
- ○ = MANHOLE LOCATED
- ⊗ = WATER SERVICE LOCATED
- ▫ = SANITARY LATERAL BOARD LOCATED
- {XXX} = RECORDED AS
- ♂ = HYDRANT

REVISED 06-27-2002
TO SHOW SIZE & LOCATION
OF FOUNDATION
AS BUILT

RECEIVED
JUL 17 2002

10 5 0 10 20 30 40 50 60 70 80 90 100
MAP SCALE IN FEET ORIGINAL 1" = 20'

NOTE: COPIES OF THIS MAP TO WHICH THE FOLLOWING CERTIFICATE WILL APPLY SHOW SURVEYOR'S ORIGINAL SEAL AND SIGNATURE IN RED INK. COPIES BY ANY OTHER MEANS MAY HAVE ALTERATIONS WHICH DO NOT REPRESENT THE SURVEYOR'S WORK PRODUCT.

I HEREBY CERTIFY THAT THE ABOVE DESCRIBED PROPERTY HAS BEEN SURVEYED UNDER MY DIRECTION AND THAT THE ABOVE MAP IS A TRUE REPRESENTATION THEREOF AND SHOWS THE SIZE AND LOCATION OF THE PROPERTY AND ITS EXTERIOR BOUNDARIES. THIS SURVEY IS MADE FOR THE USE OF THE PRESENT OWNERS OF THE PROPERTY, AND ALSO THOSE WHO PURCHASE, MORTGAGE, OR GUARANTEE THE TITLE THERETO WITHIN ONE YEAR FROM THE DATE HEREOF.

DATED: 08-22-2001

PETER S. GORDON R.L.S. 2101

PLAT OF SURVEY

- WORK ORDERED BY -
BRIAN JORNDT
JORNDT BUILDERS
1809 SOUTH SHORE DRIVE
DELAVAN, WI. 53115

FARRIS, HANSEN & ASSOCIATES, INC.
ENGINEERING - ARCHITECTURE - SURVEYING
7 RIDGWAY COURT P.O. BOX 437
ELKHORN, WISCONSIN 53121
OFFICE: (262) 723-2098 FAX: (262) 723-5886

REVISIONS

PROJECT NO.	1915.1505
DATE:	02/15/2002
SHEET NO.	1 OF 1

JUN 28 2002

SCD 15-1505

005-1986