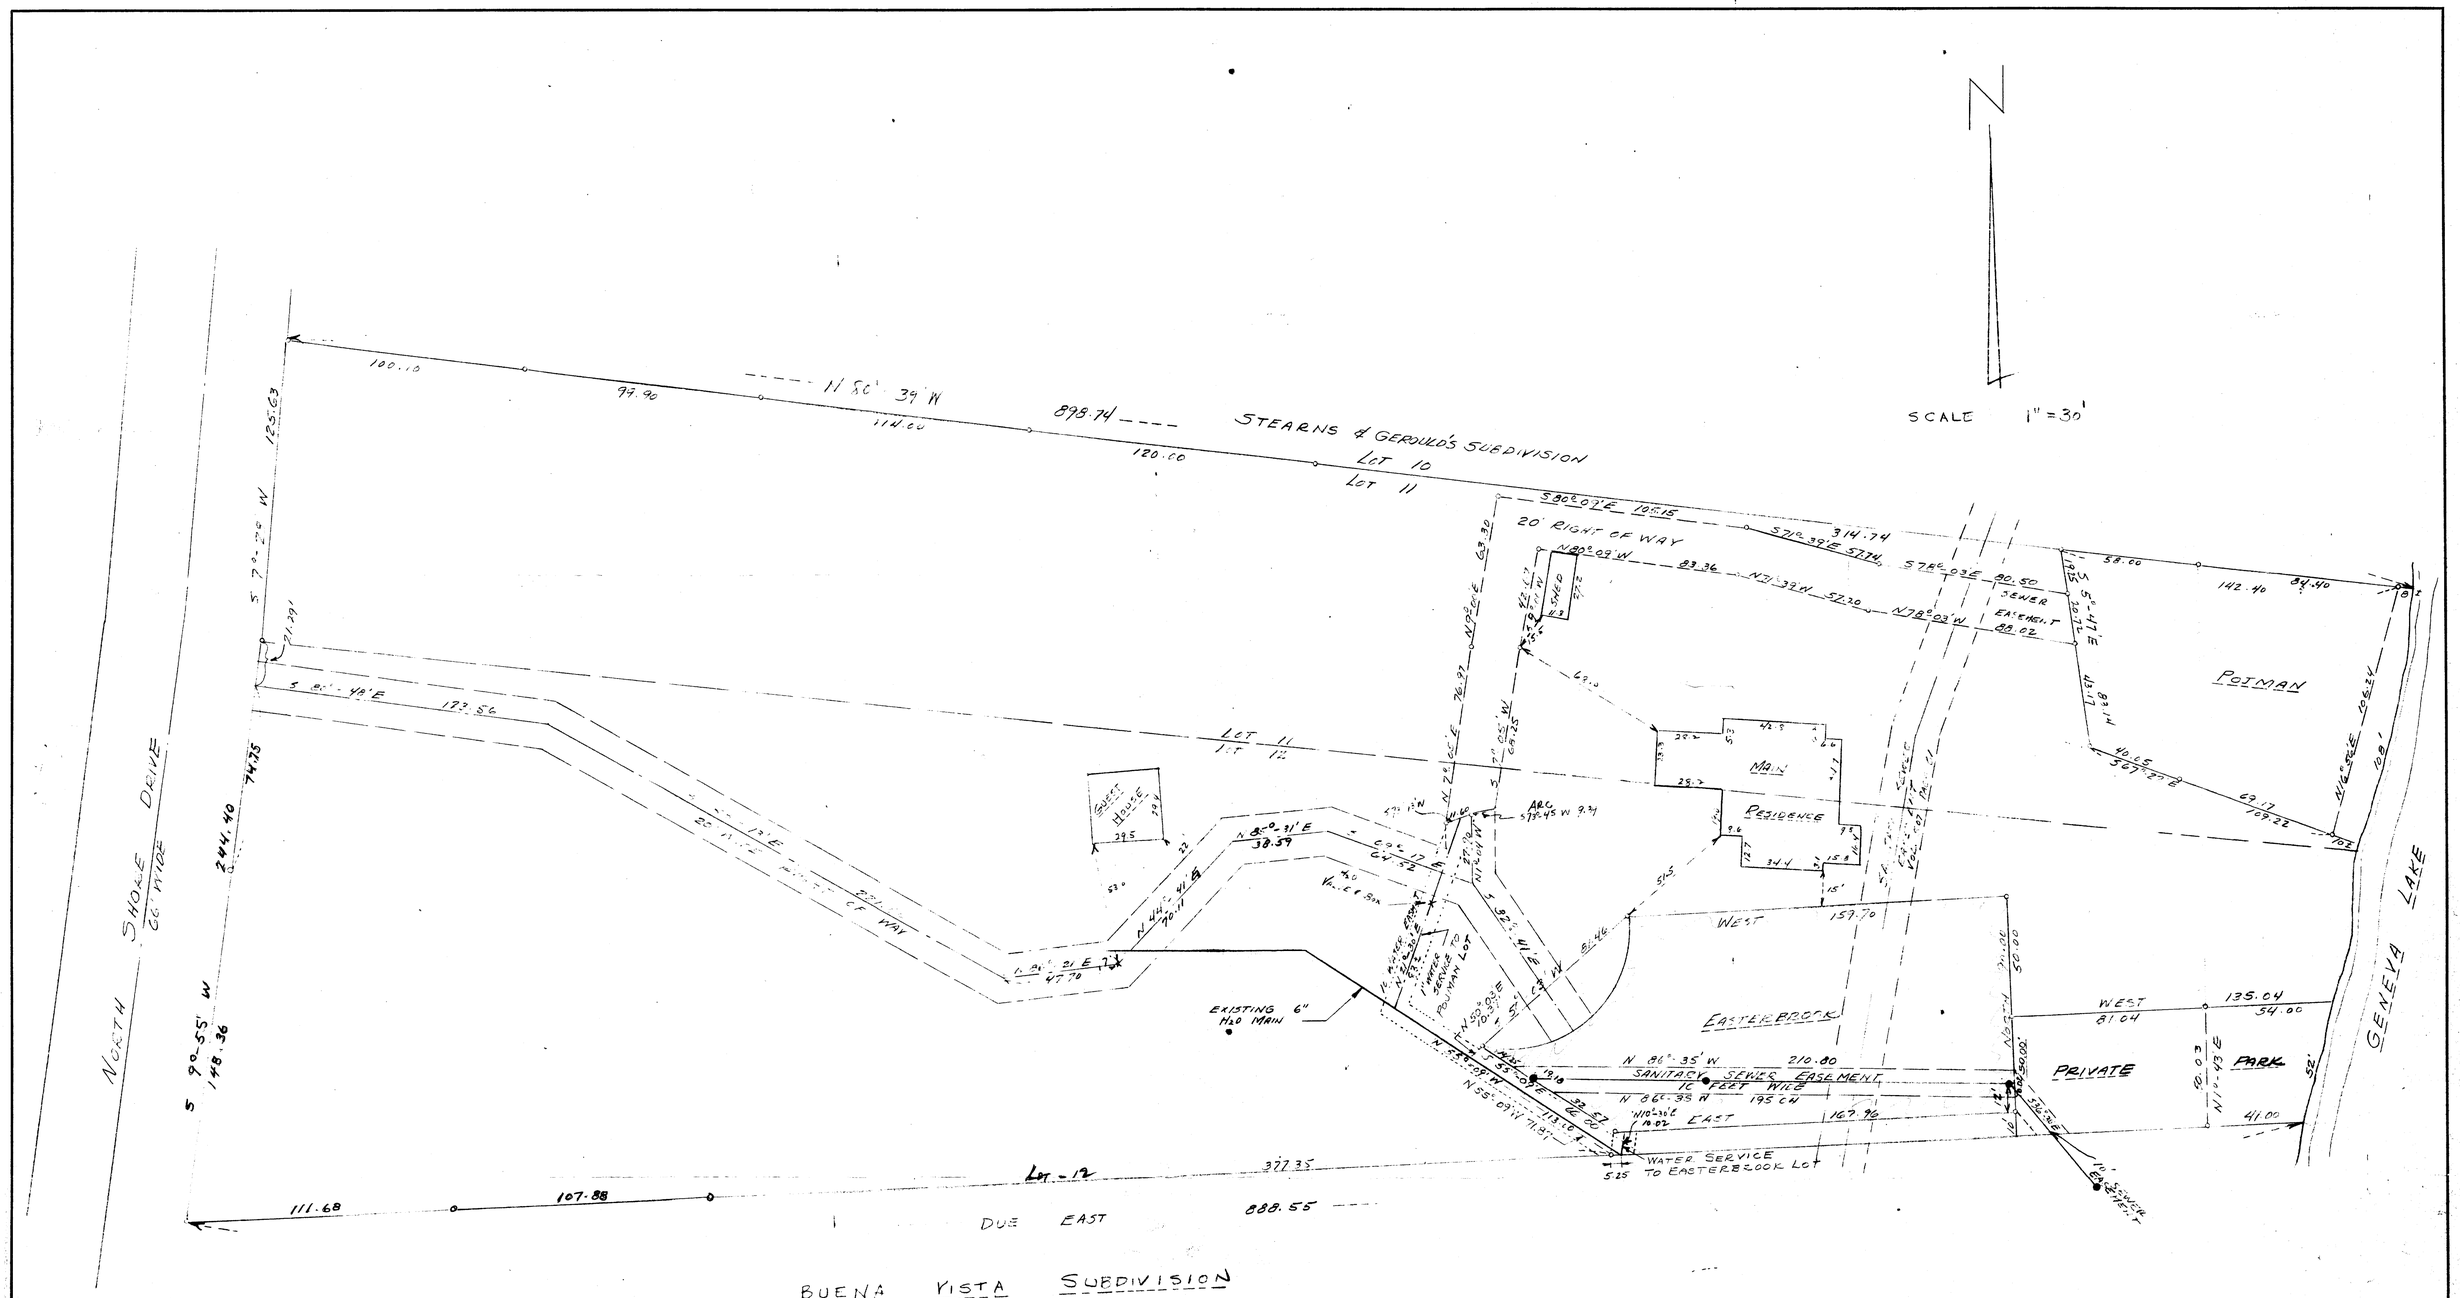

WE CERTIFY THAT WE HAVE SURVEYED THE ABOVE DESCRIBED PROPERTY AND THAT THE ABOVE PLAT IS AN ACCURATE SURVEY AND A TRUE REPRESENTATION THEREOF AND CORRECTLY SHOWS THE EXTERIOR BOUNDARY LINES AND LOCATION OF BUILDINGS AND OTHER IMPROVEMENTS, AND ROADS, DRIVEWAYS, AND OTHER APPARENT EASEMENTS ON SAID PROPERTY AND THE CORRECT MEASUREMENTS THEREOF.

DEC. 12, 1967

BY: Floyd F. Jensen
JENSEN & JOHNSON

LOTS 11 - 12 STEARNS & GEROULD'S SUBDIVISION - SW 1/4 SECTION 11, T1N-R16E, WALWORTH COUNTY, WIS

DRAWN BY GBW	JENSEN & JOHNSON CIVIL ENGINEERS ELKHORN, WIS.	SCALE: 1" = 30'
CHECKED BY Floyd F. Jensen		REVISED
APPROVED BY	DATE NOV 8, 1967	SHEET NO. OF

40-185 400-3-66

5-200A