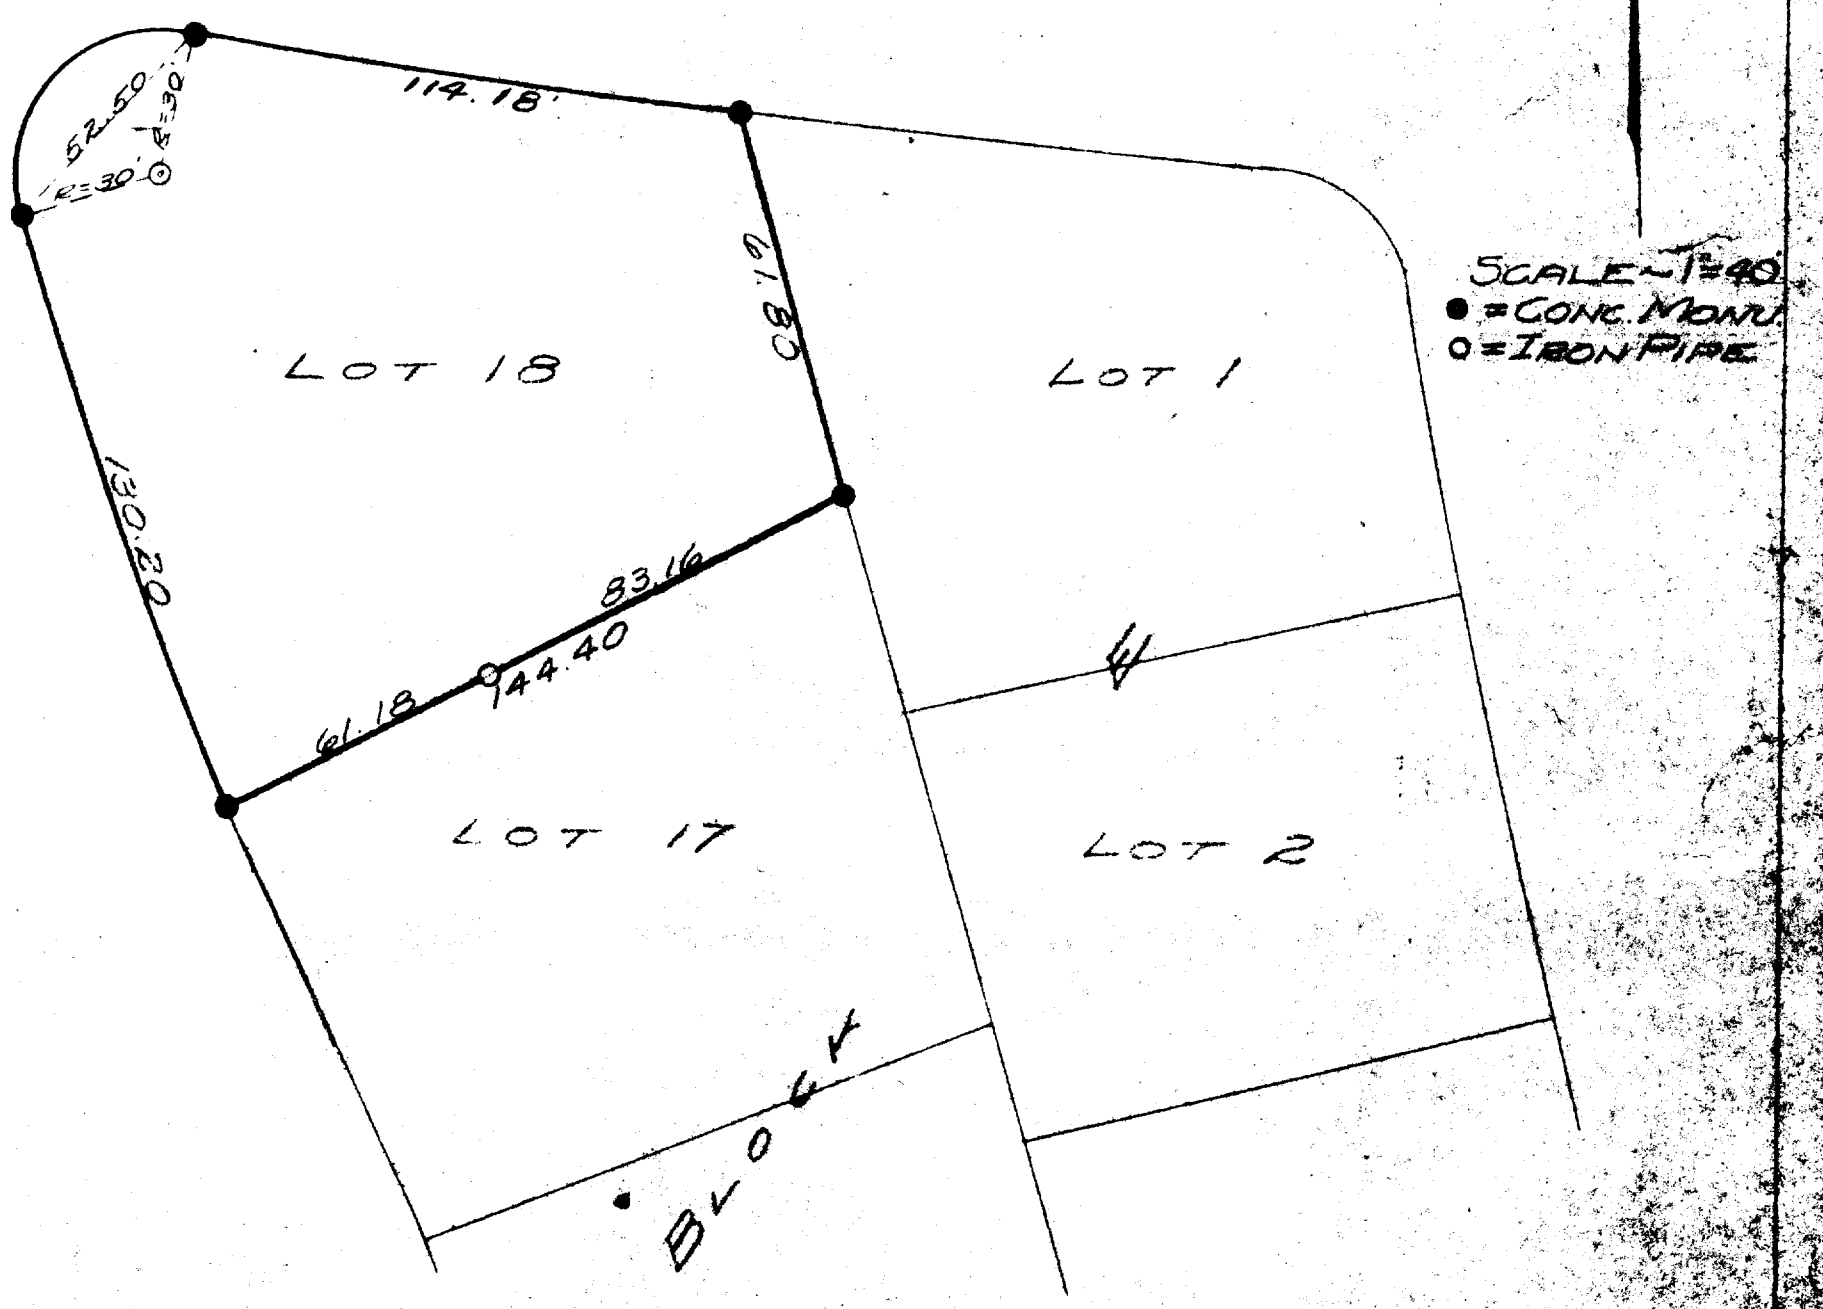

PLAT OF SURVEY OF LOT 18, BLOCK E OF UNIT 3 OF COUNTRY CLUB ESTATES, A SUBDIVISION LOCATED IN SECTIONS 14 AND 23, T1N, R16E OF WALWORTH COUNTY, WISCONSIN.

NOV. 26, 1945

Floyd L. Henderson
COUNTY SURVEYOR

5C0295