


PLAT OF SURVEY

-OF-

BROOK STREET AND FOREST LANE IN BUENA VISTA SUBDIVISION, LOCATED
IN SECTIONS 11 AND 14, TOWN 1 NORTH, RANGE 16 EAST, VILLAGE OF
FONTANA - ON - GENEVA LAKE, WALWORTH COUNTY, WISCONSIN.

KROTT SURVEYING INC.

N3705 WILLOW BEND LANE
LAKE GENEVA WI. 53147
PHONE # (262)248-3697
FAX # (262)249-0639

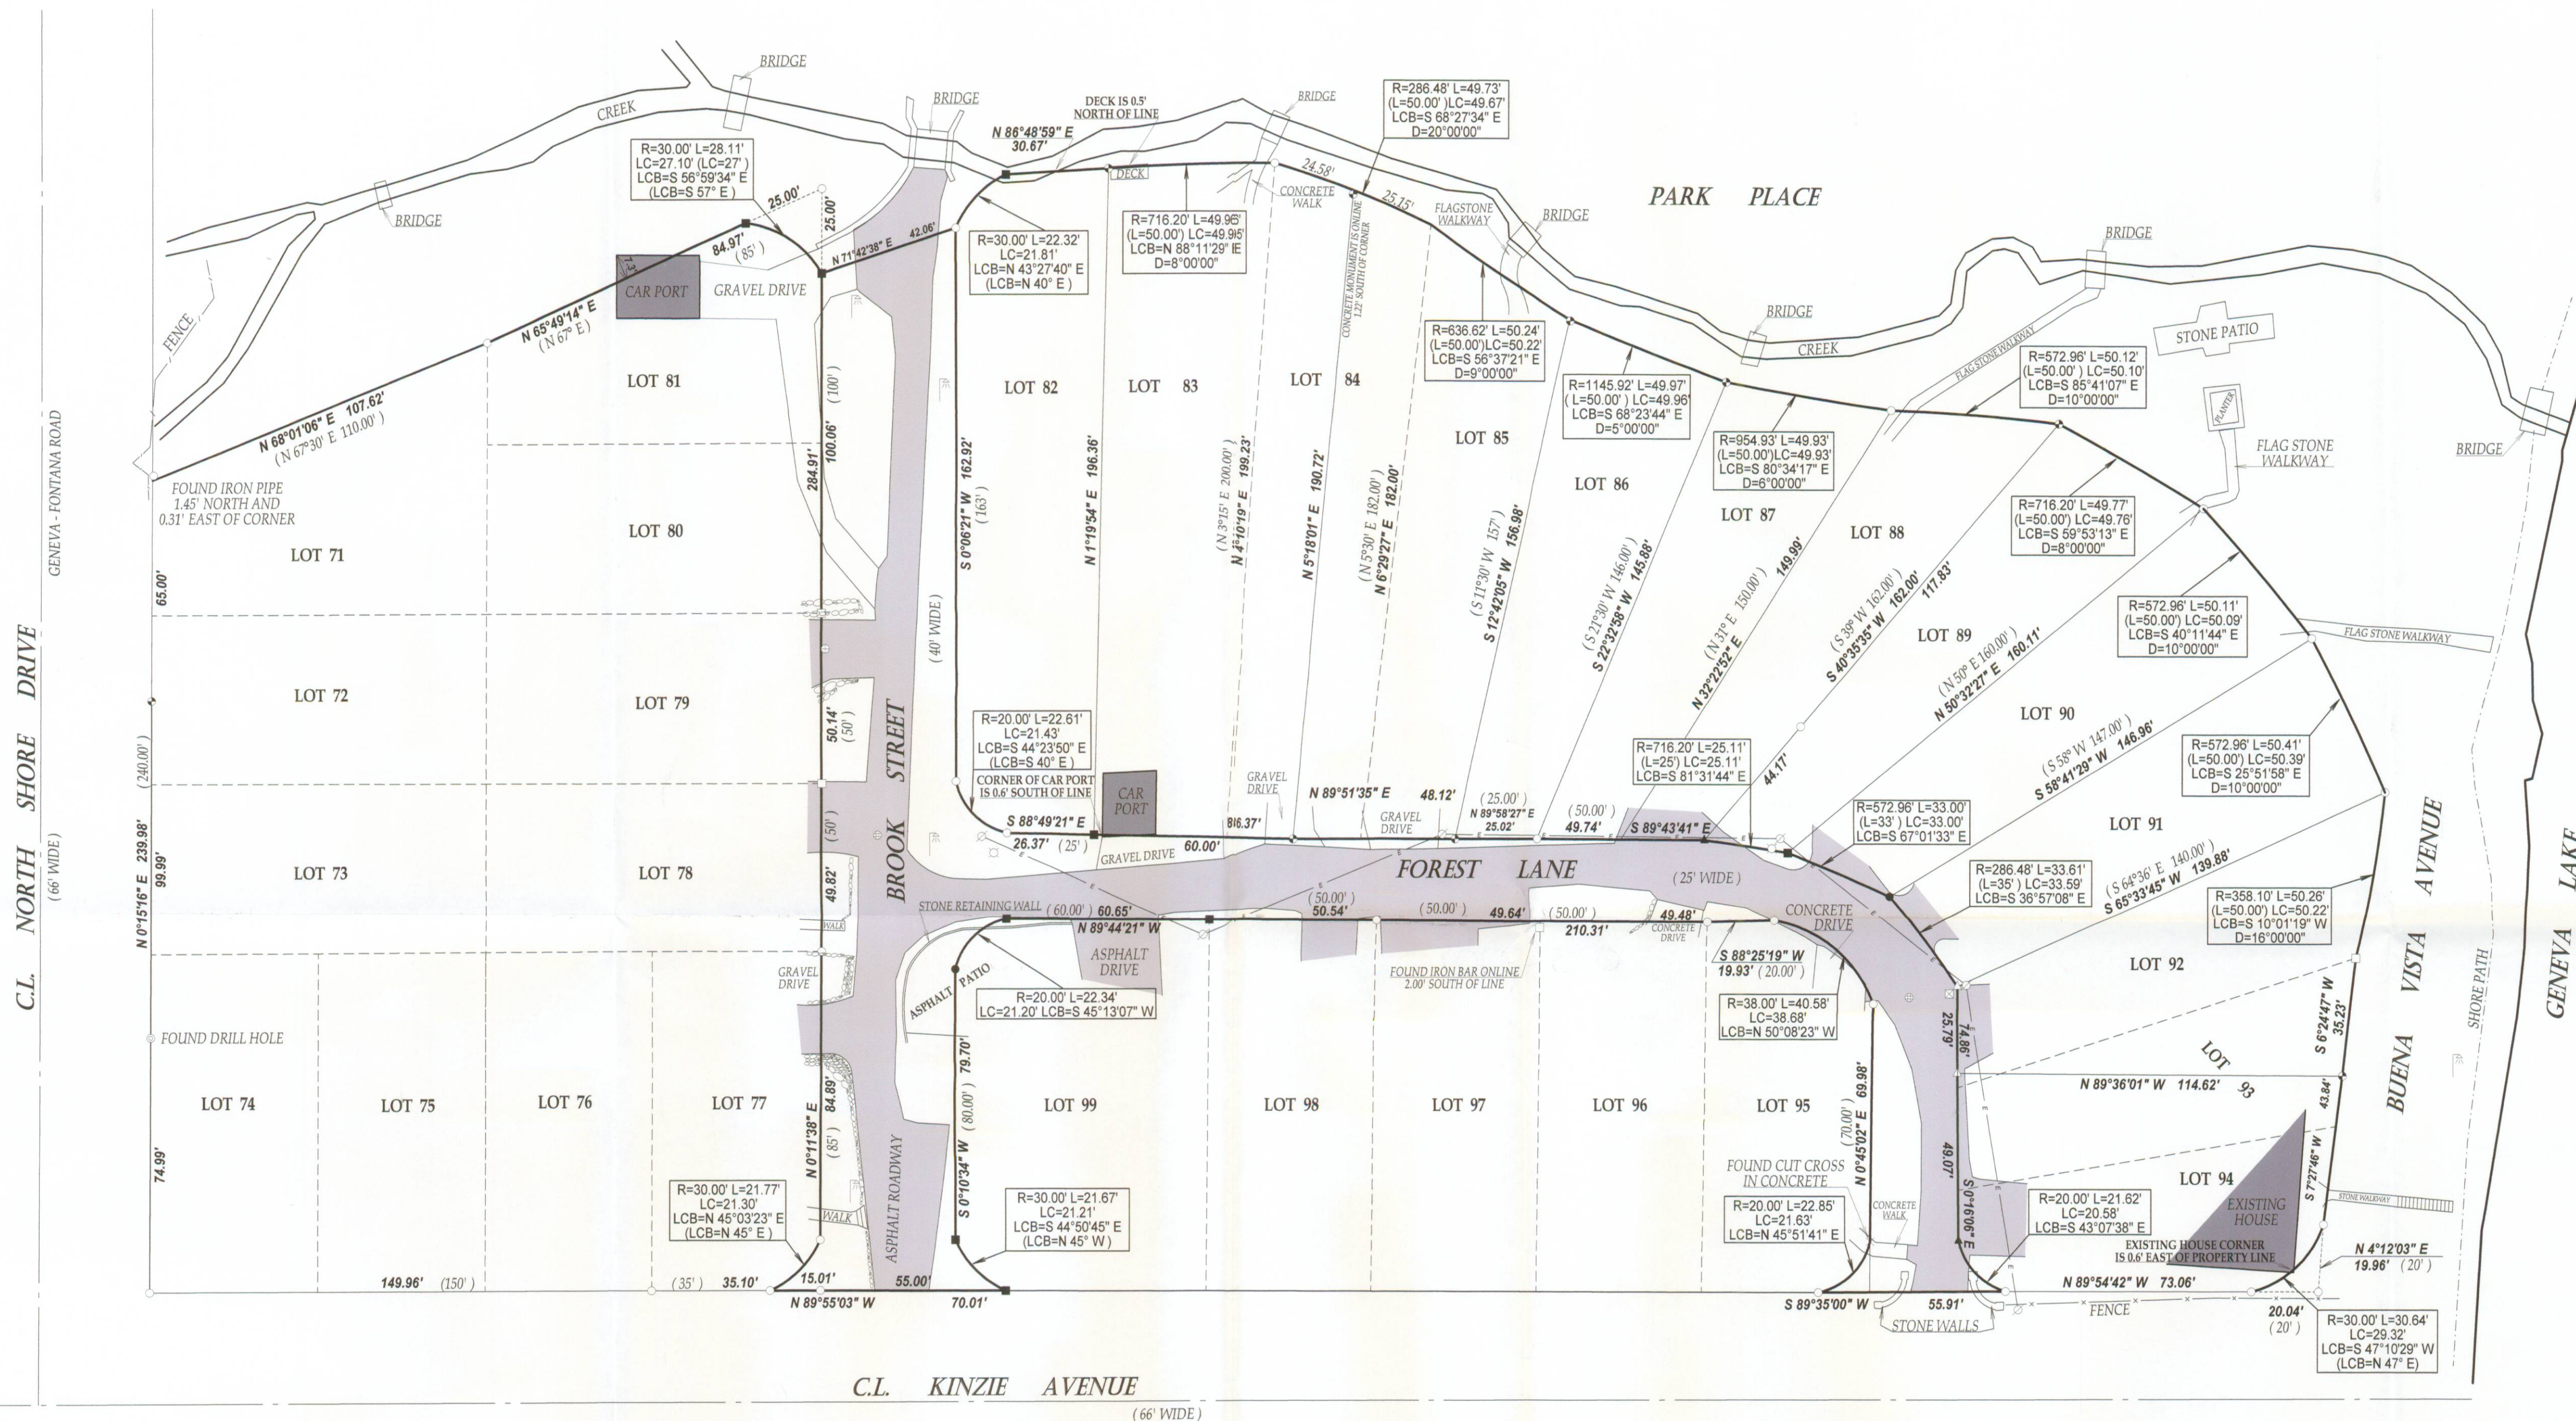


LEGEND

- FOUND IRON PIPE
- FOUND IRON BAR
- △ FOUND P.K. NAIL
- ◆ FOUND CONCRETE MONUMENT
- ▲ SET P.K. NAIL
- SET RAILROAD SPIKE
- SET IRON BAR
- UTILITY POLE
- OVERHEAD WIRES
- FIRE HYDRANT
- ⊕ MANHOLE
- ⊕ YARD BASIN
- ⊕ LIGHT POLE
- ⊕ CATCHBASIN
- ROCK RETAINING WALL
- ⊗ RECORDED AS



JOB # 09-173 TAX ID # SBV

I have surveyed the above-described property and the above map is a true representation thereof and shows the size and location of the property, its exterior boundaries, the location and dimensions of all structures thereon, fences, apparent easements and roadways and visible encroachments, if any.

This survey is made for the exclusive use of the present owners of the property, and also those who purchase, mortgage, or insure the title thereto within one (1) year from date hereof; and as to them I warrant the accuracy of said survey map.

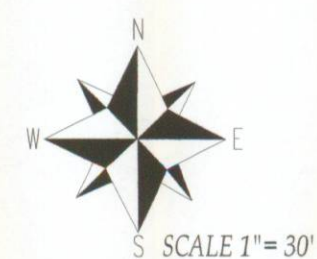

NOTE: BEARINGS REFERENCED TO THE RECORDED SUB. PLAT

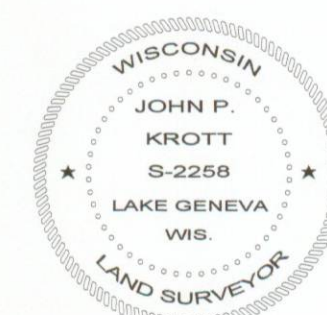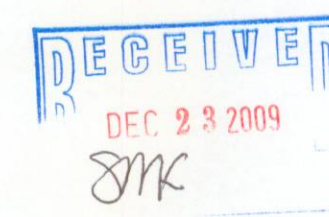

DATED THIS 25th DAY OF NOVEMBER 2009.

JOHN KROTT S - 2258
Wisconsin Registered Land Surveyor
(original if signed in red)

SBV-60 SBV-61 SBV-62 SBV-63 SBV-64 SBV-65 SBV-66 SBV-67

005-270101