
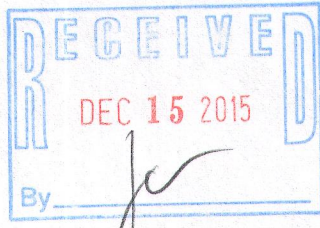
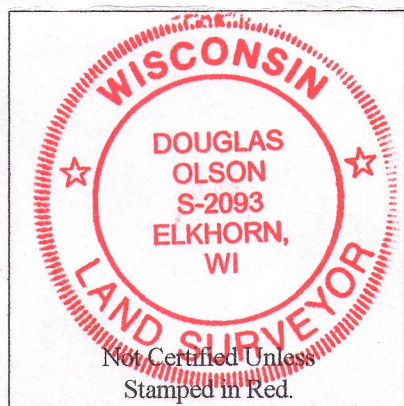


Plat of Survey

of
Lot 6 and the East 50' of Lot 7 in Block 1 of
Assessors Plat No. 1 C.L. Douglass Subdivision,
located in the Northeast 1/4 of Section 15, Town 1 North, Range 16 East,
Village of Fontana-on-Geneva Lake, Walworth County, Wisconsin.

Surveyed for: **Ron & Shirley Kastein**
N3581 Oak Hill Street
Delavan, Wisconsin. 53115

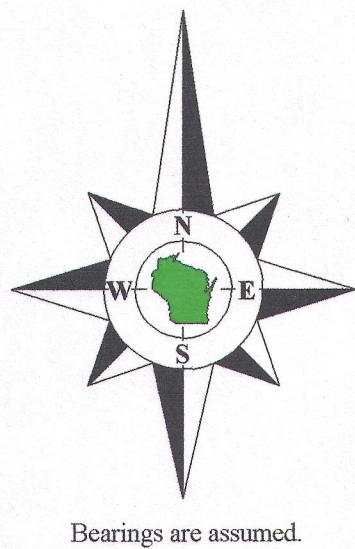

Notes:

- 1) This survey plat is not certified unless signed and sealed in red ink.
- 2) This survey is subject to Wisconsin lien laws. This Plat of Survey is the notice of intent to file lien. Lien waiver required.


Copyright 2015 by Olson Land Surveying, LLC.

All rights reserved. No part of this survey plat may be reproduced or transmitted in any form by any means - graphic, electronic, or mechanical, including photocopying, tracing, or information storage and retrieval systems - without permission in writing from Douglas G. Olson, Olson Land Surveying, LLC.

I hereby certify that I have surveyed the above described property and the map hereon is correct to the best of my professional knowledge and belief and shows the size and location of the property, its exterior boundaries, the location and dimensions of all visible structures thereon, boundary fences, apparent easements and roadways and visible encroachments, if any.


This survey is made for the exclusive use of the present owners of the property, and also those who purchase, mortgage or guarantee title thereto, within one year from the date hereof.

Douglas G. Olson
Wisconsin Professional Land Surveyor - 2093

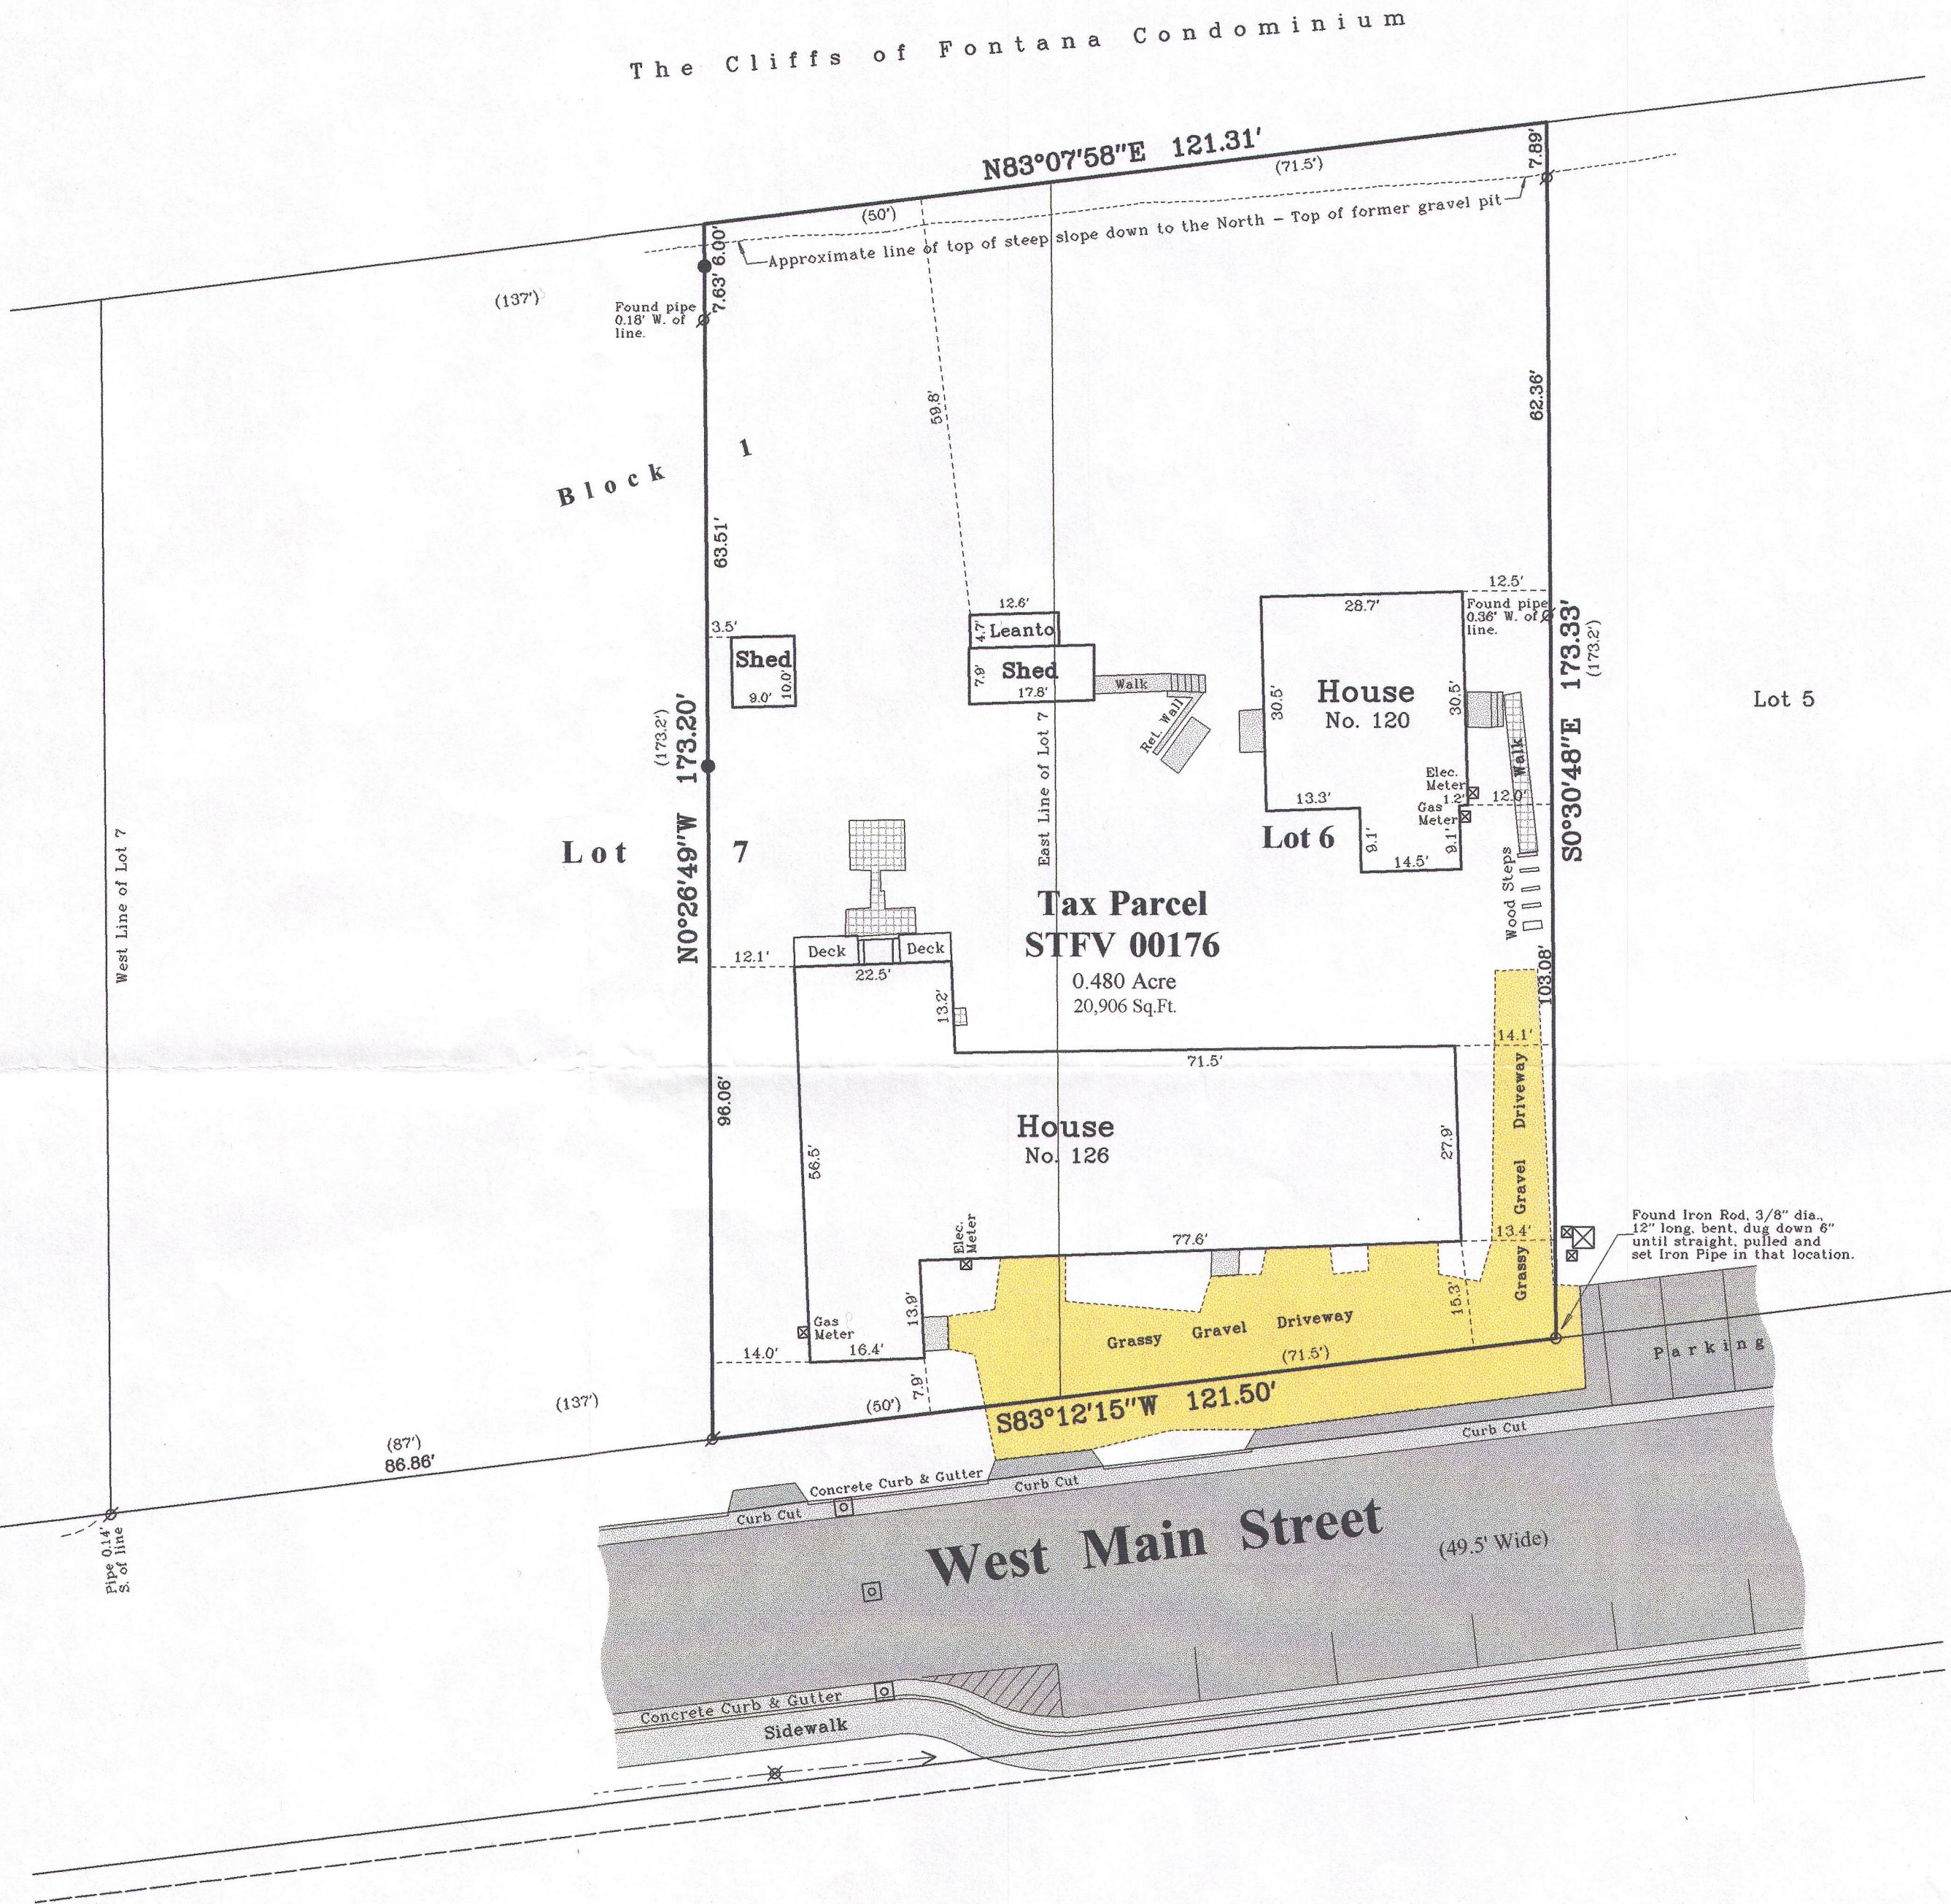

87FV-176 005-3703

Survey Date: October 13, 2015.
Revisions: No. 1 - Found Concrete Monument & Set Property Corner

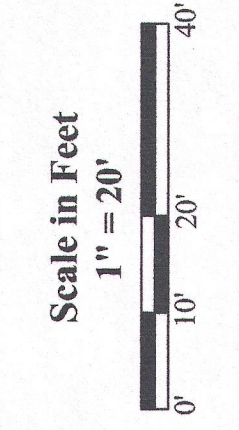

Olson Land Surveying, LLC
45 South Wisconsin Street * P.O. Box 322 * Elkhorn, Wisconsin. 53121
Telephone: (262) 723-3434 * Facsimile: (262) 723-8044
Email: doug@olsonsurveying.com

Legend
Found Iron Pipe, 1" dia.
Found Iron Rod, 3/4" dia.
Set Iron Pipe, 1" dia.
Recorded Information
Utility Pole
Catch Basin
Asphalt Surface
Concrete
Brick Pavers
Gravel

Sheet 1 of 1 Sheets
Drawing Name:
Job Reference Number
2015.099

2015.099