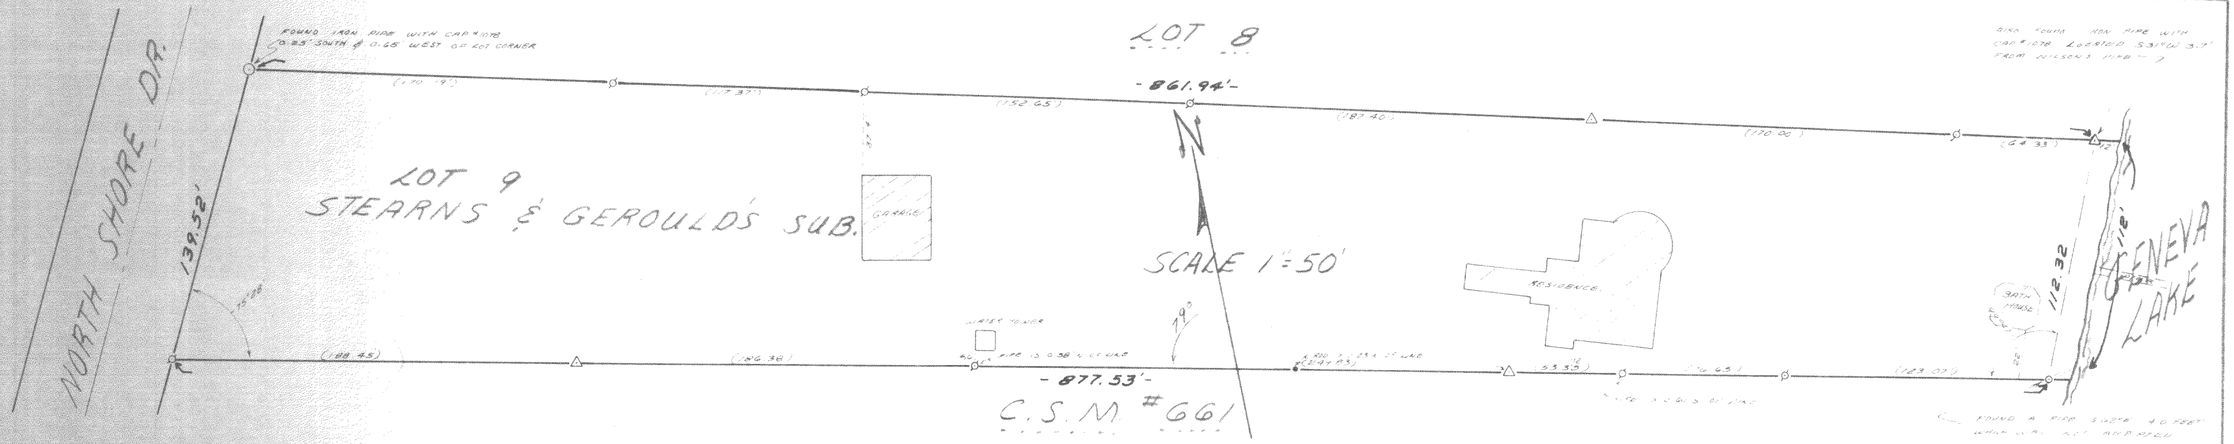

LEGEND

Ø = Found Iron Pipe shown on earlier survey by Willson

△ = Found Iron Pipe shown on earlier survey by Willson and used as primary control to reconstruct survey

• = Found iron rod indicated on Certified Survey No. 661

⊕ = Set Iron Pipe survey stake

(xxx) = Dimension indicated on Willson survey

Legal description of land surveyed

Lot 9 of Stearns and Gerould's Subdivision located in the South 1/2 of Section 11, Town 1 North, Range 16 East, Village of Fontana-on-Geneva Lake, Walworth County, Wisconsin.

Work ordered by Carl Reevs for Keefe Real Estate, Inc.

REVISED SEPT. 18, SEPTEMBER 1980

Dated this 18 day of Sept, 1980

Daniel D Cooper

Daniel D. Cooper, RLS No. S-1464

I hereby certify that I have surveyed the property described hereon; that this Plat of Survey is a retracement of a Plat of Survey of this same parcel done by George B. Wilson dated October 5th, 1966 and correctly shows the dimensions of the boundary and location of all principal structures located theron to the best of my professional knowledge and belief.

WISCONSIN
DANIEL D. COOPER
S-1464
EAST TROY, WIS.
LAND SURVEYOR

FARRIS, HANSEN & COOPER, INC.
ENGINEERING, SURVEYING AND LAND PLANNING
715 W. WALWORTH ST. - P.O. BOX 487 - ELKHORN, WI 53121

SEPT. 18, 1980

PROJECT 1751

5-421-F