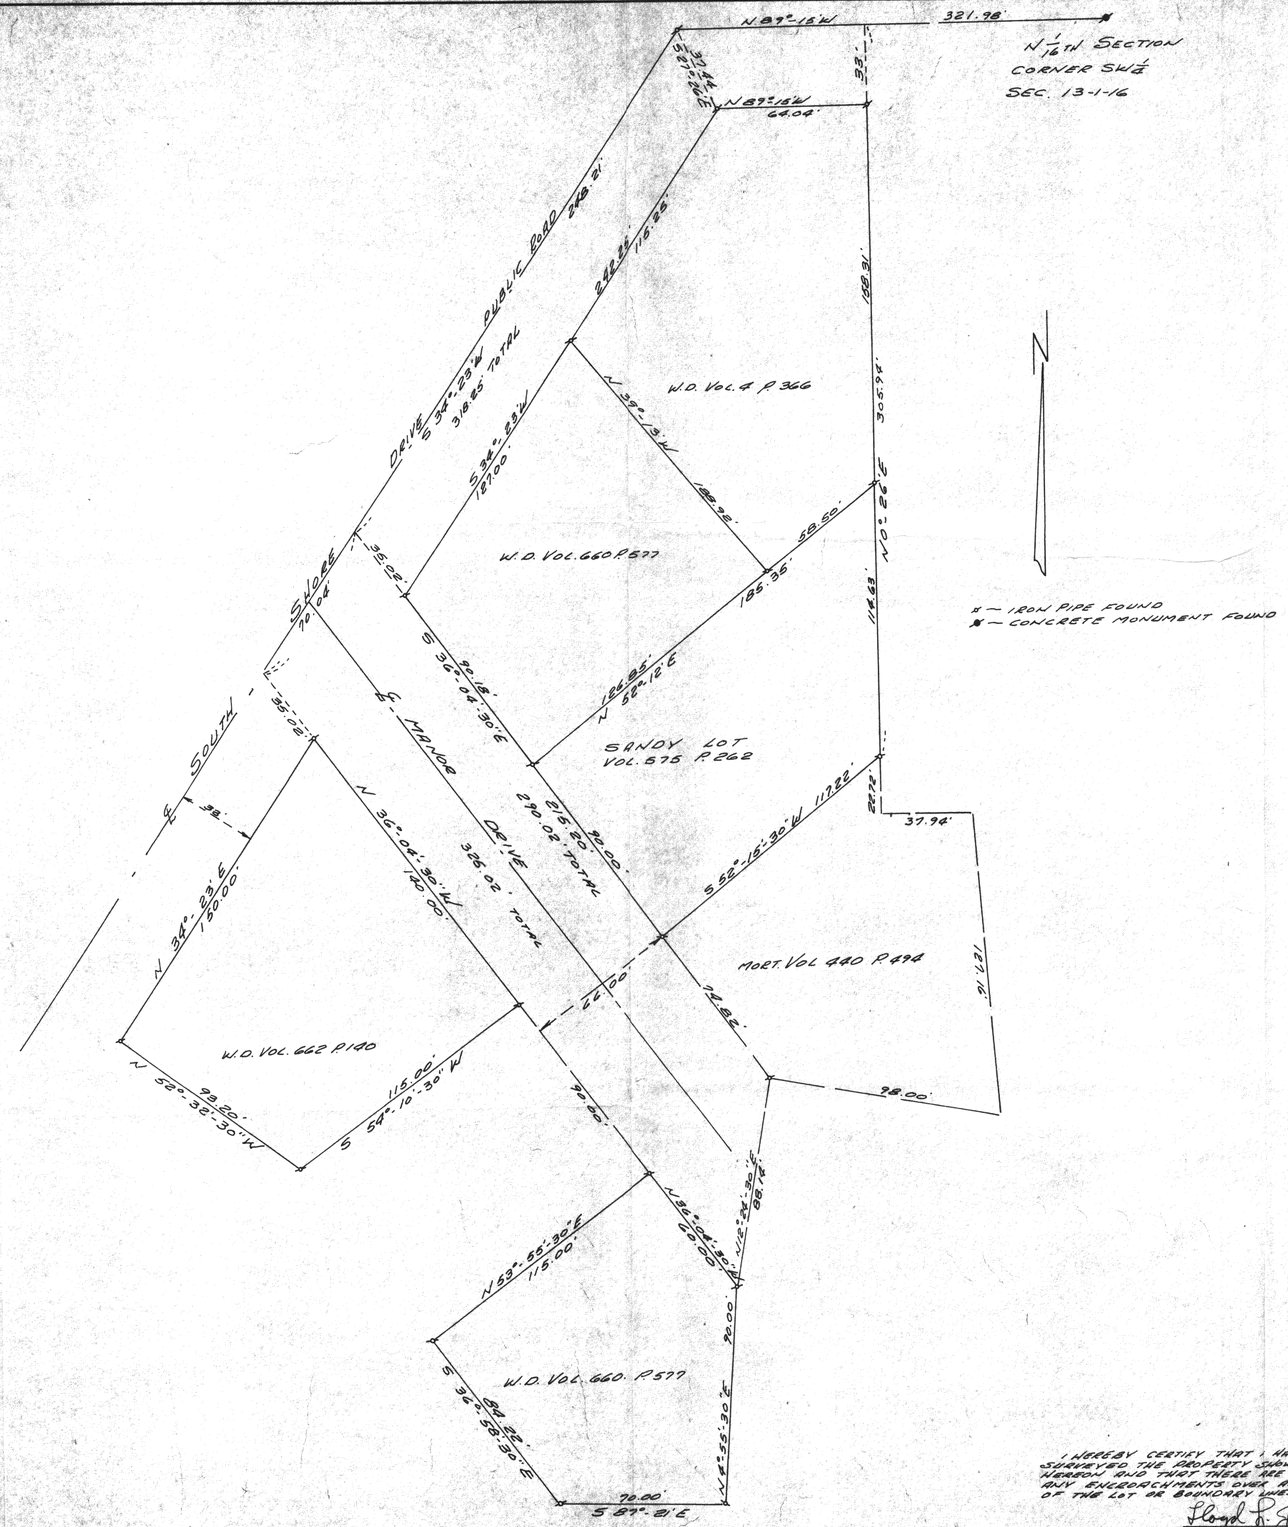

I HEREBY CERTIFY THAT I HAVE SURVEYED THE PROPERTY SHOWN HEREON AND THAT THERE ARE NOT ANY ENCROACHMENTS OVER ANY OF THE LOT OR BOUNDARY LINES.

Lloyd L. Jensen

LLOYD L. JENSEN S-211

WISCONSIN LLOYD L. JENSEN S-211 ELKHORN, WIS. LAND SURVEYOR

DETAIL 2

PLAT OF SURVEY OF PART OF OUT LOT B1 ASSESSOR'S PLAT NO. 1 AMENDED, LOCATED IN SW¼ SEC. 13, T1N R16E, VILLAGE OF FONTANA, WALWORTH COUNTY, WISCONSIN.

DRAWN BY T.A.P. JENSEN	JENSEN & JOHNSON CIVIL ENGINEERS ELKHORN, WIS.	SCALE: 1"=30'
CHECKED BY Lloyd L. Jensen		REVISED
APPROVED BY	DATE OCT 1970	SHEET NO. OF

REVISED OCT 14, 1970

5-556

Ex. 1/2 B.C.T.D. 1 EX. 125 ; ~~[illegible]~~ F ; Code #10

KAS 10-7185 300-12-67