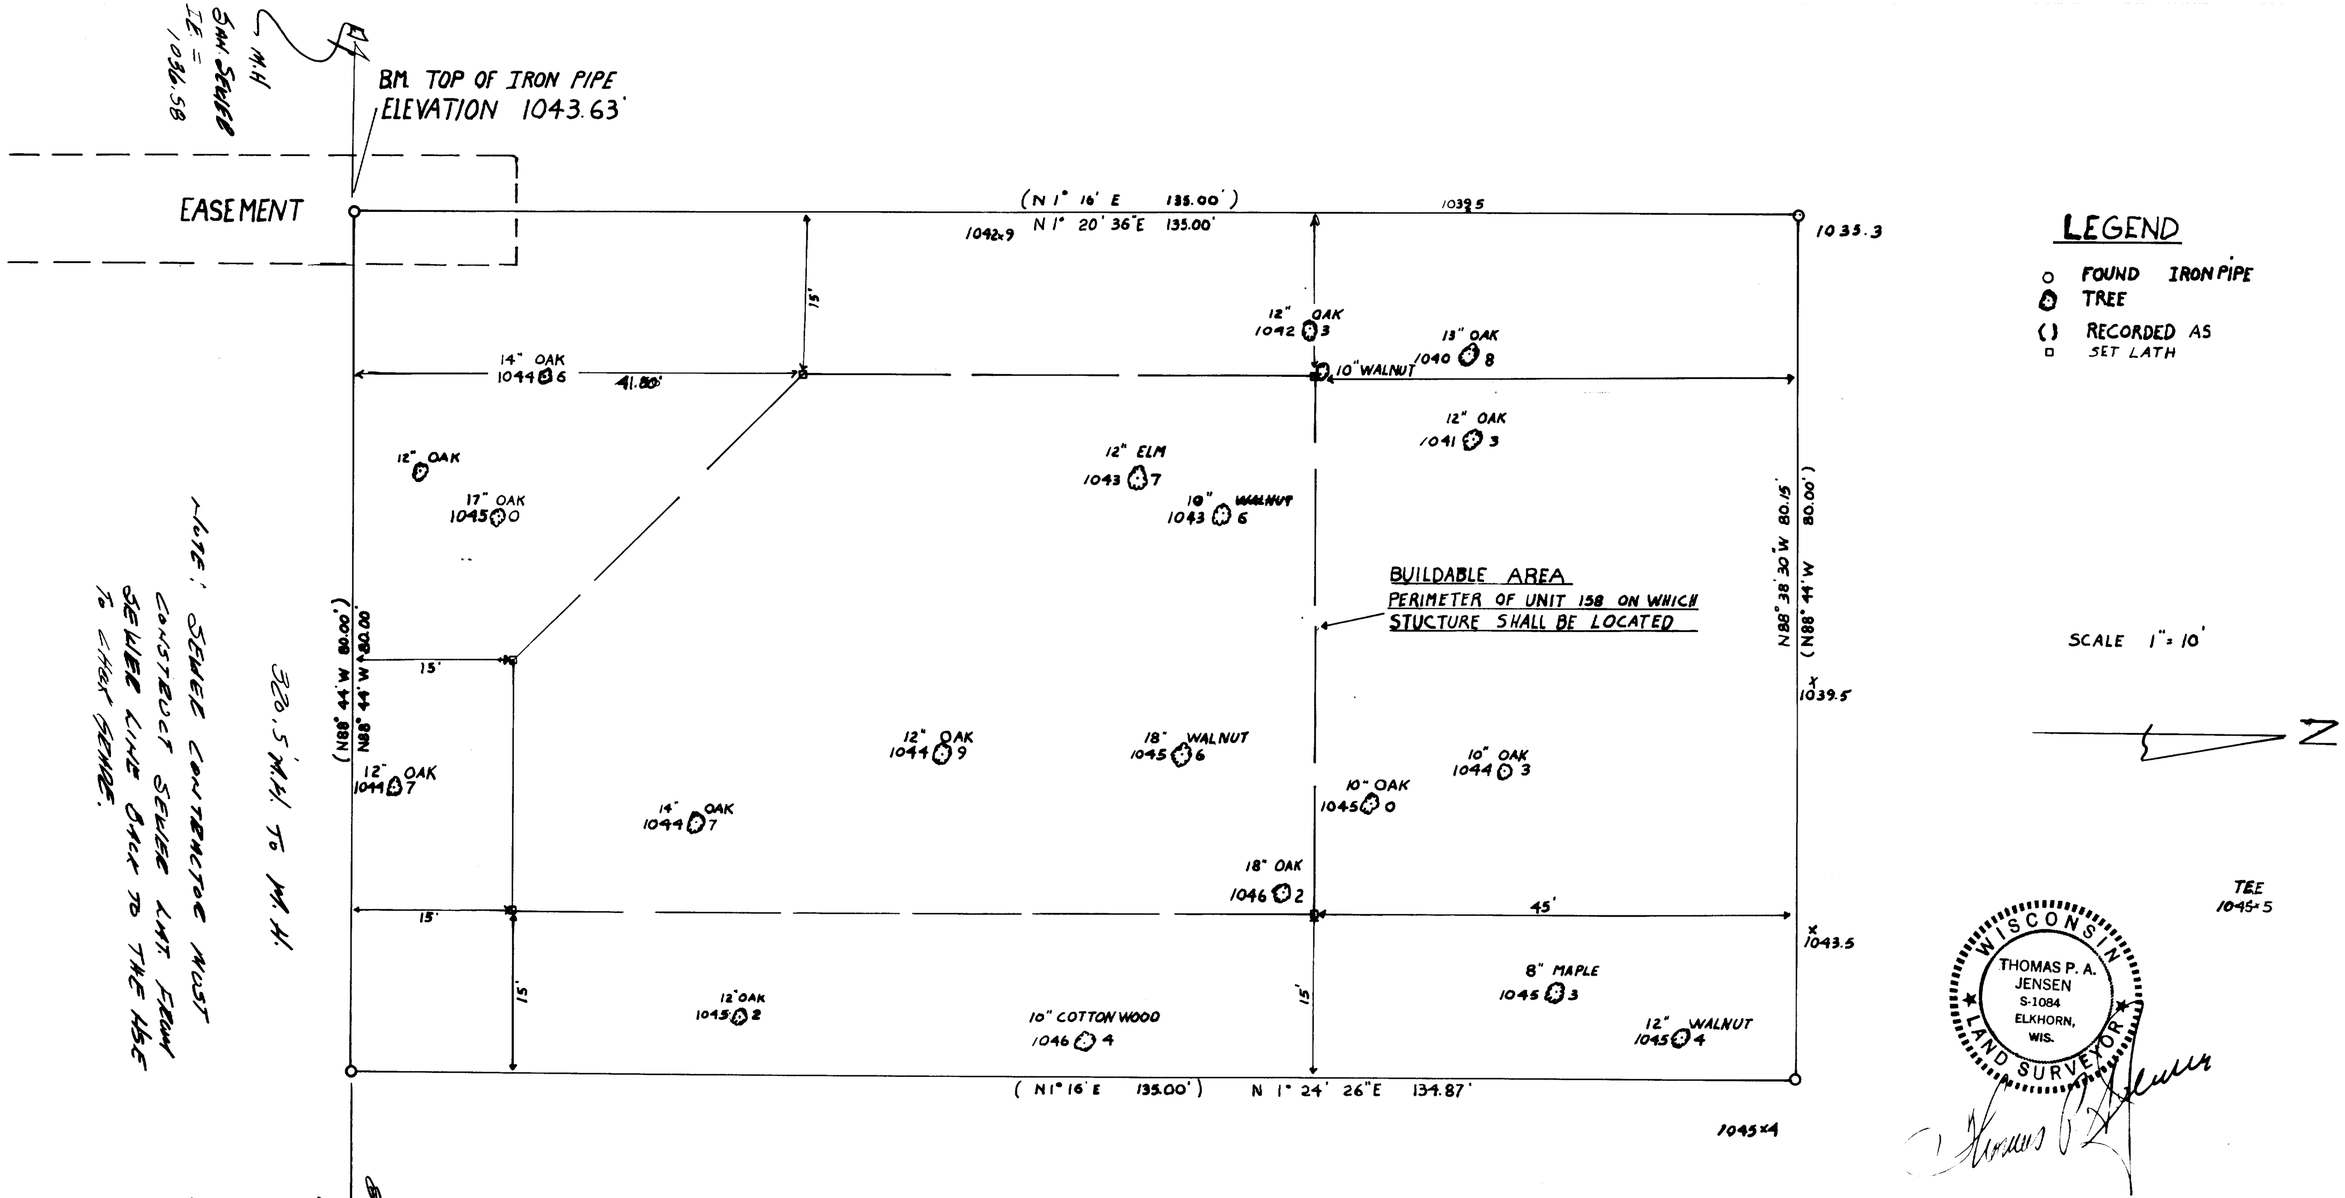

LEGEND

- ○ FOUND IRON PIPE
- ⊙ TREE
- ( ) RECORDED AS
- □ SET LATH

SCALE 1" = 10'

N

WISCONSIN
THOMAS P. A. JENSEN
S-1084
ELKHORN, WIS.
LAND SURVEYOR

JENSEN SURVEYING & MAPPING S.C.
P.O. BOX 322
ELKHORN, WI 53121
(414) 723-3434

SURVEYED BY: THOMAS P.A. JENSEN R.L.S. # 1084

SURVEYED FOR: ROBERT E. DUKE
111 SOUTH WILSHIRE LANE
ARLINGTON HEIGHTS ILL. 60004

PLAT OF SURVEY OF UNIT 158 OF
ABBEY SPRINGS CONDOMINIUM NO V
VILLAGE OF FONTANA-ON-LAKE GENEVA
WALWORTH COUNTY, WISCONSIN

MAPPING DATE: 5-30-83

1983.023

5-606