



DUNHAM SURVEYING, S.C.
SURVEYING & SUBDIVIDING
• DELAVAN, WISCONSIN 53115

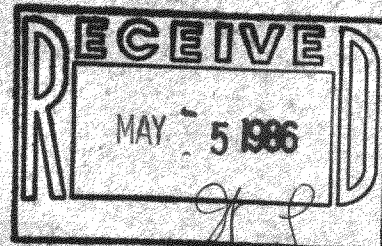

Scale - 1" = 20'
• = Concrete Monument Found
○ = 1 1/4" Iron Pipe Found and reset
Bearings referenced to the northwesterly line
of Lot 76 with the assumed bearing of N40°00'E
Survey ordered by: Walter Minor
1314 Good
Park Ridge, IL 60068

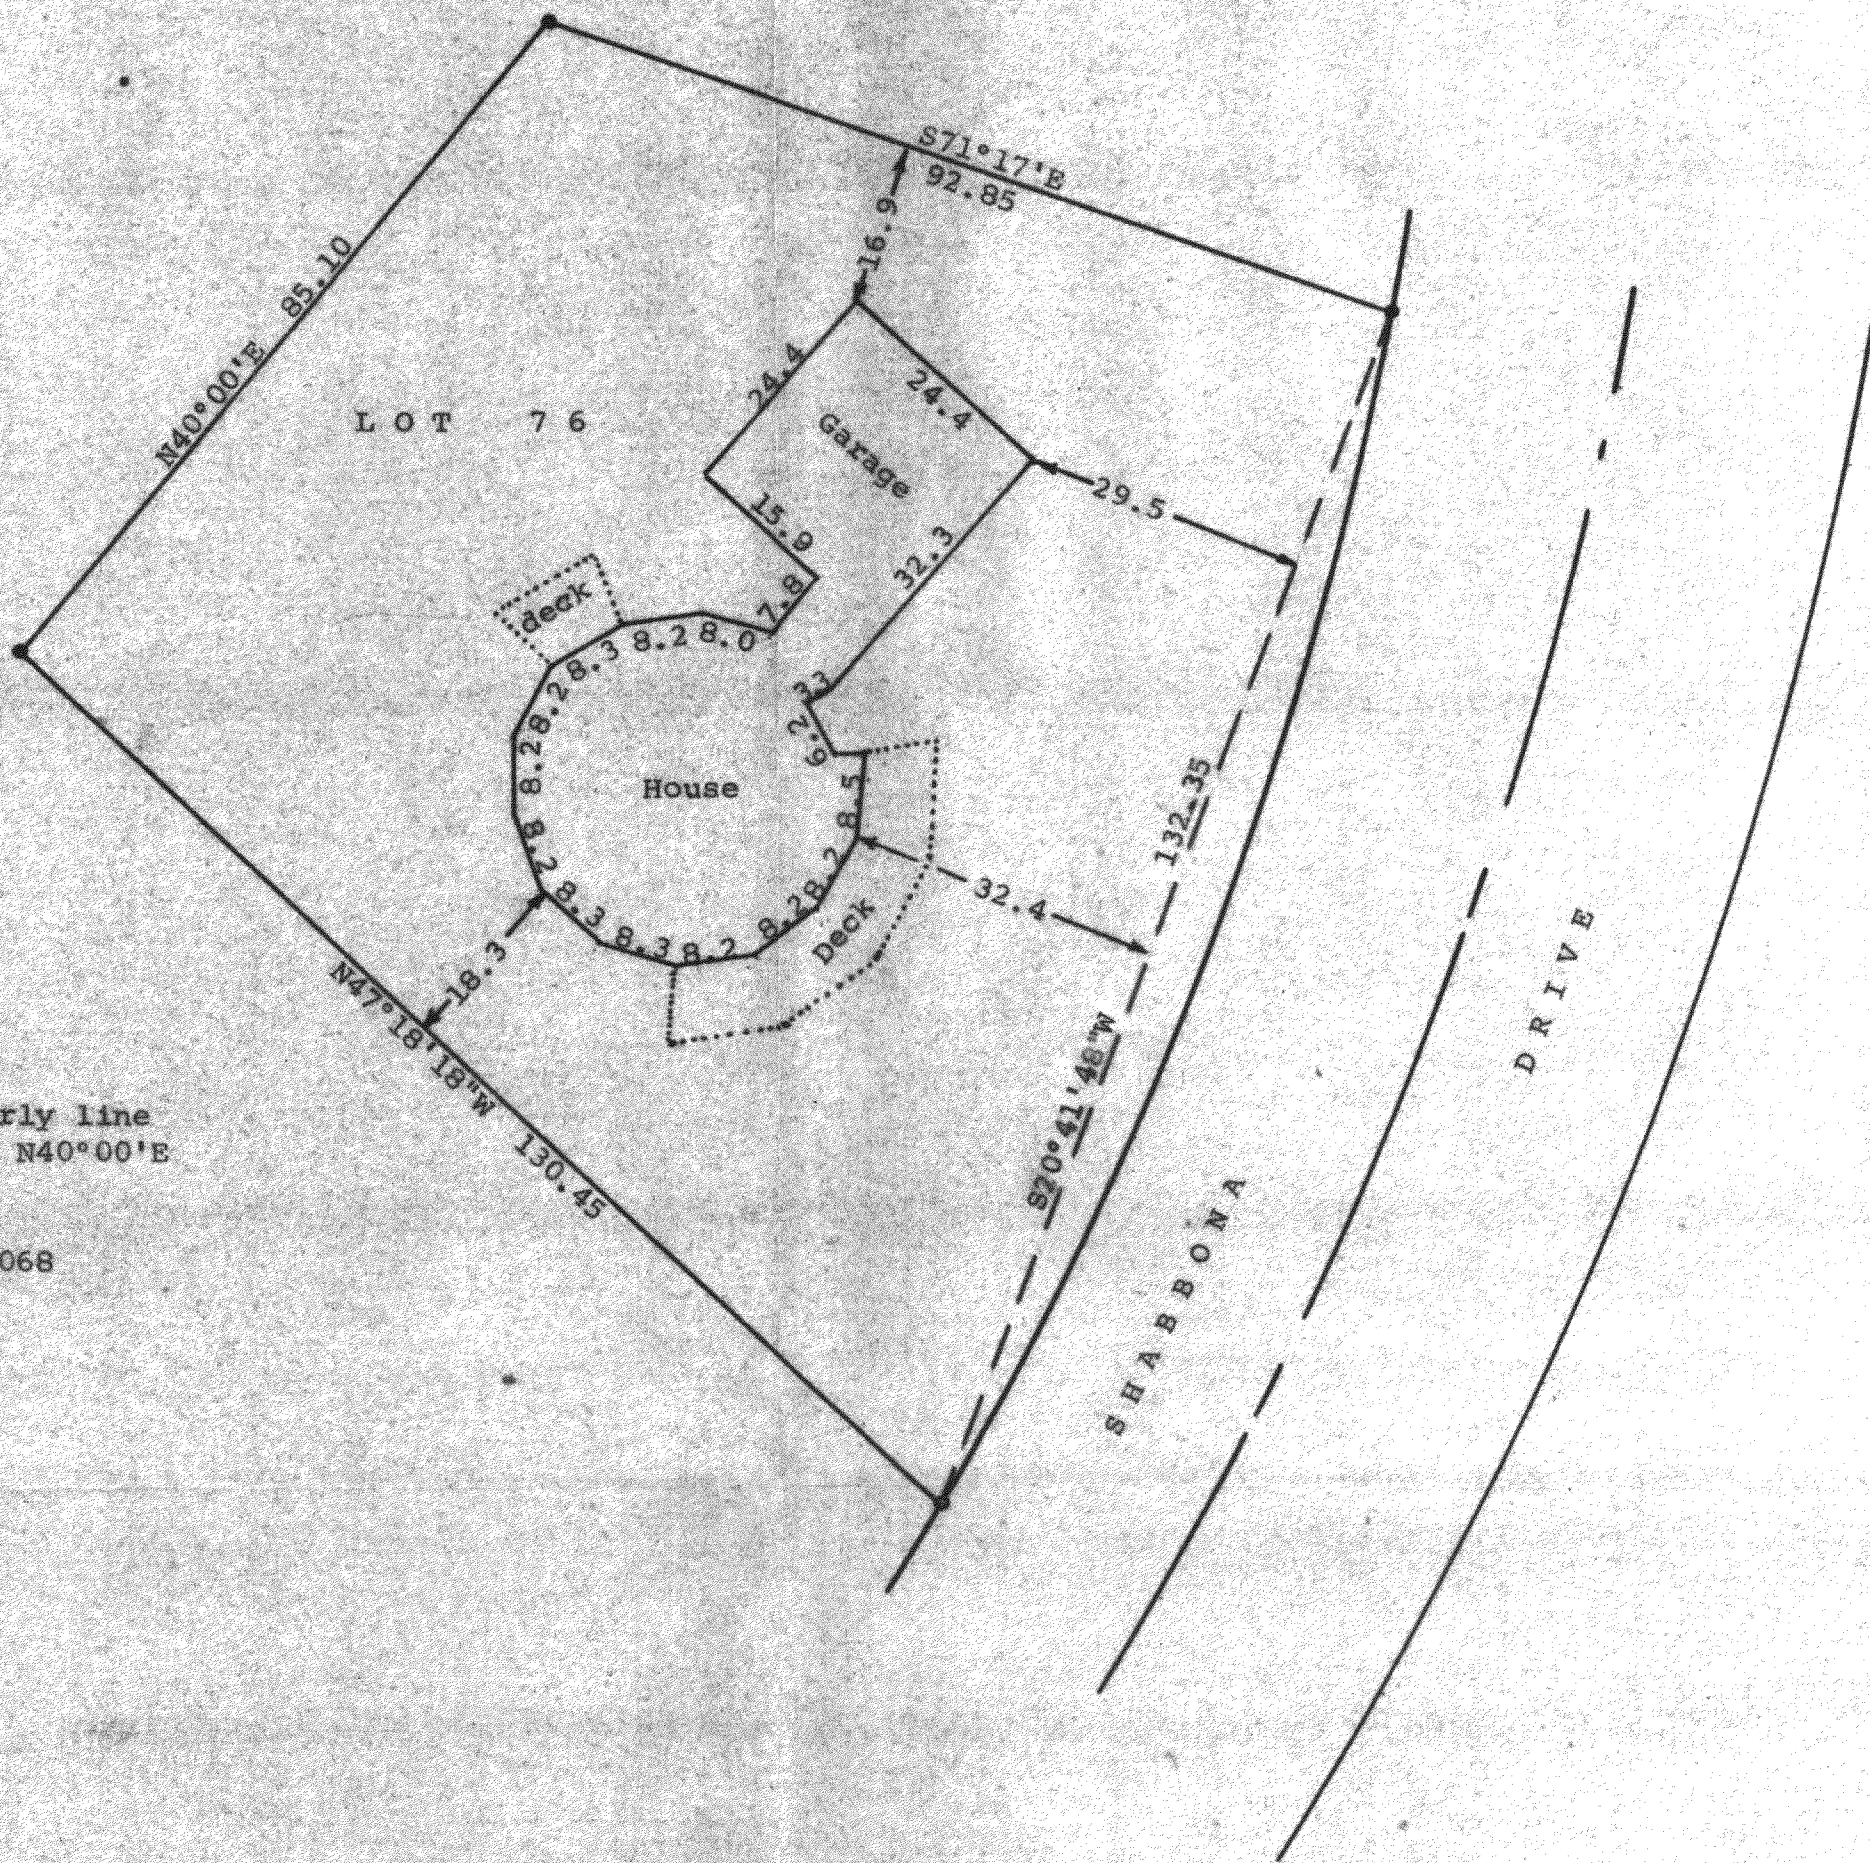

STATE OF WISCONSIN)
COUNTY OF WALWORTH)

I, George T. Dunham, Surveyor, certify that I have surveyed
the property described as follows:

Lot 76 in Country Club Estates Unit No. 2 located in the
Village of Fontana-on-Geneva Lake, Walworth County, Wisconsin,
and that the map shown above is a true representation thereof and shows
the size and location of the property, its exterior boundaries, the
location of all visible structures and dimensions of all principal buildings
thereon, boundary fences, apparent easements, roadways and visible
encroachments, if any, and that I have surveyed the property hereon
described according to the official records to the best of my knowledge
and belief.
April 22, 1986

George T. Dunham
George T. Dunham, Surveyor