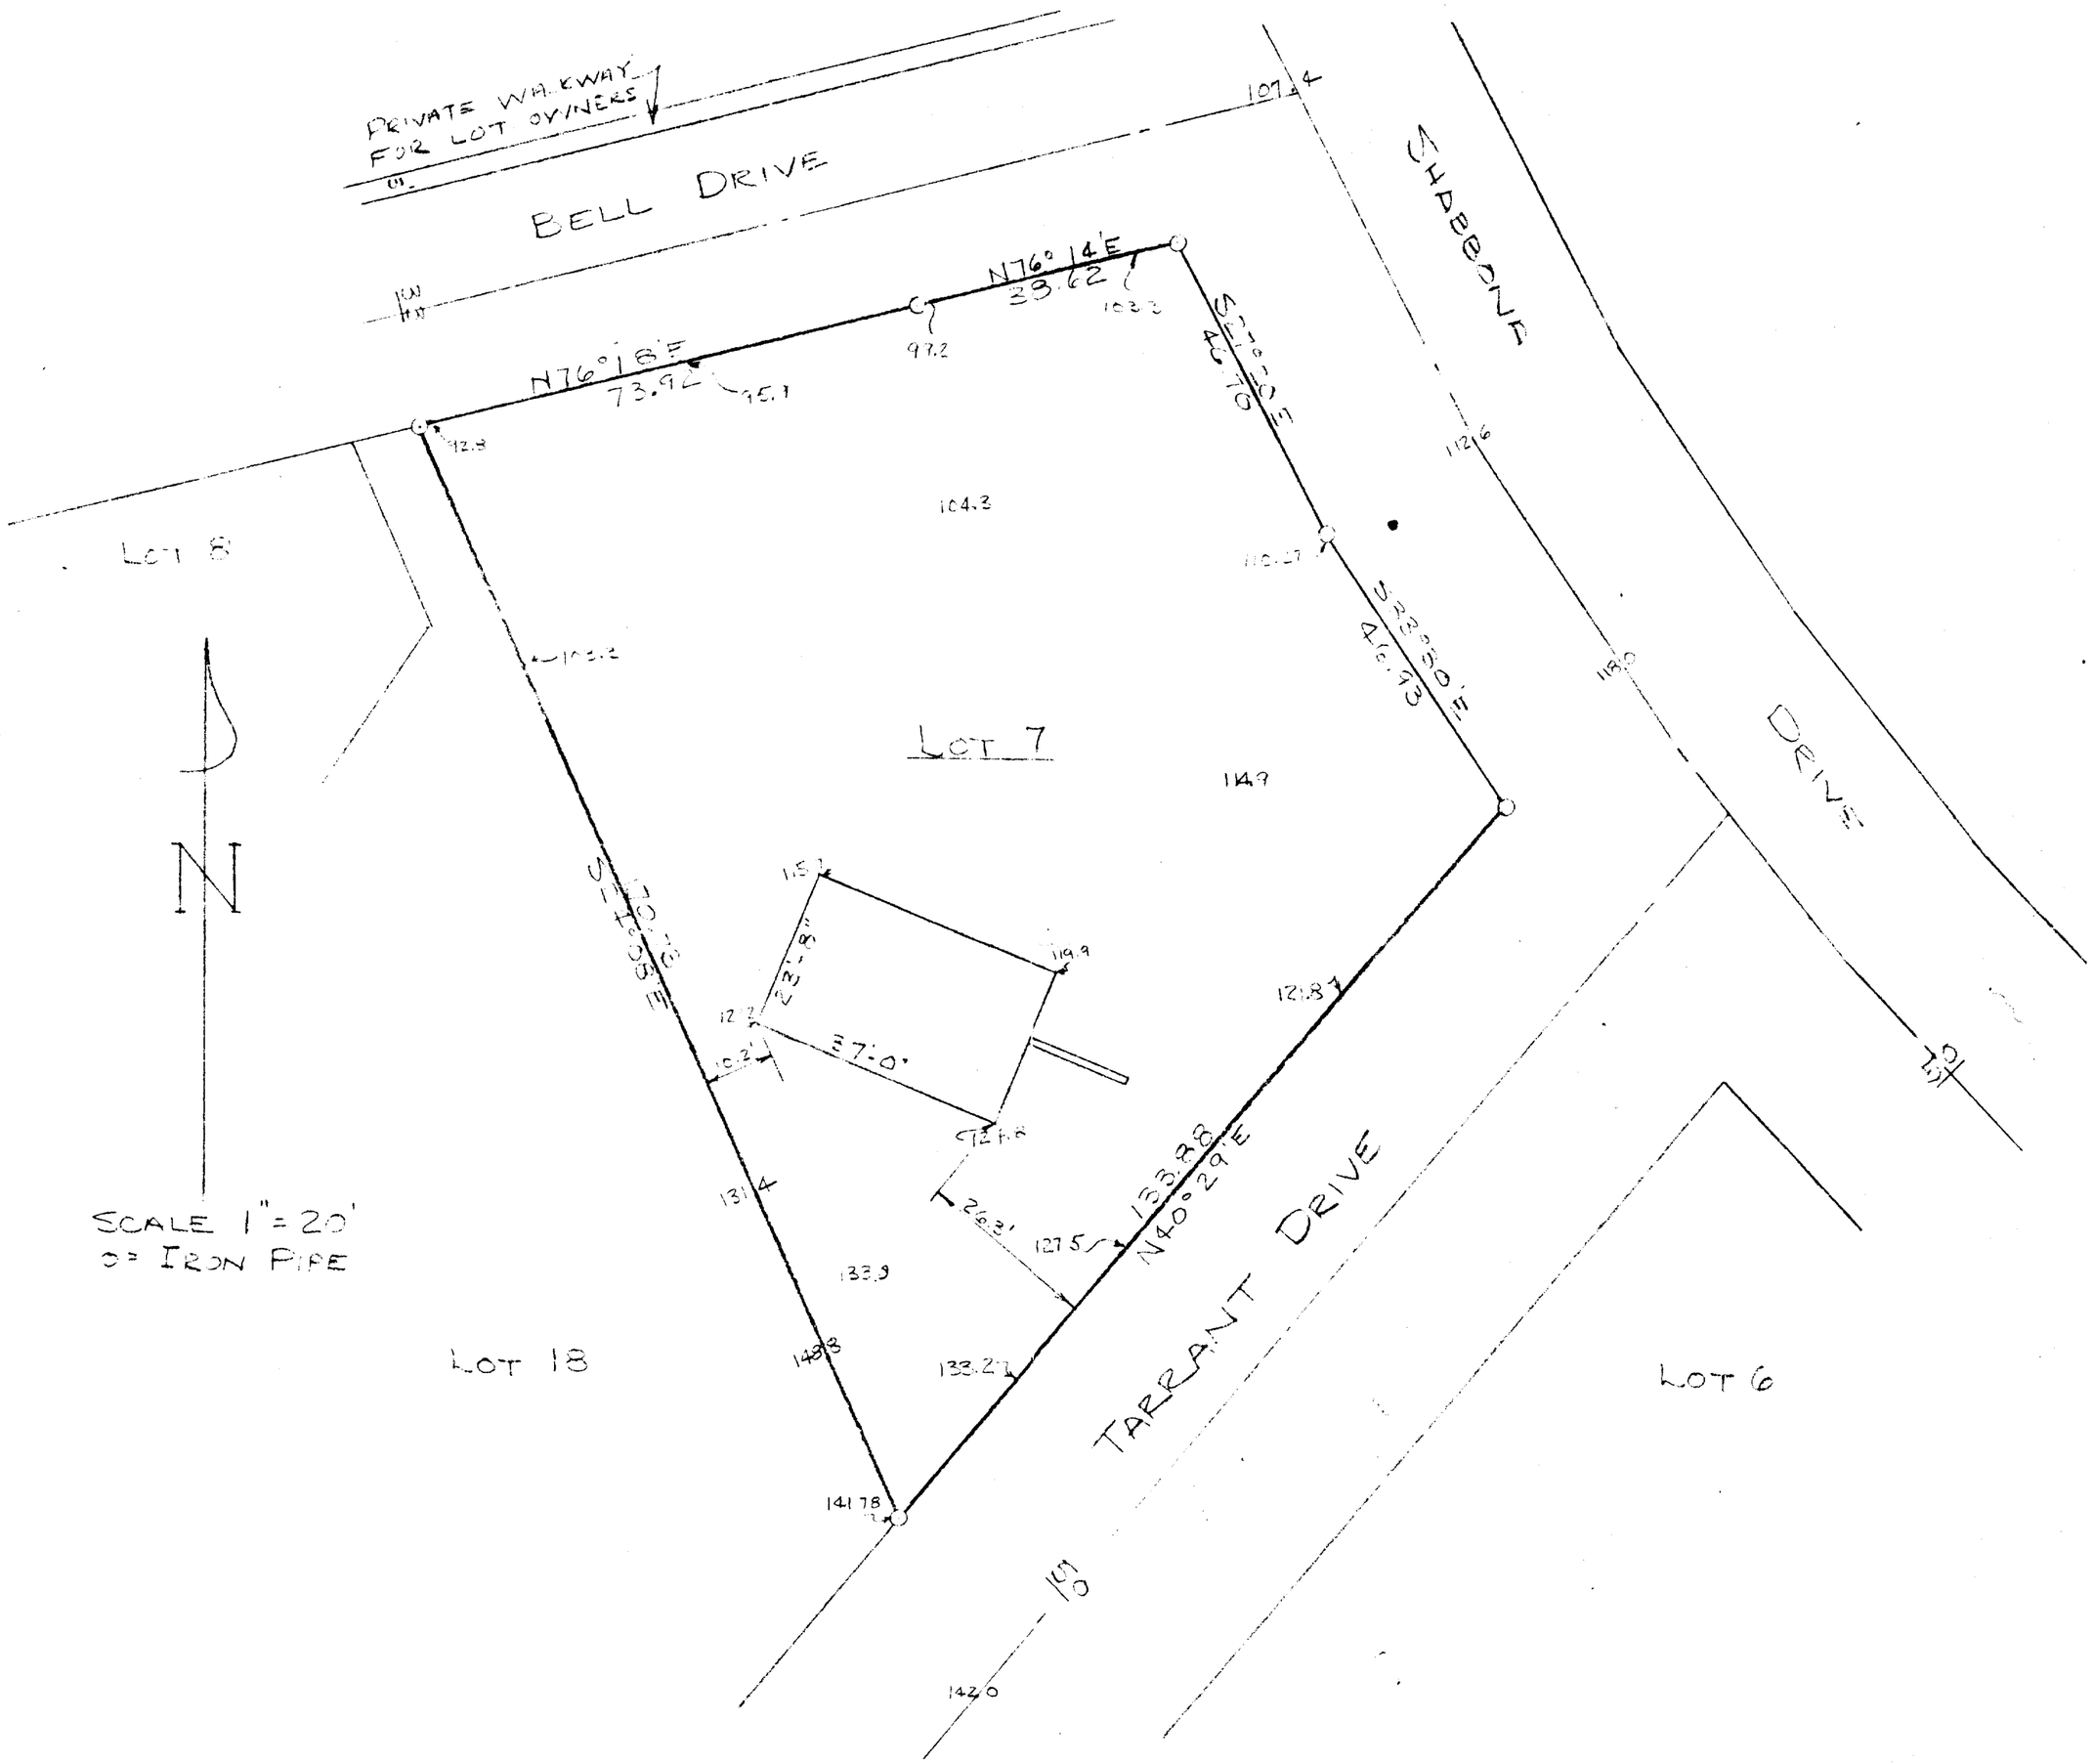

STATE OF WISCONSIN)
COUNTY OF WALWORTH) SS

I, LLOYD L. JENSEN, DO HEREBY CERTIFY THAT I HAVE SURVEYED THE PROPERTY DESCRIBED, ACCORDING TO THE OFFICIAL RECORDS, AS FOLLOWS:

LOT 7 OF ADDITION Nº 1 TO COUNTRY CLUB ESTATES IN THE VILLAGE OF FONTANA-ON-GENEVA LAKE, WALWORTH COUNTY, WISCONSIN;

AND THAT THE PLAT ABOVE IS A CORRECT REPRESENTATION OF THE LOT LINES AND THE PRINCIPAL LINES OF BUILDINGS THEREON.

ELKHORN, WISCONSIN, SEPT. 1950

Lloyd L. Jensen
COUNTY SURVEYOR

SCT-7

5-74J