


DUNHAM SURVEYING, S.C.
SURVEYING & SUBDIVIDING
DELAVER, WISCONSIN 53115

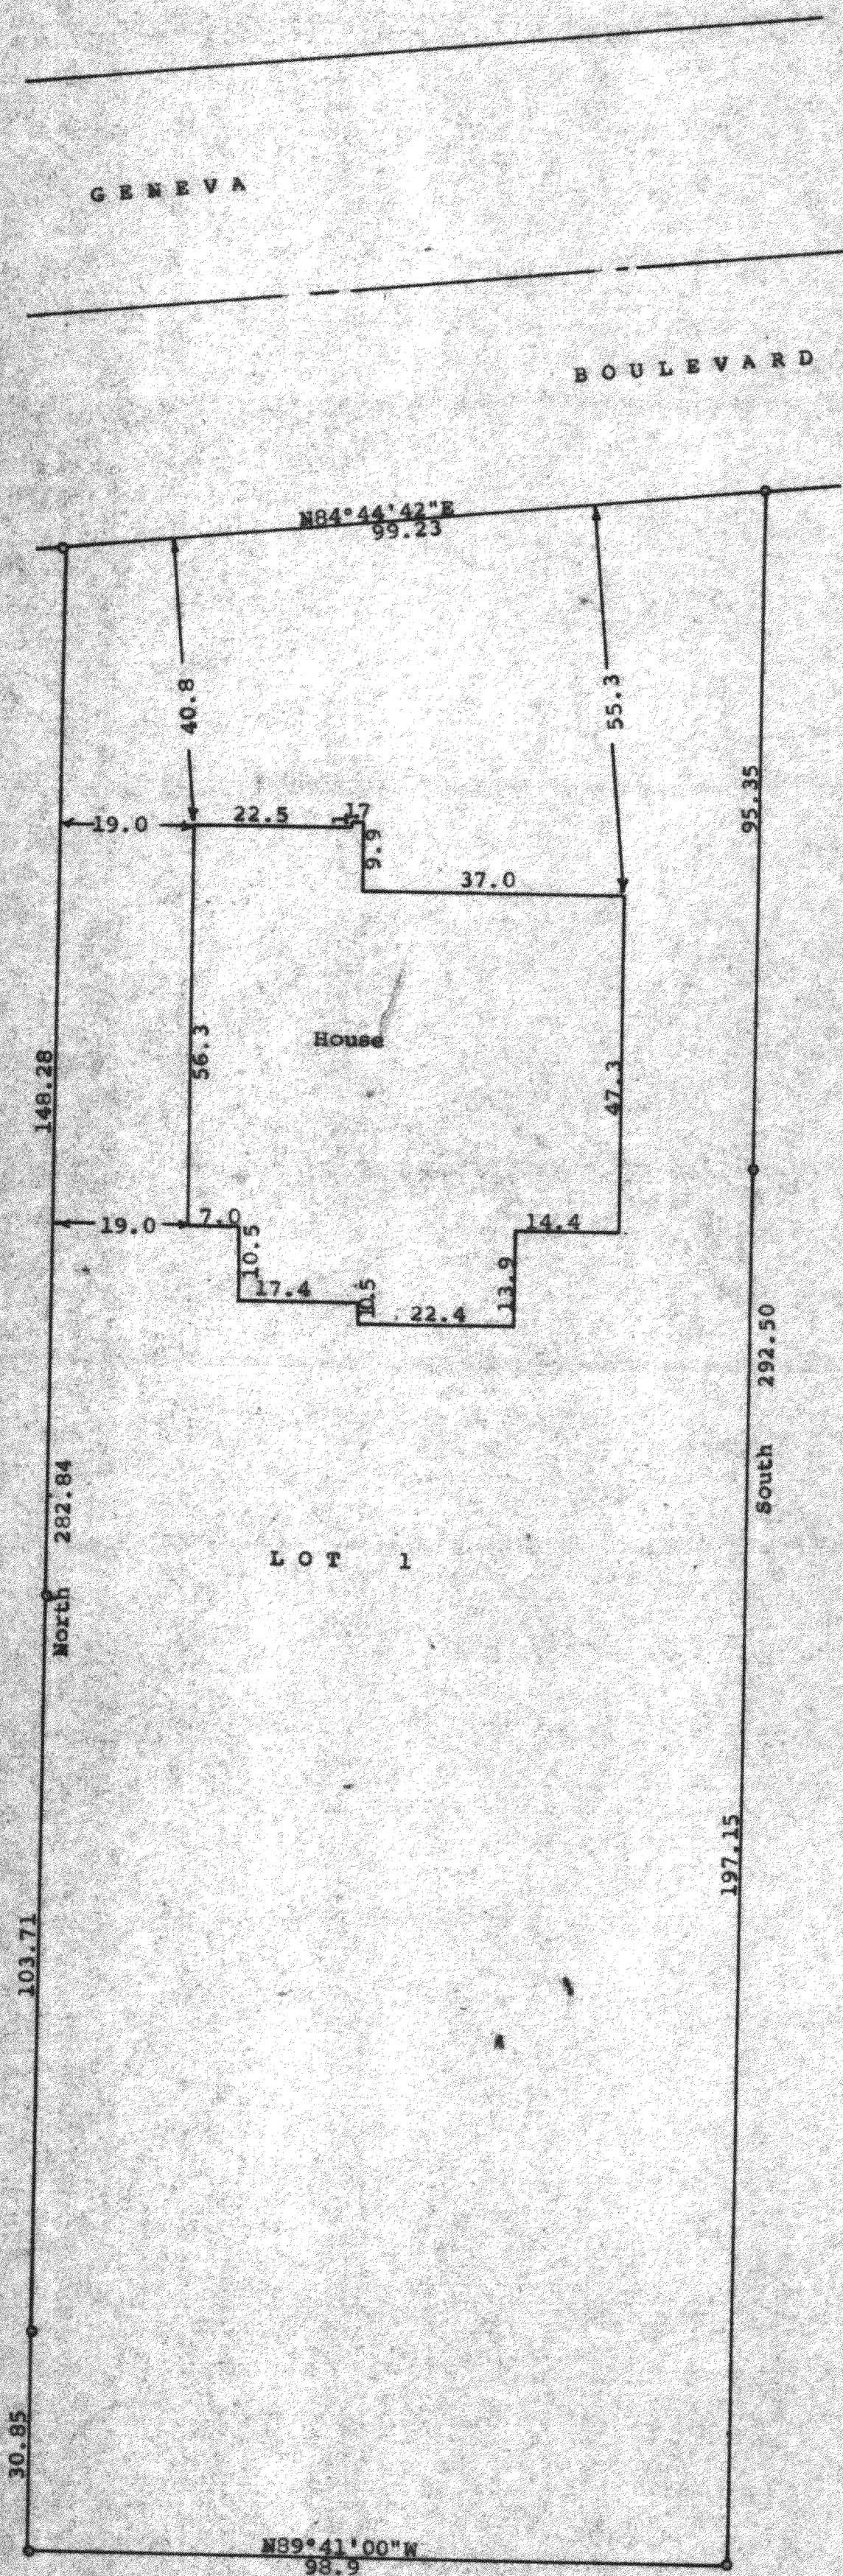


Scale - 1" = 20'
o = 3/4" Iron Pipe Found
Bearings are the same as on the recorded plat
of Certified Survey No. 1037
Owner: Kenneth S. Struck
1216 W. Hintz
Arlington Heights, Ill.

STATE OF WISCONSIN) SS
COUNTY OF WALWORTH)

I, George T. Dunham, Surveyor, certify that I have surveyed the
property described as follows:

Lot 1 of Certified Survey No. 1037, recorded in Volume 5 of Certified
Surveys on Page 1, Document No. 58434 on May 21, 1980, being land
located in O.L. 91 of the Assessors Plat of the Village of Fontana-on-
Geneva Lake, Walworth County, Wisconsin,

and that the plat shown hereon is a correct representation thereof and shows
the size and location of the property, its exterior boundaries, the location
of all visible structures and dimensions of all principal buildings thereon,
boundary fences, apparent easements, roadways and visible encroachments, if
any, and that I have surveyed the property hereon described, according to the
official records, to the best of my knowledge and belief.
May, 1988

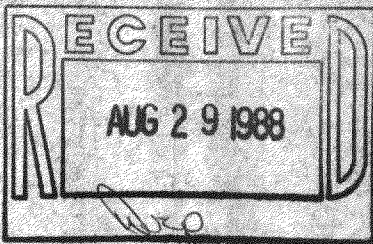

George T. Dunham
George T. Dunham, Surveyor

