



FARRIS, HANSEN & ASSOCIATES, INC.
Engineering, Surveying and Land Planning
715 W. Waiworth St. P.O. Box 487
ELKHORN, WISCONSIN 53121
Office: (414) 723-2098

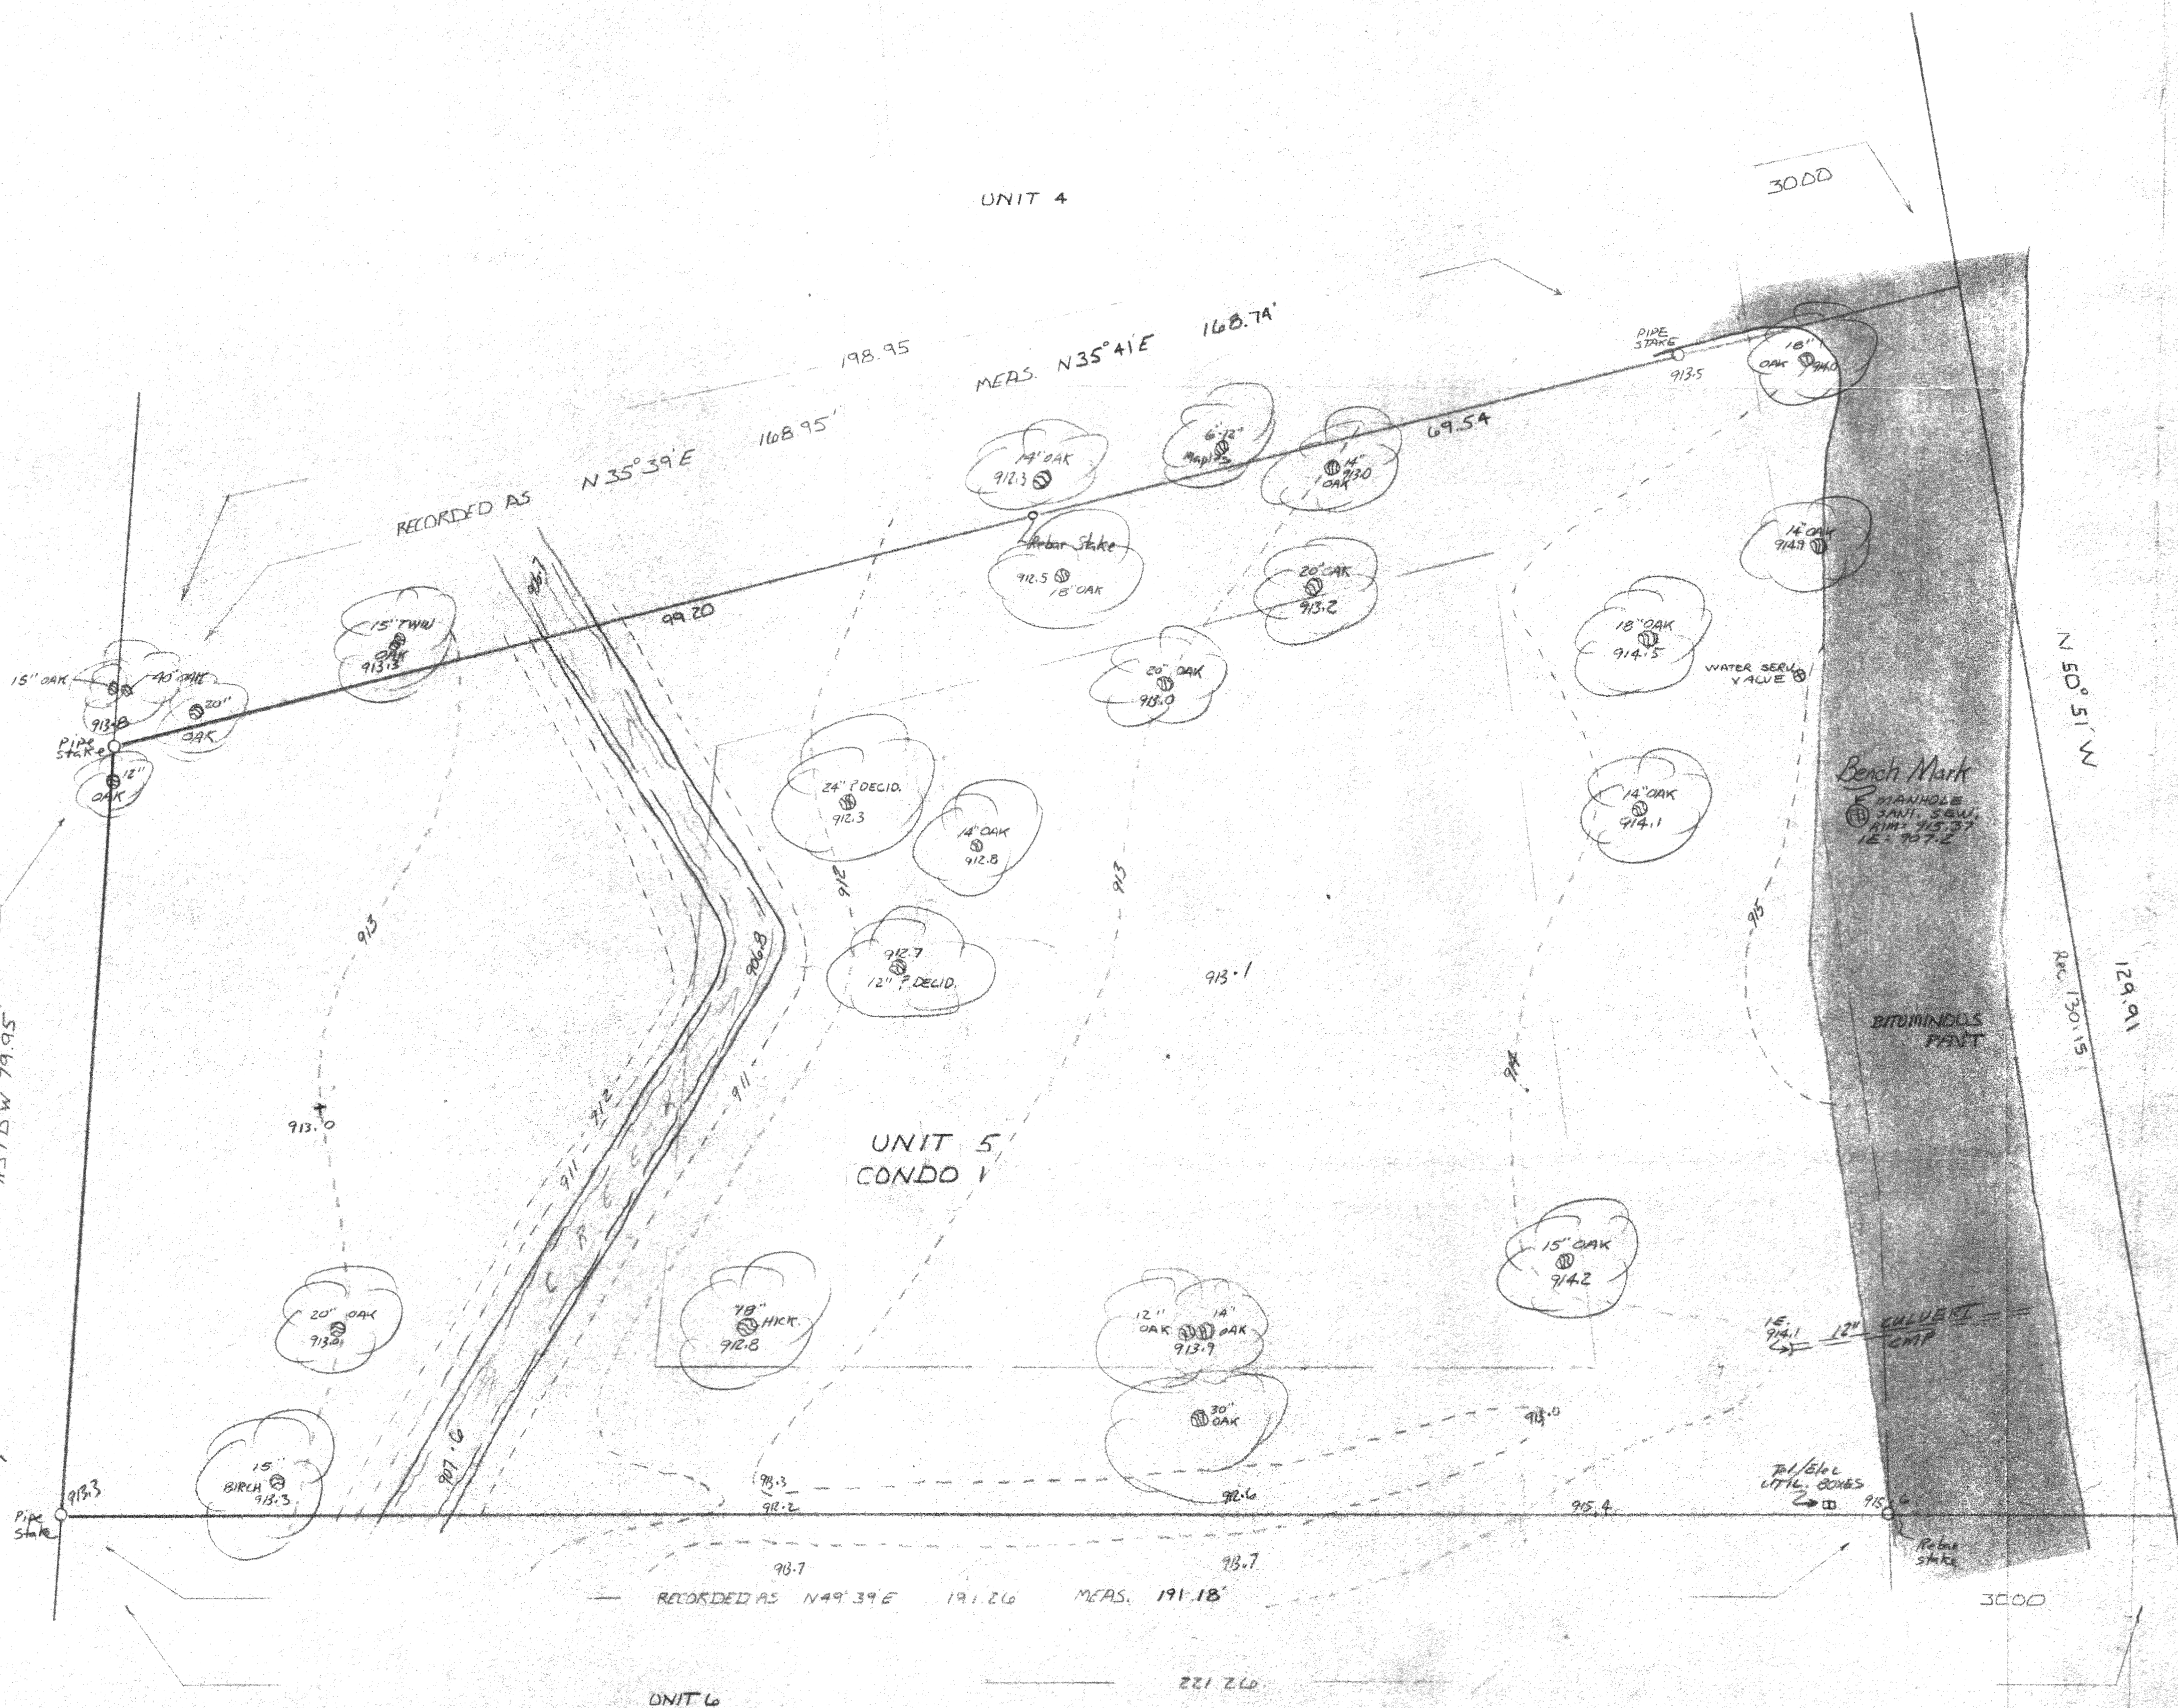

NOTE: TREE SIZES ESTIMATED NOT MEASURED
NOTE: ELEVATIONS RELATIVE TO AS BUILT
SEWER PLAN

I hereby certify this PLAT OF SURVEY to be a true
and accurate representation of the Unit boundary line
and other physical features shown herein to the
best of my professional knowledge and belief.

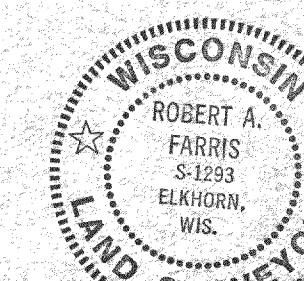

Robert A. Farris
12/05/88

UNIT 5 of ABBEY SPRINGS
LOCATED IN VILLAGE OF FOUNTAIN, WI.
BOUNDARY SURVEY & TOPOGRAPHIC MAP

DATE	DRAWN BY	REVISIONS	BY	DATE	PROJECT NO.
12/05/88					3135
SCALE	CHECKED BY				LAST REVISION
1"=10'					
	APPROVED BY				SHEET NO.
					1 of 1