


DUNHAM SURVEYING, S.C.
SURVEYING & SUBDIVIDING
DELAVER, WISCONSIN 53115

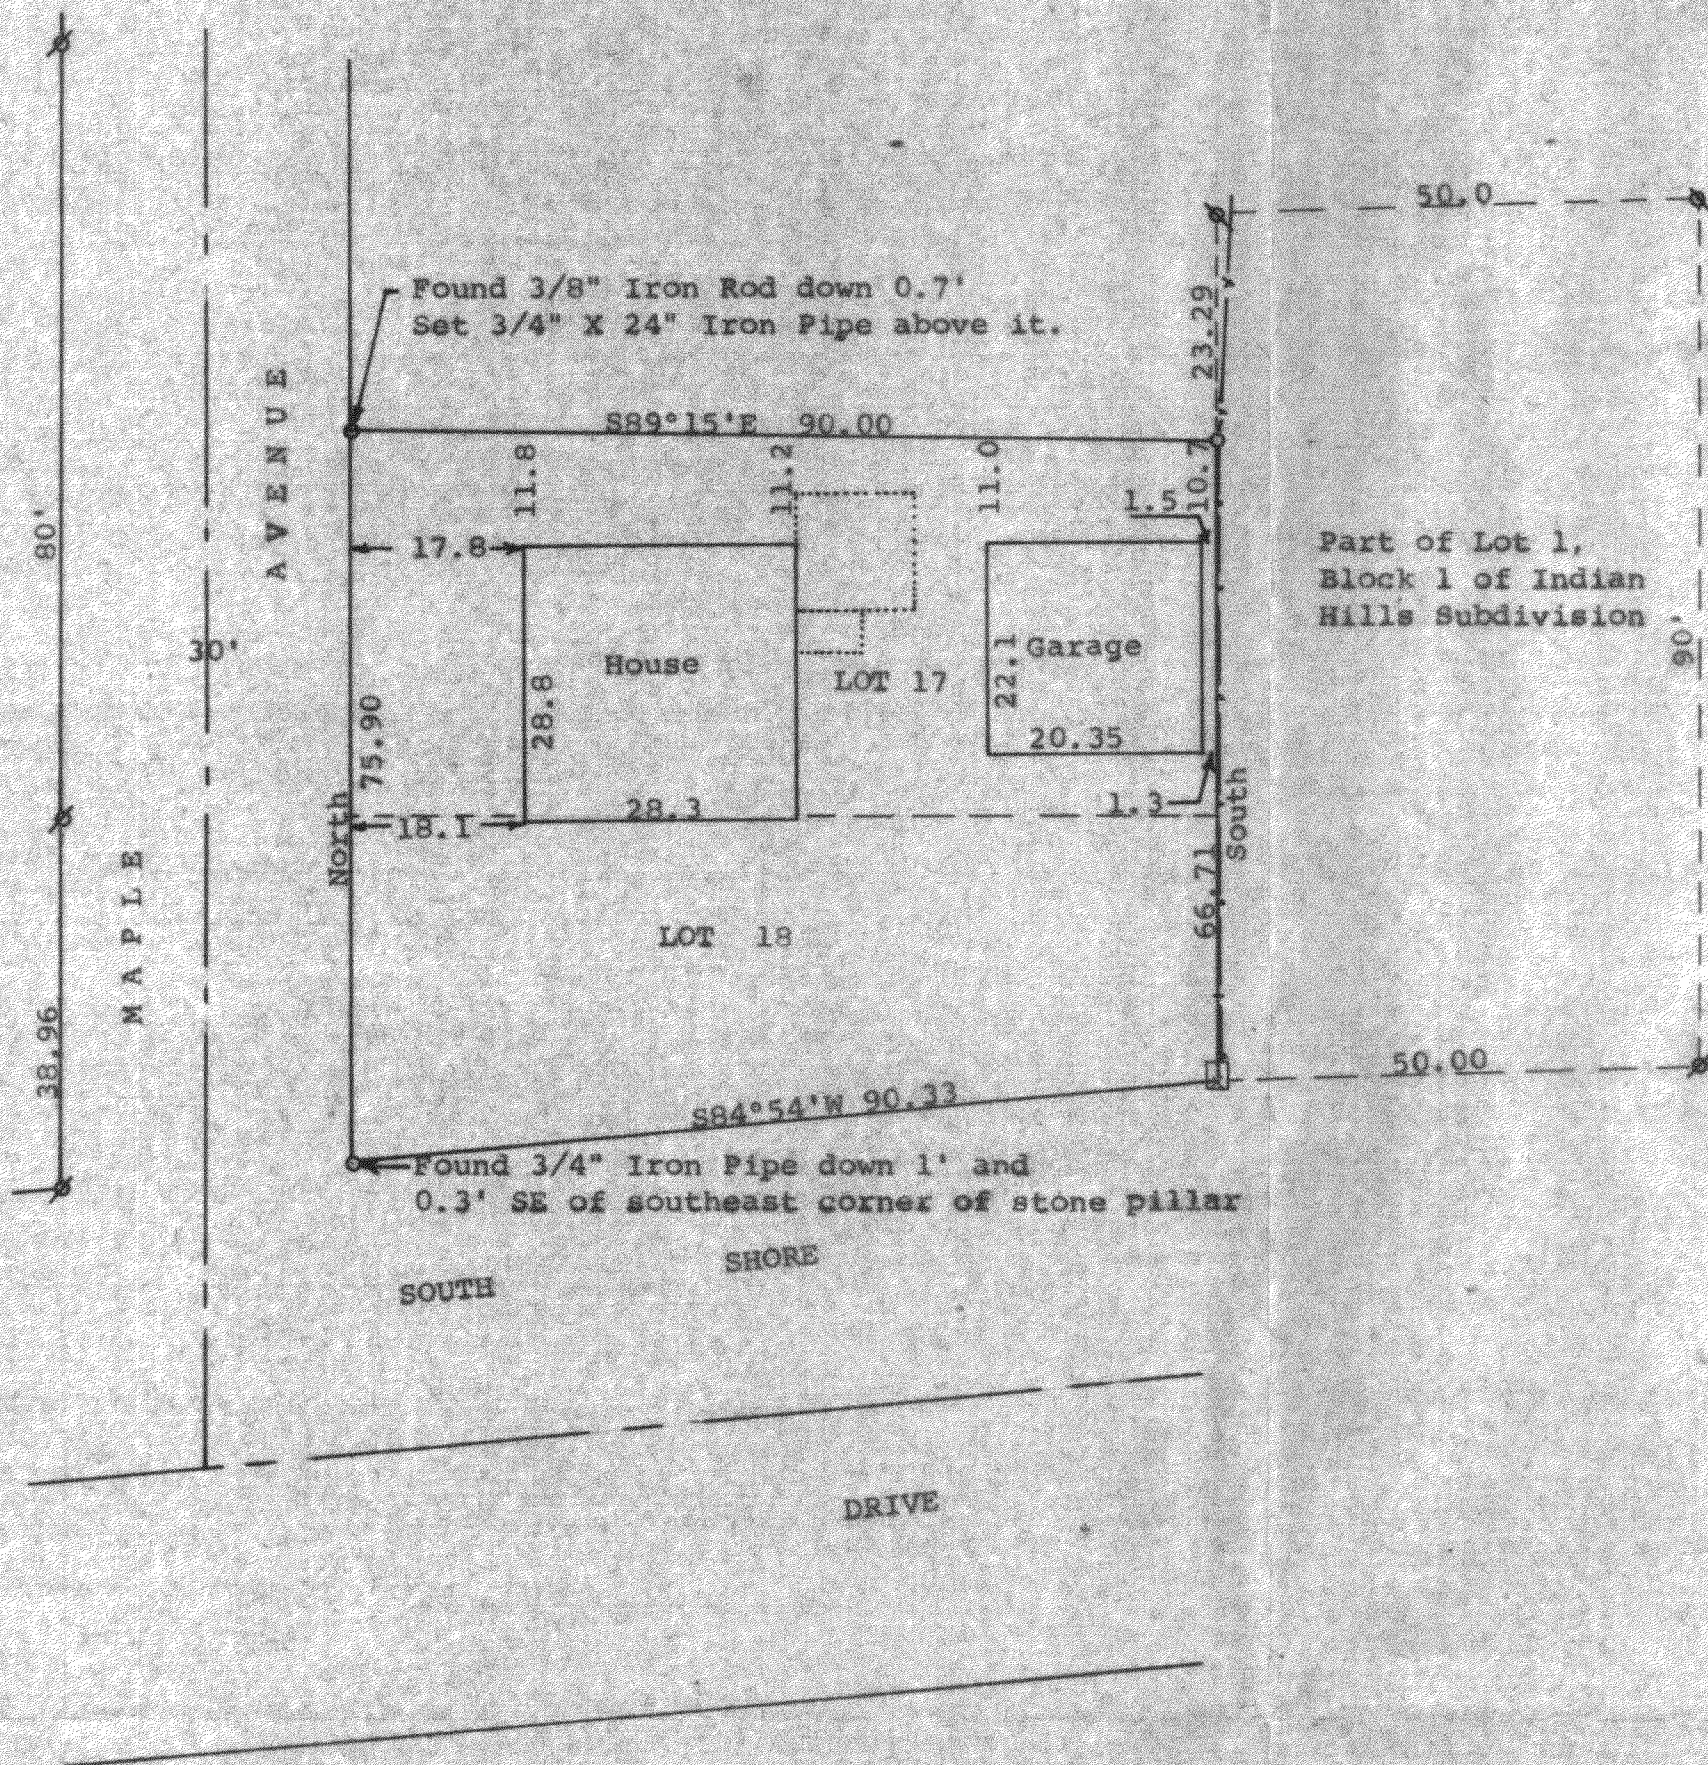

Scale - 1" = 20'

• = 1" Iron Pipe Found

• = 3/4" Iron Pipe Found


o = 3/4" X 24" Iron Pipe Set

☐ = Cross cut in concrete on top of
brick pillar

— = Fence Line

Owner: Sybil A Klug

Bearings referenced to the east line of
Maple Avenue with the assumed bearing of
North

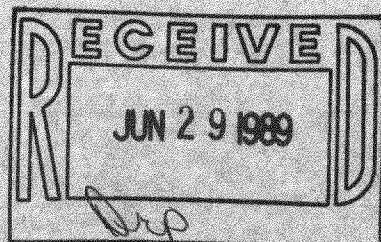

STATE OF WISCONSIN) SS
COUNTY OF WALWORTH)

I, George T. Dunham, Surveyor, certify that I have surveyed the
property described as follows:

Lots 17 and 18 in Block 1 of Glenwood Springs, a subdivision
located in the Village of Fontana, Walworth County, Wisconsin,
EXCEPTING 5 feet off the east side of each lot

and that the plat shown hereon is a correct representation thereof and shows
the size and location of the property, its exterior boundaries, the location
of all visible structures and dimensions of all principal buildings thereon,
boundary fences, apparent easements, roadways and visible encroachments, if
any, and that I have surveyed the property hereon described, according to the
official records, to the best of my knowledge and belief.

January 23, 1989

George T. Dunham
George T. Dunham, Surveyor

