





 

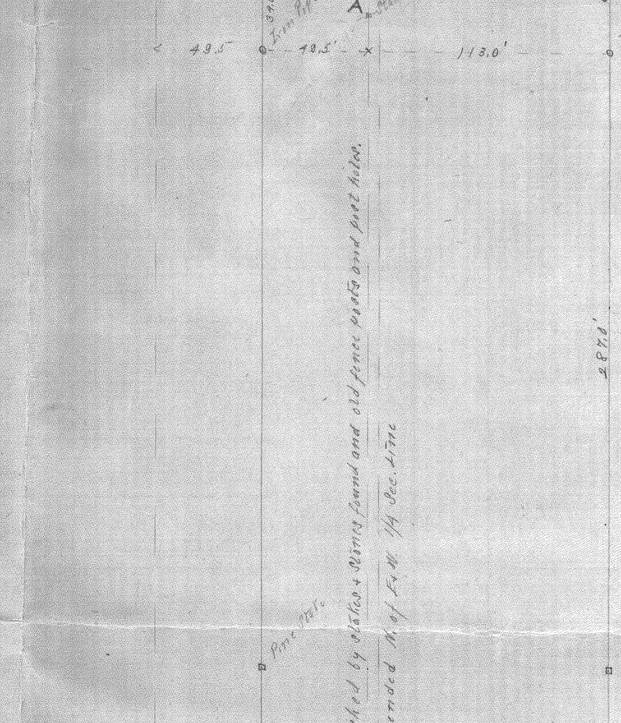

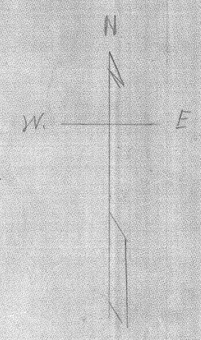

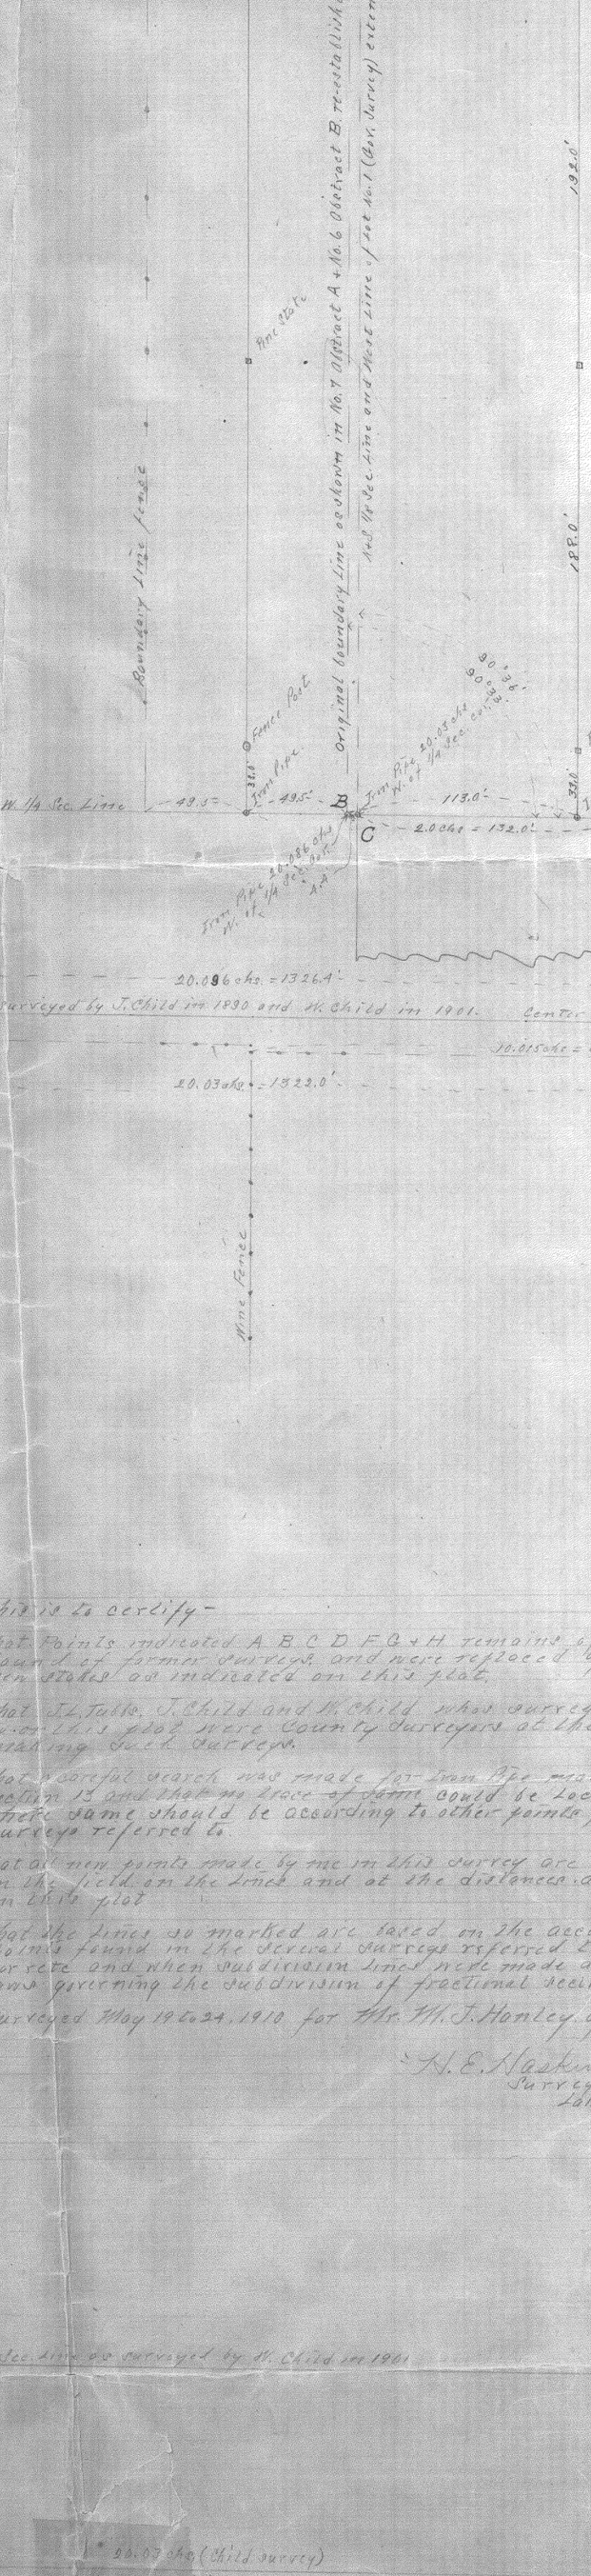


Boundary Line
Iron Stake
Iron Pipe
Iron Pipe
Iron Pipe