HAROLD H. KOLB

REGISTERED PROFESSIONAL LAND SURVEYOR

LAKE GENEVA, WISCONSIN

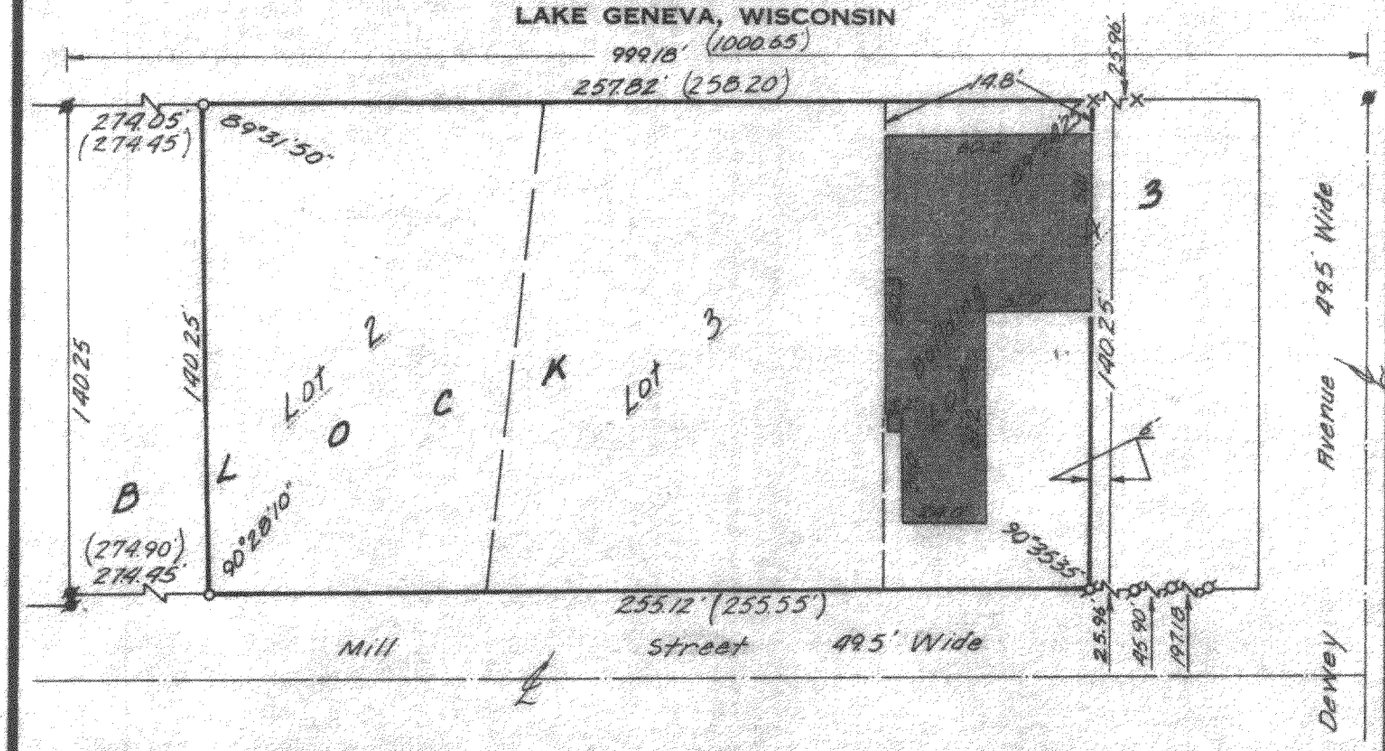

PLAT OF SURVEY OF

Lot 2, Lot 3 and the North 60.00 feet of Lot 4, Block 3, Assessor's Plat Number 1, C. I. Douglas Addition to the Village of Fontana-on-Geneva Lake, Walworth County, Wisconsin.

OWNER: Mrs. Beatrice Hutchinson

ACCURACY: Distances ± 0.01'
Angles ± 05"
Error of closure less than 1/3000.

N

Scale: 1" = 50'

LEGEND

- ϕ — IRON PIPE FOUND
- O — IRON PIPE PLACED
- ● — CONCRETE MONUMENT
- x — SPIKE

WISCONSIN HAROLD H. KOLB S-187 LAKE GENEVA, WIS. LAND SURVEYOR

I, HAROLD H. KOLB, DO HEREBY CERTIFY THAT I HAVE SURVEYED THE PROPERTY HEREON DESCRIBED ACCORDING TO THE OFFICIAL RECORDS, AND THAT THE PLAT HEREON IS A CORRECT REPRESENTATION OF THE LOT LINES.

Harold H. Kolb

HAROLD H. KOLB
WISCONSIN REGISTERED LAND SURVEYOR, S-187
DATE Nov. 22, 1974

STFV-196, 197

5-383

BRUNING 40-105 1M-6-71