HAROLD H. KOLB

REGISTERED PROFESSIONAL LAND SURVEYOR
LAKE GENEVA, WISCONSIN

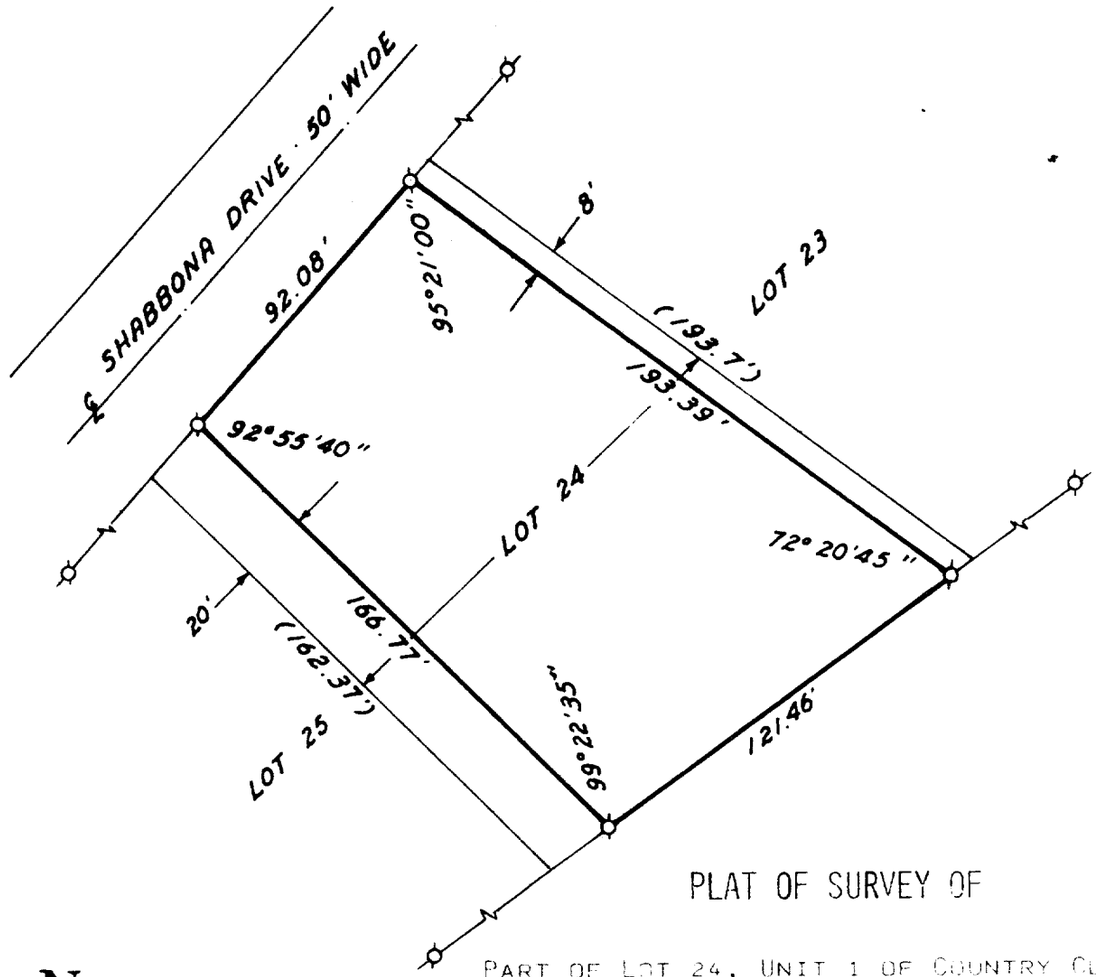

PLAT OF SURVEY OF

PART OF LOT 24, UNIT 1 OF COUNTRY CLUB ESTATES, VILLAGE OF FONTANA-ON-GENEVA LAKE, WALWORTH COUNTY, WISCONSIN.

ORDERED BY: HOTTON REALTY

ACCURACY: DISTANCES: ± 0.01'
ANGLES: ± 05"
ERROR OF CLOUSRE: LESS THAN ONE PART IN 3,000

N

SCALE: 1"=50'

LEGEND

- ϕ — IRON PIPE FOUND
- O — IRON PIPE PLACED
- ● — CONCRETE MONUMENT
- x — SPIKE
- ()- Platted As

WISCONSIN
EUGENE A. BLOMQUIST
S-1279
ELKHORN
WISC
LAND SURVEYOR

I, EUGENE A. BLOMQUIST, DO HEREBY CERTIFY THAT I HAVE SURVEYED THE PROPERTY HEREON DESCRIBED ACCORDING TO THE OFFICIAL RECORDS, AND THAT THE PLAT HEREON IS A CORRECT REPRESENTATION OF THE LOT LINES.

EUGENE A. BLOMQUIST
WISCONSIN REGISTERED LAND SURVEYOR, S-1279
DATE Apr. 23 1976

SC01-23

5-437

BRUNING 40-105 1M-6-71